


ELECTRONIC MEDIA DISCLAIMER: THIS ELECTRONIC MEDIA PROVIDED BY HDR ENGINEERING, INC. IS SUBJECT TO AN ELECTRONIC MEDIA RELEASE. ALL USE AND RE-USE OF THIS MEDIA IS SUBJECT TO THE TERMS AND CONDITIONS OF THE RELEASE.

CONTRACT DRAWINGS FOR:

WASTE WATER TREATMENT PLANT IMPROVEMENTS

WENATCHEE PROJECT: 0913 - WWTP ODOR CONTROL,
VISUAL MITIGATION AND SCREENING IMPROVEMENT

WENATCHEE, WASHINGTON
APRIL 2014

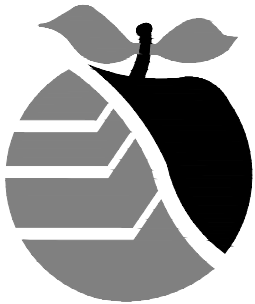

*City of
Wenatchee*

RECORD DRAWINGS

INDEX OF DRAWINGS:

GENERAL SHEETS (SERIES 000):

| | | |
|----|---------|--------------------------------------|
| 1 | 000G-01 | COVER SHEET AND DRAWING INDEX |
| 2 | 000G-02 | REGIONAL, VICINITY AND LOCATION MAPS |
| 3 | 000G-03 | DESIGN CRITERIA |
| 4 | 000G-04 | HYDRAULIC PROFILE |
| 5 | 000G-05 | GENERAL ABBREVIATIONS |
| 6 | 000G-06 | GENERAL LEGEND |
| 7 | 000G-07 | INSTRUMENTATION LEGEND |
| 8 | 000G-08 | CIVIL LEGEND |
| 9 | 000G-09 | MECHANICAL LEGEND |
| 10 | 000G-10 | ELECTRICAL LEGEND |

INSTRUMENTATION SHEETS (SERIES 000):

| | | |
|----|---------|---|
| 11 | 000Y-01 | SCREENINGS BUILDING INFLUENT SCREENS |
| 12 | 000Y-02 | SCREENINGS BUILDING WASHER/COMPACTOR |
| 13 | 000Y-03 | SOLIDS HANDLING FACILITY FOUL AIR COLLECTION |
| 14 | 000Y-04 | SCREENINGS BUILDING FOUL AIR COLLECTION |
| 15 | 000Y-05 | BIOFILTER FAN BUILDING FOUL AIR COLLECTION |
| 16 | 000Y-06 | PRIMARY CLARIFIERS & WET WELL FOUL AIR COLLECTION |
| 17 | 000Y-07 | BIOFILTER FOUL AIR COLLECTION |
| 18 | 000Y-08 | CONTROL PANEL ELEVATION |

SITE CIVIL SHEETS (SERIES 000):

| | | |
|----|---------|--|
| 19 | 000C-01 | NORTHEAST SECTION SITE PLAN |
| 20 | 000C-02 | SOUTHEAST SECTION SITE PLAN |
| 21 | 000C-03 | WEST SECTION SITE PLAN |
| 22 | 000C-04 | OVERALL CIVIL PROPOSED SITE PLAN AND STAGING AND DEMO PLAN |
| 23 | 000C-05 | OVERALL FOUL AIR DUCTWORK AND PROPOSED UTILITIES PLAN |
| 24 | 000C-06 | OVERALL FOUL AIR DUCTWORK PROFILE AND OBLIQUES 1 |
| 25 | 000C-07 | OVERALL FOUL AIR DUCTWORK PROFILE AND OBLIQUES 2 |
| 26 | 000C-08 | CIVIL SITE DETAILS |

SITE LANDSCAPE SHEETS (SERIES 000):

| | | |
|----|---------|------------------------------------|
| 27 | 000L-01 | NORTH LANDSCAPE PLAN |
| 28 | 000L-02 | SOUTH LANDSCAPE PLAN |
| 29 | 000L-03 | EQUALIZATION BASIN LANDSCAPE PLAN |
| 30 | 000L-04 | NORTH IRRIGATION PLAN |
| 31 | 000L-05 | SOUTH IRRIGATION PLAN |
| 32 | 000L-06 | EQUALIZATION BASIN IRRIGATION PLAN |
| 33 | 000L-07 | PLANTING DETAILS |
| 34 | 000L-08 | LANDSCAPE DETAILS |
| 35 | 000L-09 | IRRIGATION DETAILS |

SITE STRUCTURAL SHEETS (SERIES 000):

| | | |
|----|---------|---------------------|
| 36 | 000S-01 | STRUCTURAL NOTES |
| 37 | 000S-02 | SITE DETAILS I |
| 38 | 000S-03 | SITE DETAILS II |
| 39 | 000S-04 | STANDARD DETAILS I |
| 40 | 000S-05 | STANDARD DETAILS II |

SITE ARCHITECTURAL SHEETS (SERIES 000):

| | | |
|----|---------|-----------------------------------|
| 41 | 000A-01 | SITE PLAN - NORTH |
| 42 | 000A-02 | SITE PLAN - SOUTH |
| 43 | 000A-03 | ENLARGED PLANS |
| 44 | 000A-04 | ENLARGED VIEW PLATFORM PLANS |
| 45 | 000A-05 | VIEW AREA RAMP PLAN & CANOPY PLAN |
| 46 | 000A-06 | SIGNAGE PLAN & ELEVATIONS |
| 47 | 000A-07 | EXISTING BUILDING MODIFICATIONS 1 |
| 48 | 000A-08 | EXISTING BUILDING MODIFICATIONS 2 |
| 49 | 000A-09 | EXISTING BUILDING MODIFICATIONS 3 |
| 50 | 000A-10 | EXISTING BUILDING MODIFICATIONS 4 |
| 51 | 000A-11 | EXISTING BUILDING MODIFICATIONS 5 |
| 52 | 000A-12 | EXISTING BUILDING MODIFICATIONS 6 |
| 53 | 000A-21 | VIEW AREA ELEVATIONS 1 |
| 54 | 000A-22 | VIEW AREA ELEVATIONS 2 |
| 55 | 000A-23 | RAMP SECTIONS & GATE ELEVATIONS |
| 56 | 000A-31 | VIEWING AREA SECTIONS |
| 57 | 000A-51 | DETAILS 1 |
| 58 | 000A-52 | DETAILS 2 |
| 59 | 000A-61 | FENCING TYPES |

SITE ELECTRICAL SHEETS (SERIES 000):

| | | |
|----|---------|---|
| 60 | 000E-01 | ELECTRICAL SITE PLAN |
| 61 | 000E-02 | EXISTING ELECTRICAL DISTRIBUTION SYSTEM MODIFICATIONS |
| 62 | 000E-03 | EXISTING MCC ONE LINE DIAGRAMS MODIFICATIONS |
| 63 | 000E-04 | SCREENINGS BUILDING ELECTRICAL ONE LINE DIAGRAM |
| 64 | 000E-05 | SCREENINGS BUILDING ELECTRICAL MCC ELEVATION |
| 65 | 000E-06 | ELECTRICAL CONTROL PANEL BLOCK DIAGRAMS |
| 66 | 000E-07 | CONDUIT & CABLE SCHEDULE |
| 67 | 000E-08 | PANELBOARD SCHEDULES |
| 68 | 000E-09 | CONTROL DIAGRAMS |
| 69 | 000E-10 | DETAILS 1 |
| 70 | 000E-11 | DETAILS 2 |
| 71 | 000E-12 | SITE LIGHTING BLOCK DIAGRAM |

SITE ELECTRICAL SHEETS (SERIES 000 CONTINUED):

| | | |
|--|---------|--|
| 72 | 000E-13 | OVERALL ARCHITECTURAL SITE LIGHTING |
| 73 | 000E-14 | LIGHTING FIXTURE SCHEDULE |
| PRE-AERATION STRUCTURE/SCREENINGS BUILDING SHEETS (SERIES 120): | | |
| 74 | 120X-01 | PRE-AERATION STRUCTURE EXTERIOR DEMOLITION |
| 75 | 120X-02 | PRE-AERATION STRUCTURE INTERIOR DEMOLITION |
| 76 | 120S-01 | SCREENINGS BASIN MODIFICATIONS |
| 77 | 120S-02 | FOUNDATION AND FLOOR PLAN |
| 78 | 120S-03 | ROOF PLAN AND DETAILS |
| 79 | 120S-04 | SECTIONS |
| 80 | 120S-05 | SECTIONS AND DETAILS |
| 81 | 120A-00 | CODE REVIEW PLANS |
| 82 | 120A-01 | FLOOR PLAN & ROOF PLAN |
| 83 | 120A-21 | DOOR, LOUVER AND WINDOW TYPES & SCHEDULES |
| 84 | 120A-22 | BUILDING ELEVATIONS |
| 85 | 120A-41 | WALL SECTIONS |
| 86 | 120A-51 | DETAILS 1 |
| 87 | 120A-52 | DETAILS 2 |
| 88 | 120D-01 | SCREENINGS ROOM PROCESS PLAN |
| 89 | 120D-02 | SCREENINGS CHANNEL VAULT PROCESS PLAN |
| 90 | 120D-03 | PROCESS SECTIONS |
| 91 | 120D-04 | SCREENINGS ROOM SECTION AND DETAILS |
| 92 | 120D-05 | FOUL AIR DUCTING LOWER LEVEL PLANL |
| 93 | 120D-06 | FOUL AIR DDUCTION SECTION AND DETAIL |
| 94 | 120M-01 | HVAC FLOOR AND ROOF PLAN |
| 95 | 120M-02 | HVAC SECTIONS |
| 96 | 120M-03 | HVAC SCHEDULES & SEQUENCE OF OPERATION |
| 97 | 120E-01 | POWER AND CONTROL PLAN |
| 98 | 120E-02 | LIGHTING PLAN |

INFLUENT PUMP STATION WET WELL SHEETS (SERIES 210):

| | | |
|-----|---------|---------------------|
| 99 | 210D-01 | PLANS AND DETAILS |
| 100 | 210D-02 | SECTION AND DETAILS |

ADMINISTRATION BUILDING SHEETS (SERIES 220):

| | | |
|-----|---------|-------------------------|
| 101 | 220A-01 | CANOPY PLAN & ELEVATION |
|-----|---------|-------------------------|

EXISTING HEADWORKS/FAN BUILDING SHEETS (SERIES 310):

| | | |
|-----|---------|-----------------------|
| 102 | 310X-01 | DEMOLITION SHEET |
| 103 | 310M-01 | LOWER AND UPPER PLANS |
| 104 | 310M-02 | SECTIONS 1 |
| 105 | 310M-03 | SECTIONS 2 |

EXISTING HEADWORKS SHEETS (SERIES 310 CONTINUED):

| | | |
|-----|----------|------------------------------------|
| 106 | 310M-04 | SLUDGE PUMP ROOM PLAN AND SECTION |
| 107 | 310EX-01 | POWER AND CONTROL DEMOLITION PLAN |
| 108 | 310E-01 | UPPER LEVEL POWER AND CONTROL PLAN |

PRIMARY CLARIFIER NO.1 SHEETS (SERIES 410):

| | | |
|-----|---------|----------------------------------|
| 109 | 410X-01 | DEMOLITION PLAN |
| 110 | 410S-01 | SECTIONS AND DETAILS |
| 111 | 410D-01 | COVER PLAN |
| 112 | 410D-02 | PROCESS PLAN |
| 113 | 410D-03 | SECTION |
| 114 | 410D-04 | DETAILS |
| 115 | 410E-01 | POWER, LIGHTING AND CONTROL PLAN |

PRIMARY CLARIFIER NO.2 SHEETS (SERIES 420):

| | | |
|-----|---------|----------------------------------|
| 116 | 420X-01 | DEMOLITION PLAN |
| 117 | 420D-01 | PLAN |
| 118 | 420D-02 | PIPING PLAN |
| 119 | 420E-01 | POWER, LIGHTING AND CONTROL PLAN |

SOLIDS HANDLING BUILDING SHEETS (SERIES 510):

| | | |
|-----|---------|----------------------------|
| 120 | 510M-01 | UPPER FLOOR PLAN |
| 121 | 510M-02 | UPPER FLOOR SECTIONS I |
| 122 | 510M-03 | UPPER FLOOR SECTIONS II |
| 123 | 510M-04 | LOAD-OUT PLAN AND SECTIONS |
| 124 | 510E-01 | POWER AND CONTROL PLAN |

AERATION BASINS SHEETS (SERIES 610):

| | | |
|-----|---------|----------------------------|
| 125 | 610A-01 | CANOPY PLAN |
| 126 | 610A-21 | CANOPY ELEVATION / SECTION |

SECONDARY CLARIFIER SHEETS (SERIES 700):

| | | |
|-----|---------|---------------------------------|
| 127 | 700D-01 | NON-POTABLE WATER PUMPS DETAILS |
|-----|---------|---------------------------------|

BIOFILTER SHEETS (SERIES 910):

| | | |
|-----|---------|---------------------------|
| 128 | 910S-01 | FOUNDATION PLAN |
| 129 | 910S-02 | SECTIONS AND DETAILS |
| 130 | 910A-01 | BIOFILTER PATTERN PLAN |
| 131 | 910A-21 | PERIMETER WALL ELEVATIONS |
| 132 | 910A-51 | DETAILS |
| 133 | 910M-01 | PIPING PLAN |
| 134 | 910M-02 | SECTIONS AND DETAILS |



| | | |
|-------|----------|----------------------------------|
| | | |
| | | |
| 1 | APR 2014 | RECORD DRAWINGS |
| 0 | NOV 2011 | ISSUE FOR CONSTRUCTION SUBMITTAL |
| ISSUE | DATE | DESCRIPTION |


| | |
|-----------------|-------------|
| PROJECT MANAGER | A. MEILLEUR |
| DESIGNED | B. DUDZIK |
| DRAWN | B. LILLY |
| CHECKED | J. KOCH |
| PROJECT NUMBER | 171097 |

ELECTRONIC SEAL AND
SIGNATURE HAS BEEN
REMOVED. THIS MEDIA
SHOULD NOT BE CONSIDERED
A CERTIFIED DOCUMENT



*City of
Wenatchee*

WASTE WATER TREATMENT
PLANT IMPROVEMENTS

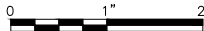

GENERAL
COVER SHEET
AND DRAWING INDEX

| | |
|----------|--------------|
| FILENAME | 000G-01.dwg |
| SCALE | NOT TO SCALE |

| |
|----------------|
| SHEET |
| 000G-01 |

ELECTRONIC MEDIA DISCLAIMER: THIS ELECTRONIC MEDIA PROVIDED BY HDR ENGINEERING, INC. IS SUBJECT TO AN ELECTRONIC MEDIA RELEASE. ALL USE AND RE-USE OF THIS MEDIA IS SUBJECT TO THE TERMS AND CONDITIONS OF THE RELEASE.

| DESIGN WASTELOADS | |
|---|--|
| FLOW (MGD) | |
| AVERAGE ANNUAL | 5.0 |
| MAXIMUM MONTH | 5.5 |
| MAXIMUM WEEK | 5.8 |
| MAXIMUM DAY | 7.1 |
| PEAK (1) | 11.0 |
| (1) PEAK FLOW PUMPED TO HEADWORKS. FLOW EXCEEDING 11 MGD ARE PUMPED TO FLOW EQUALIZATION BASIN. | |
| INFLUENT | |
| BOD (LBS/DAY) | |
| AVERAGE ANNUAL | 11,900 |
| MAXIMUM MONTH | 13,000 |
| MAXIMUM WEEK | 14,300 |
| MAXIMUM DAY | 20,500 |
| TSS (LBS/DAY) | |
| AVERAGE ANNUAL | 11,800 |
| MAXIMUM MONTH | 13,100 |
| MAXIMUM WEEK | 15,400 |
| MAXIMUM DAY | 19,700 |
| TKN (LBS/DAY) | |
| AVERAGE ANNUAL | 1,200 |
| MAXIMUM MONTH | 1,800 |
| MAXIMUM WEEK | 2,000 |
| MAXIMUM DAY | 2,600 |
| PRIMARY EFFLUENT | |
| BOD (LBS/DAY) | |
| AVERAGE ANNUAL | 7,120 |
| MAXIMUM MONTH | 7,959 |
| MAXIMUM WEEK | 9,440 |
| MAXIMUM DAY | 14,550 |
| TSS (LBS/DAY) | |
| AVERAGE ANNUAL | 4,100 |
| MAXIMUM MONTH | 5,210 |
| MAXIMUM WEEK | 5,510 |
| MAXIMUM DAY | 7,320 |
| TKN (LBS/DAY) | |
| AVERAGE ANNUAL | |
| MAXIMUM MONTH | |
| MAXIMUM WEEK | |
| MAXIMUM DAY | |
| FLOW EQUALIZATION BASIN | |
| NUMBER OF UNITS | 1 |
| VOLUME | 1.7 MILLION GALLONS BELOW EL 639.0 (NAVD 88) |
| FLOW EQUALIZATION EFFLUENT PUMP | |
| TYPE | SUBMERSIBLE |
| CAPACITY | 700 GPM @ 31 FT TDH |
| HORSEPOWER | 10 |
| PRIMARY CLARIFIERS | |
| NUMBER OF UNITS | 2 |
| DIAMETER | 1-65 FT, 1-80 FT |
| OVERFLOW RATE (GAL/FT2/DAY) | |
| AVERAGE | 600 |
| PEAK | 1,320 |

| AERATION BASINS | |
|---|----------------------------|
| NUMBER OF UNITS | 2 |
| VOLUME, EACH (MG) | |
| ZONE A | 0.065 |
| ZONE B | 0.108 |
| ZONE C | 0.216 |
| ZONE D | 0.151 |
| TOTAL | 0.54 |
| WASTEWATER TEMPERATURE (C) | |
| SUMMER | 20 |
| WINTER | 15 |
| SOLIDS RETENTION TIME (DAYS) | |
| SUMMER | 4.5 |
| WINTER | 6.5 |
| MLSS | |
| SUMMER | |
| PLUG FLOW | 3,300 |
| STEP FEED | 2,400 |
| WINTER | |
| PLUG FLOW (2) | 3,700 |
| STEP FEED | 3,300 |
| ACTUAL OXYGEN REQUIREMENTS (AOR) (SUM OF TWO BASINS) (LBS/DAY) (4) | |
| SUMMER | |
| PLUG FLOW (3) | N/A |
| STEP FEED | 2,200 |
| WINTER | |
| PLUG FLOW (2),(3) | N/A |
| STEP FEED | 2,400 |
| ALPHA | 0.7 |
| AIR REQUIREMENTS (SUM OF TWO BASINS) (SCFM) (4) | |
| SUMMER | |
| PLUG FLOW (3) | N/A |
| STEP FEED | 1,800 |
| WINTER | |
| PLUG FLOW (2),(3) | N/A |
| STEP FEED | 1,900 |
| DIFFUSERS | |
| TYPE OF BUBBLE | COARSE |
| NUMBER, TOTAL | 200 |
| SCFM/DIFFUSER (4) | 10 |
| (2) CAPACITY FOR 4.5 MGD AT MAXIMUM MONTH INFLUENT BOD AND TSS CONCENTRATION. | |
| (3) ANOXIC CONDITIONS IN ZONE A. | |
| (4) AVERAGE AT MAXIMUM MONTH INFLUENT WASTELOAD. | |
| AERATION BLOWERS | |
| TYPE | MULTIPLE STAGE CENTRIFUGAL |
| NUMBER OF UNITS | 3 |
| CAPACITY | 5,500 SCFM @ 8.8 PSIG |
| HORSEPOWER | 300 |
| CONTROL | INLET THROTTLING |

| AERATION BASINS (CONTINUED) | | |
|--|---|------|
| ANOXIC MIXERS | | |
| AERATION ZONE | A | |
| NUMBER PER AERATION ZONE | 1 | |
| HORSEPOWER | 5 | |
| MIXED LIQUOR RECIRCULATION PUMPS | | |
| NUMBER PER AERATION BASIN | 1 | |
| TYPE | SUBMERSIBLE PROPELLER | |
| CAPACITY | 3,800 GPM @ 1.8 FT TDH | |
| HORSEPOWER | 10 | |
| SECONDARY CLARIFIERS | | |
| NUMBER OF UNITS | 2 | |
| DIAMETER | 80 FT | |
| TYPE | SPIRAL RAKE | |
| OVERFLOW RATE (GAL/FT2/DAY) | | |
| AVERAGE | 550 | |
| PEAK | 1,100 | |
| SOLIDS LOADING RATE (LBS/FT2/DAY) | | |
| SUMMER | MAX. MO. | PEAK |
| PLUG FLOW | 23 | 45 |
| STEEP FEED | 16 | 33 |
| WINTER | | |
| PLUG FLOW | 25 | 51 |
| STEEP FEED | 23 | 45 |
| SVI | 150 | |
| RETURN ACTIVATED SLUDGE PUMPS | | |
| NUMBER OF UNITS | 2 | |
| TYPE | VERTICAL SEWAGE PUMPS | |
| CAPACITY, EACH (GPM) | 1,900 @ 26 FT TDH | |
| CONTROL | WEIR GATES TO EACH CLARIFIER WITH ELECTRIC ACTUATORS TO CONTROL RAS RATE. ADJUSTABLE SPEED PUMP DRIVES. | |
| UV DISENFECTION | | |
| NUMBER OF CHANNELS | 3 | |
| CAPACITY PER CHANNEL (MGD) | 5.5 | |
| TRANSMITTANCE, MINIMUM | 50% | |
| NPDES FECAL COLIFORM - 30 DAY | 200 / 100 mL | |
| UV DOSAGE, uWs/cm2 | 40,000 | |
| RAW SEWAGE PUMPS - VERTICAL DRY PIT NON-CLOG | | |
| NO. 1 & 2 | 3,150 GPM @ 47 FT TDH | |
| NO. 3 | 2,000 GPM | |
| NO. 4 | 2,500 GPM | |
| NO. 5 | 5,500 GPM | |
| NO. 6 | 6,000 GPM | |

| INFLUENT SCREENS | |
|---|------------------------------|
| NUMBER OF UNITS | 2 |
| TYPE | PERFORATED PLATE SCREEN |
| PEAK FLOW WITH 1 SCREEN IN SERVICE | 15 MGD |
| SCREENING CHANNEL DEPTH (FT) | 5 |
| SCREENING CHANNEL WIDTH (FT) | 3 |
| WATER DEPTH DOWNSTREAM OF SCREEN (FT) | |
| AVERAGE FLOW | 0.5 |
| PEAK FLOW (FT) | 2 |
| MAXIMUM HEAD LOSSES ACROSS SCREEN AT PEAK FLOW (FT) | |
| FOR CLEAN WATER | 0.8 |
| 50% BINDING FACTOR | 1.2 |
| SCREEN PANEL PERFORATION DIAMETER | 6 MM |
| SCREENINGS WASHER/ COMPACTOR | |
| NUMBER OF UNITS | 2 |
| MIN. COMPACTED SCREENINGS VOLUME | 10 (CF/DAY) |
| MIN. SCREENINGS VOLUME REDUCTION | 70% |
| MIN. REMOVAL OF ORGANIC CONSTITUENTS | 90% |
| MIN. SCREENINGS WEIGHT REDUCTION | 60% |
| MINIMUM SOLID CONCENTRATION | 50% |
| BIOFILTER | |
| DESIGN TREATMENT FLOW RATE (SCFM) | 21,000 |
| REMOVAL EFFICIENCY | |
| HYDROGEN SULFIDE | |
| CONCENTRATION > 10 PPMV | 99% REMOVAL |
| CONCENTRATION < 10 PPMV | DISCHARGE LESS THAN 100 PPBV |
| AMMONIA | |
| CONCENTRATION > 50 PPMV | 90% REMOVAL |
| CONCENTRATION < 50 PPMV | DISCHARGE LESS THAN 5 PPMV |
| LAYER THICKNESS (IN) | |
| PLENUM ZONE | 12 |
| SOIL FILTER MEDIA | 36 |
| COVER ROCK | 3 |
| FOUL AIR FANS | |
| FAN AND OPERATING POINT | |
| DEWATERING FAN | 4,605 SCFM @ 2 IN W.C. |
| TRUCK LOADOUT FAN | 6,440 SCFM @ 2.25 IN W.C. |
| SCREENINGS FAN | 2,270 SCFM @ 2 IN W.C. |
| PRIMARY AREA FAN | 1,835 SCFM @ 2 IN W.C. |
| BIOFILTER FAN (A) | 10,435 SCFM @ 9 IN W.C. |
| BIOFILTER FAN (B) | 10,435 SCFM @ 9 IN W.C. |
| NON-POTABLE WATER PUMPS | |
| NUMBER OF UNITS | 2 |
| TYPE | NON-CLOG CENTRIFUGAL |
| CAPACITY | 325 GPM @ 180 FT TDH |
| HORSEPOWER | 25 |
| NOTE: ALL GRAYED OUT INFORMATION IS CONSIDERED TO BE EXISTING OR PREVIOUSLY DEFINED. | |




| | | |
|-------|----------|----------------------------------|
| | | |
| | | |
| | | |
| | | |
| 1 | APR 2014 | RECORD DRAWINGS |
| 0 | NOV 2011 | ISSUE FOR CONSTRUCTION SUBMITTAL |
| ISSUE | DATE | DESCRIPTION |

| | |
|-----------------|-------------|
| PROJECT MANAGER | A. MEILLEUR |
| DESIGNED | B. DUDZIK |
| DRAWN | B. LILLY |
| CHECKED | J. KOCH |
| PROJECT NUMBER | 171097 |

ELECTRONIC SEAL AND SIGNATURE HAS BEEN REMOVED. THIS MEDIA SHOULD NOT BE CONSIDERED A CERTIFIED DOCUMENT




GENERAL DESIGN CRITERIA

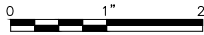

| | |
|----------|--------------|
| FILENAME | 000G-03.dwg |
| SCALE | NOT TO SCALE |

| |
|---------|
| SHEET |
| 000G-03 |

ELECTRONIC MEDIA DISCLAIMER: THIS ELECTRONIC MEDIA PROVIDED BY HDR ENGINEERING, INC. IS SUBJECT TO AN ELECTRONIC MEDIA RELEASE. ALL USE AND RE-USE OF THIS MEDIA IS SUBJECT TO THE TERMS AND CONDITIONS OF THE RELEASE.

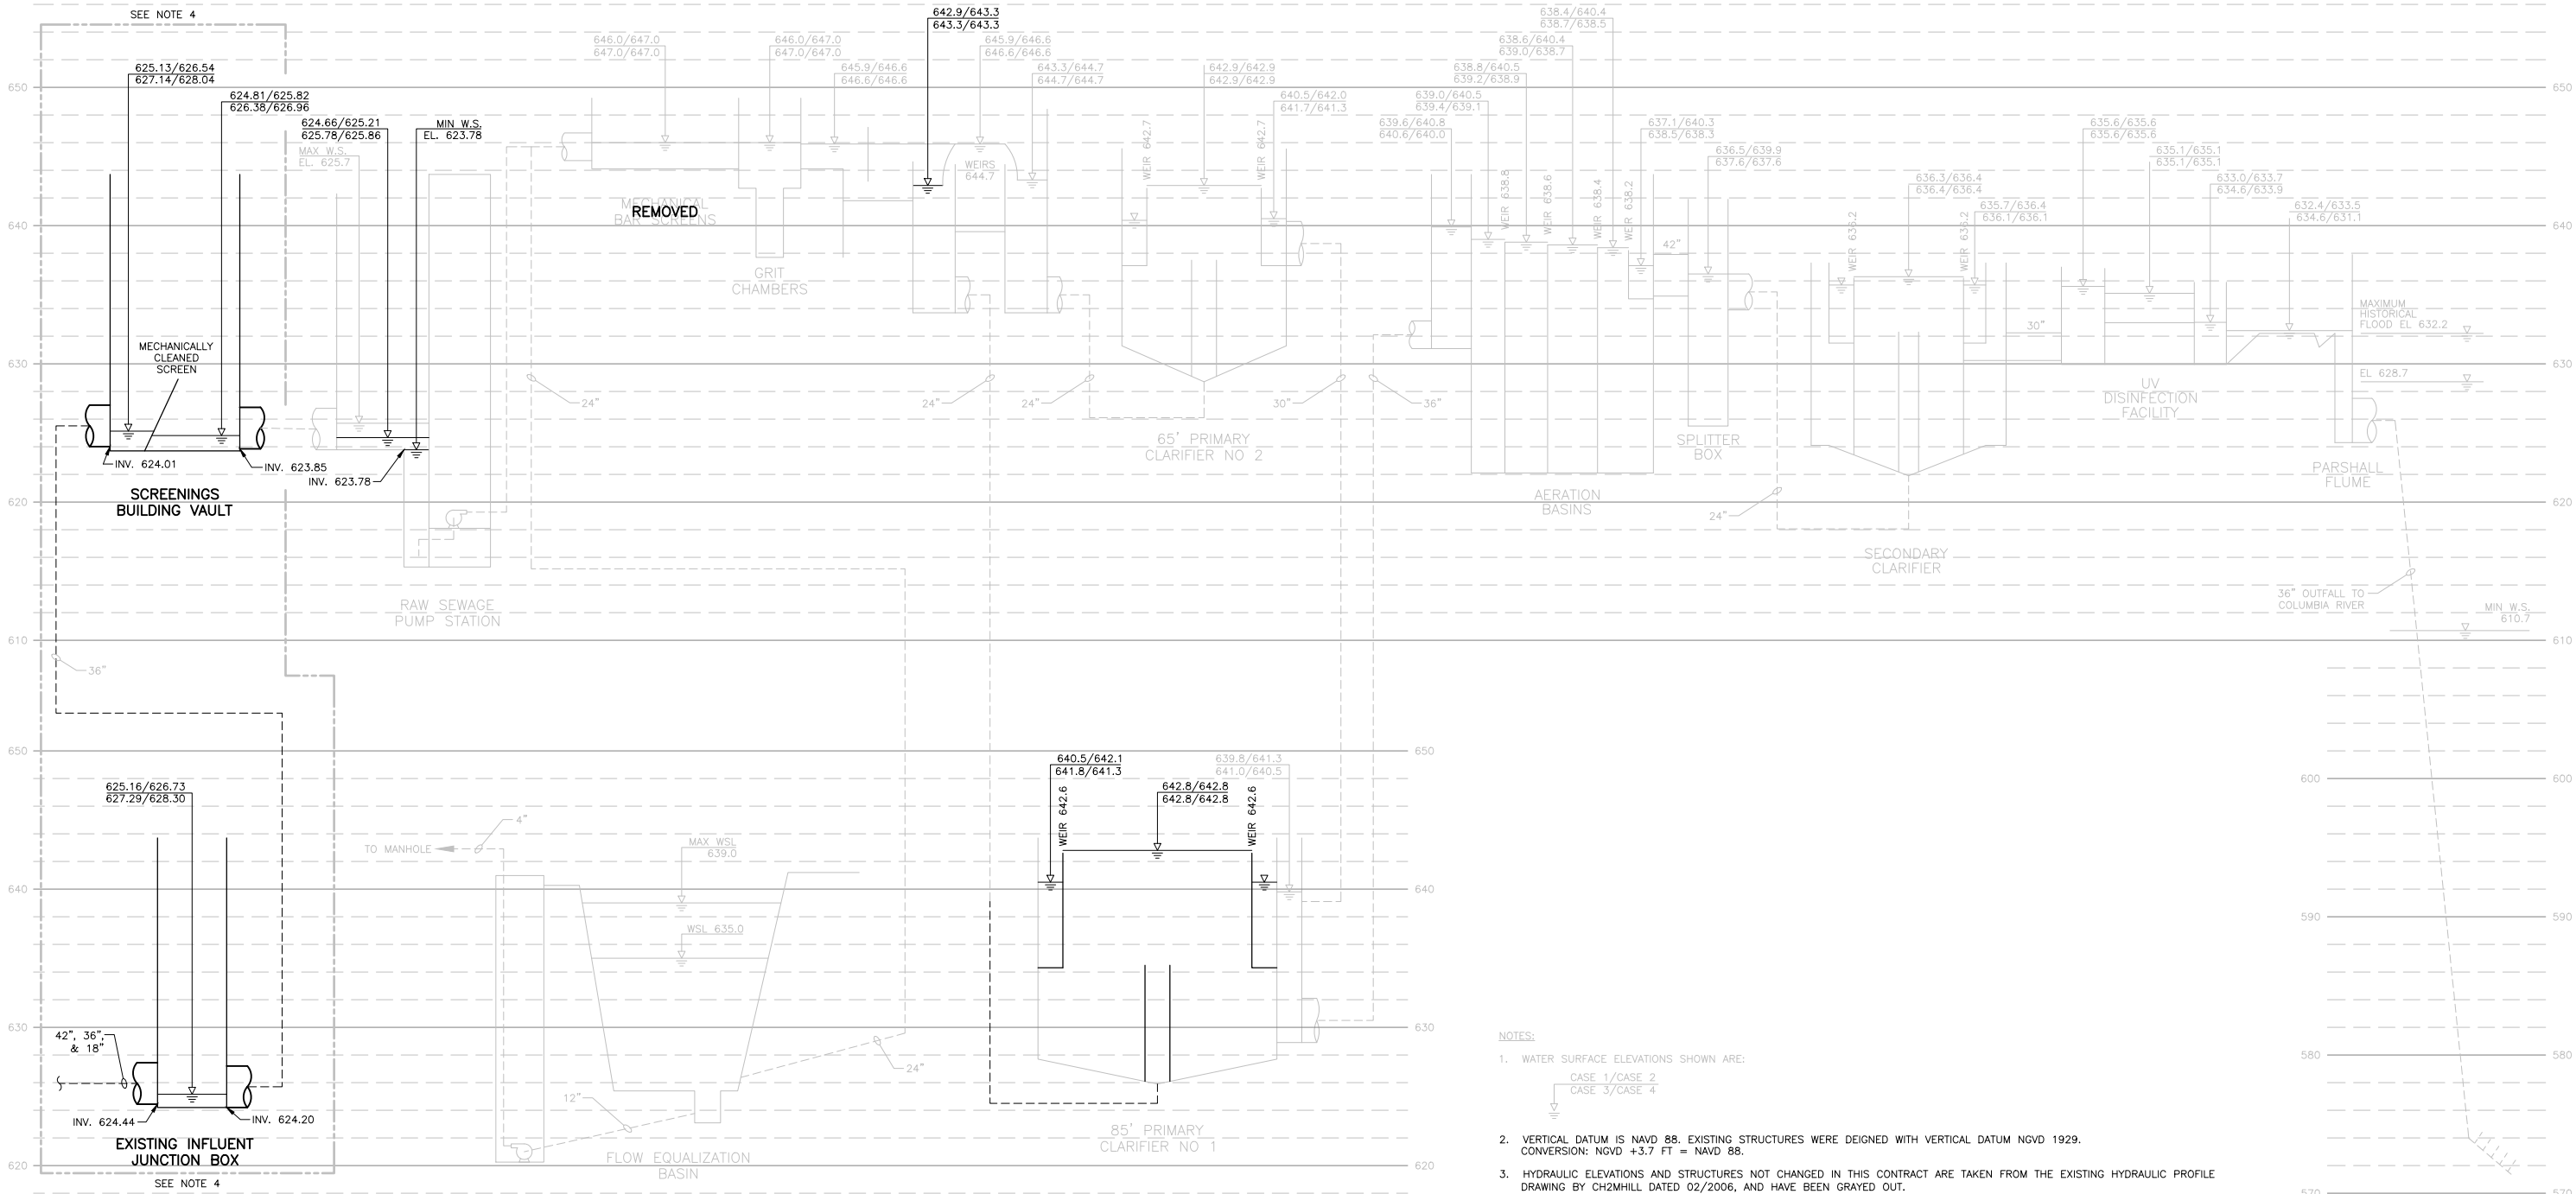

- NOTES:
1. WATER SURFACE ELEVATIONS SHOWN ARE:
CASE 1/CASE 2
CASE 3/CASE 4
 2. VERTICAL DATUM IS NAVD 88. EXISTING STRUCTURES WERE DEIGNED WITH VERTICAL DATUM NGVD 1929. CONVERSION: NGVD +3.7 FT = NAVD 88.
 3. HYDRAULIC ELEVATIONS AND STRUCTURES NOT CHANGED IN THIS CONTRACT ARE TAKEN FROM THE EXISTING HYDRAULIC PROFILE DRAWING BY CH2MHILL DATED 02/2006, AND HAVE BEEN GRAYED OUT.
 4. THE INFLUENT JUNCTION BOX AND SCREENINGS BUILDING VAULT ARE EXISTING STRUCTURES AND WERE NOT SHOWN ON THE CH2MHILL HYDRAULIC PROFILE DRAWING DATED 02/2006.

| UNITS IN SERVICE/TOTAL UNITS | | | | | | | | | | |
|------------------------------|------------|-----------|---------------|---------------------------|------------------------------|---------------|--------------------|-----------------|----------------------|------------------------|
| | FLOW (MGD) | RAS (MGD) | RECYCLE (MGD) | RAW SEWAGE W.S. ELEVATION | MECHANICALLY CLEANED SCREENS | GRIT CHAMBERS | PRIMARY CLARIFIERS | AERATION BASINS | SECONDARY CLARIFIERS | UV DISINFECTION BASINS |
| CASE 1 | 5 | 2.5 | 0.6 | 623.78 | 1/2 | 1/2 | 1/2 | 2/2 | 2/2 | 2/3 |
| CASE 2 | 11 | 5.0 | 0.0 | 623.78 | 1/2 | 1/2 | 1/2 | 1/2 | 2/2 | 2/3 |
| CASE 3 | 15 | 5.0 | 0.0 | 625.70 | 1/2 | 1/2 | 1/2 | 1/2 | 2/2 | 2/3 |
| CASE 4 | 15 | 5.0 | 0.0 | 625.70 | 1/2 | 1/2 | 1/2 | 2/2 | 2/2 | 2/3 |

NOTE: IN CASE 3 AND 4, MECHANICAL BAR SCREENS, GRIT CHAMBERS AND PRIMARY CLARIFIERS RECEIVE 11 MGD ONLY.



| ISSUE | DATE | DESCRIPTION |
|-------|----------|----------------------------------|
| 1 | APR 2014 | RECORD DRAWINGS |
| 0 | NOV 2011 | ISSUE FOR CONSTRUCTION SUBMITTAL |

| | |
|-----------------|-------------|
| PROJECT MANAGER | A. MEILLEUR |
| DESIGNED | J. MANION |
| DRAWN | B. LILLY |
| CHECKED | B. LILLY |
| PROJECT NUMBER | 171097 |

ELECTRONIC SEAL AND SIGNATURE HAS BEEN REMOVED. THIS MEDIA SHOULD NOT BE CONSIDERED A CERTIFIED DOCUMENT



GENERAL HYDRAULIC PROFILE



| | |
|----------|--------------|
| FILENAME | 000G-04.dwg |
| SCALE | NOT TO SCALE |

| | |
|-------|---------|
| SHEET | 000G-04 |
|-------|---------|

ELECTRONIC MEDIA DISCLAIMER: THIS ELECTRONIC MEDIA PROVIDED BY HDR ENGINEERING, INC. IS SUBJECT TO AN ELECTRONIC MEDIA RELEASE. ALL USE AND RE-USE OF THIS MEDIA IS SUBJECT TO THE TERMS AND CONDITIONS OF THE RELEASE.

| | | | | | | | | | | | |
|--------|---|-------|---|--------|-------------------------------------|-------|-------------------------------------|-----|-----------------------|---------|---|
| A/C | AIR CONDITIONING | CLG | CEILING | EXT | EXTERIOR, EXTERNAL, EXTENSION | HZ | HERTZ, CYCLES PER SECOND | N | NORTH, NEUTRAL | R&R | REMOVE AND REPLACE |
| A/E | ARCHITECT/ENGINEER | CLKG | CAULKING | F TO F | FACE TO FACE | ID | INSIDE DIAMETER, INTERIOR DIMENSION | NA | NOT APPLICABLE | R&S | REMOVE AND SALVAGE |
| A | AMPERE | CLR | CLEAR | F&B | FACE AND BYPASS | IE | INVERT ELEVATION, FOR EXAMPLE | NAT | NATURAL, NATIONAL | R | RADIUS, REGISTER, RISER |
| AB | ANCHOR BOLT | CMH | COMMUNICATION MANHOLE | FAB | FABRICATE | IF | INSIDE FACE | NC | NORMALLY CLOSED | RA | RETURN AIR |
| ABAN | ABANDON | CMP | CORRUGATED METAL PIPE | FB | FIBER BEAM | IM | INTAKE HOOD | NEG | NEGATIVE | RB | RESILIENT BASE, ROCK BERM |
| ABC | AGGREGATE BASE COURSE | CMU | CONCRETE MASONRY UNIT | FBD | FIBERBOARD | IMP | IMPACT | NF | NEAR FACE, NON-FUSED | RCPT | RECEPTACLE |
| ABT | ABOUT | CO | CLEANOUT, CONCRETE OPENING | FBG | FIBERGLASS | IN | INCH | NIC | NOT IN CONTRACT | RD | ROUGH DRAIN |
| AC | ALTERNATING CURRENT | COL | COLUMN | FBM | BOARD FOOT MEASURE | INC | INCLUDE, INCANDESCENT | NO | NORMALLY OPEN, NUMBER | REC | RECESS |
| ACK | ACKNOWLEDGE | COM | COMMON | FBO | FURNISHED BY OWNER | INF | INFLUENT | NOM | NOMINAL | RECD | RECEIVED |
| ACP | ACOUSTIC CEILING PANEL, ASPHALTIC CONCRETE PAVEMENT | COMB | COMBINATION | FC | FLUSHING CONNECTION | INSTR | INSTRUMENTATION | NPS | NOMINAL PIPE SIZE | RECT | RECTANGULAR |
| ACST | ACOUSTIC | COMM | COMMUNICATION | FCA | FLANGED COUPLING ADAPTER | INSUL | INSULATION | NPT | NATIONAL PIPE THREAD | RED | REDUCER |
| AD | ADDENDUM, AREA DRAIN | COMP | COMPOSITION, COMPRESSIBLE, COMPOSITE | FD | FLOOR DRAIN | INT | INTERIOR, INTERSECTION | NS | NEAR SIDE | REF | REFERENCE |
| ADDL | ADDITIONAL | CON | CONCENTRIC | FDC | FLEXIBLE DUCT CONNECTION | INTR | INTERMEDIATE, INTERIOR | NTS | NOT TO SCALE | REINF | REINFORCING |
| ADH | ADHESIVE | CONC | CONCRETE | FDR | FEEDER | INVT | INVERT | NWL | NORMAL WATER LEVEL | REM | REMOVE |
| ADJ | ADJUSTABLE, ADJACENT | CONN | CONNECTION | FDTN | FOUNDATION | IPS | IRON PIPE SIZE | | | REQD | REQUIRED |
| AF | AMP FRAME, AMP FUSE | CONST | CONSTRUCTION | FE | FLANGED END | IPT | INTERNAL PIPE THREAD | | | RESIL | RESILIENT |
| AFF | ABOVE FINISH FLOOR | CONT | CONTINUOUS | FEC | FIRE EXTINGUISHER CABINET | IR | INSIDE RADIUS, IRON ROD | | | RET | RETAINING, RETURN |
| AFG | ABOVE FINISH GRADE | COORD | COORDINATE | FES | FLARED END SECTION | IRR | IRRIGATION | | | REV | REVISION, REVERSE |
| AGGR | AGGREGATE | CORR | CORROSIVE, CORRUGATED | FEXT | FIRE EXTINGUISHER | ISO | ISOMETRIC | | | RF | RESILIENT FLOORING |
| AI | AREA INLET, ANALOG INPUT | CORR | CORROSIVE, CORRUGATED | FF | FAR FACE, FACTORY FINISH, FLAT FACE | | | | | RFG | ROOFING |
| AIC | AMPS INTERRUPTING CAPACITY | CP | CHECKER PLATE, CONTROL POINT | FG | FINISHED GRADE | JB | JUNCTION BOX | | | RFL | REFLECTED, REFLECTOR |
| ALIG | ALIGNMENT | CPLG | COUPLING | FH | FIRE HYDRANT | JCT | JUNCTION | | | RGH | ROUGH |
| ALT | ALTERNATE, ALTITUDE | CRL | CORROSION-RESISTANT LINING | FIG | FIGURE | JF | JOINT FILLER | | | RGS | RIGID GALVANIZED STEEL |
| ALUM | ALUMINUM | CSC | COMPRESSION SLEEVE COUPLING | FIN | FINISH | JST | JOIST | | | RGS-PVC | PVC COATED RGS |
| AM | ACOUSTICAL MATERIAL | CSK | COUNTERSINK | FJT | FLUSH JOINT | JT | JOINT | | | RH | RELIEF HOOD, RIGHT HAND, RELATIVE HUMIDITY |
| AMB | AMBIENT | CSS | CLINIC SERVICE SINK | FL | FLOW, FLOW LINE | | | | | | |
| ANC | ANCHOR | CT | CERAMIC TILE | FLEX | FLEXIBLE | K | KIP | | | RL | REQUIRED LAP |
| AO | ANALOG OUTPUT | CTJ | CONTRACTION JOINT | FLG | FLANGE | KB | KNEE BRACE | | | RLFA | RELIEF AIR |
| AP | ACCESS PANEL | CTR | CENTER | FLOR | FLUORESCENT | KCMIL | THOUSAND CIRCULAR MILS | | | RND | ROUND |
| APRX | APPROXIMATE | CTRL | CONTROL | FLR | FLOOR | KD | KNOCK DOWN | | | RNG | RUNNING |
| APVD | APPROVED | CVT | CULVERT | FLS | FLASHING, FLUSH | KO | KNOCK OUT | | | RO | ROUGH OPENING |
| ARCH | ARCHITECTURAL | CU | COPPER, CUBIC | FN | FENCE | KSI | KIPS PER SQUARE INCH | | | ROW | RIGHT-OF-WAY |
| ASSY | ASSEMBLY | CW | CLOCKWISE | FO | FINISHED OPENING | KW | KILOWATT | | | RPM | REVOLUTIONS PER MINUTE |
| AT | ACOUSTICAL TILE, AMP TRIP | CY | CUBIC YARD | FOB | FLAT ON BOTTOM | | | | | RR | RAILROAD |
| ATC | ACOUSTICAL TILE CEILING | | | FOC | FACE OF CONCRETE, FACE OF CURB | L | ANGLE, LENGTH, LAVATORY, LINTEL | | | RSP | ROCK SLOPE PROTECTION |
| ATM | ATMOSPHERE | d | PENNY (NAIL MEASURE) | FOF | FACE OF FINISH | LAD | LADDER | | | RST | REINFORCING STEEL |
| AUTO | AUTOMATIC | D | DEEP, DIFFUSER, DRAIN | FOM | FACE OF MASONRY | LAM | LAMINATE | | | RSW | RECURCULATING SCRUBBER WATER |
| AUX | AUXILIARY | DB | DUCT BANK, DECIBEL, DRY BULB | FOS | FACE OF STUDS | LATL | LATERAL | | | RT | RIGHT |
| AVE | AVENUE | DBA | DEFORMED BAR ANCHOR | FOT | FLAT ON TOP | LB | LAG BOLT, POUND | | | RVT | RESILIENT VINYL TILE |
| AVG | AVERAGE | DBL | DOUBLE | FPT | FEMALE PIPE THREAD | LCTB | LIQUID CHALK AND TACK BOARD | | | RY | READY |
| AWC | AMERICAN WIRE GAGE | DC | DIRECT CURRENT | FR | FRAME | LDG | LANDING | | | | |
| AWT | ACOUSTICAL WALL TILE | DEG | DEGREE | FRP | FIBERGLASS REINFORCED PLASTIC | LDR | LEADER | | | S | SOUTH, SINK |
| | | DEG C | DEGREE CENTIGRADE | FRTM | FIRE RETARDANT TREATED MATERIAL | LE | LIFTING EYE | | | SA | SUPPLY AIR |
| | | DEG F | DEGREE FAHRENHEIT | FS | FLOOR SINK, FAR SIDE | LF | LINEAR FOOT | | | SAMU | SOUND-ABSORBING MASONRY UNIT |
| B TO B | BACK TO BACK | DEMO | DEMOLITION | FT | FEET, FOOT | LG | LONG | | | SAN | SANITARY |
| BAL | BALANCE | DEP | DEPRESSED | FTG | FOOTING, FITTING | LH | LEFT HAND | | | SB | SPLASH BLOCK |
| BBD | BULLETIN BOARD | DEPT | DEPARTMENT | FUR | FURRED, FURRING | LIN | LINEAR | | | SC | SOLID CORE |
| BC | BASE CABINET, BOTTOM CHORD, BOLT CENTER, BOLT CIRCLE | DET | DETAIL | FURN | FURNITURE, FURNISH | LIQ | LIQUID | | | SCH | SCHEDULE |
| | | DI | DROP INLET, DUCTILE IRON, DIGITAL INPUT | FUT | FUTURE | LLH | LONG LEG HORIZONTAL | | | SCHEM | SCHEMATIC |
| BD | BOARD | DIA | DIAMETER | FV | FACE VELOCITY | LLV | LONG LEG VERTICAL | | | SCN | SCREEN |
| BE | BOTH ENDS, BELL END | DIAG | DIAGONAL, DIAGRAM | FW | FIELD WELD, FIRE WALL | LMU | LONG MARKER LECTURE UNIT | | | SE | STEEL/ALUMINUM EDGE |
| BF | BOTH FACES, BOTTOM FACE, BLIND FLANGE, BOARD FEET | DIFF | DIFFERENTIAL, DIFFERENCE | FWD | FORWARD | LNG | LONGITUDINAL | | | SEC | SECONDARY, SECONDS |
| | | DIM | DIMENSION | FWE | FURNISHED WITH EQUIPMENT | LOC | LOCATION | | | SECT | SECTION |
| BITUM | BITUMINOUS | DISCH | DISCHARGE | FXTR | FIXTURE | LP | LOW POINT | | | SEP | SEPARATE |
| BKG | BACKING | DIST | DISTANCE, DISTRIBUTION | | | LPS | LOW-PRESSURE SODIUM | | | SF | SQUARE FOOT, SILT FENCE |
| BL | BASE LINE | DIV | DIVISION | | | LR | LONG RADIUS | | | SG | SHEET GLASS, SEALANT GROOVE |
| BLDG | BUILDING | DL | DEAD LOAD | | | LT | LEFT | | | SHT | SHOWER |
| BLK | BLOCK | DMJ | DOUBLE MECHANICAL JOINT | | | LTD | LIMITED | | | SHT | SHEET |
| BLKG | BLOCKING | DMPF | DAMP PROOFING | | | LTG | LIGHTING | | | SHITG | SHEATHING |
| BM | BENCHMARK, BEAM | DN | DOWN | | | LTL | LINTEL | | | SIL | SILENCE |
| BO | BOTTOM OF | DO | DISSOLVED OXYGEN, DIGITAL OUTPUT, DITTO | | | LTNG | LIGHTNING | | | SIM | SIMILAR |
| BOC | BACK OF CURB | DP | DEPTH | | | LJ | LOW VOLTAGE | | | SJ | SLAB JOINT |
| BOD | BOTTOM OF DUCT | DPDT | DOUBLE POLE, DOUBLE THROW | | | LVL | LAMINATED VENEER LUMBER | | | SL | SLOPE, STEEL LINTEL |
| BOG | BOTTOM OF GRILLE | DPST | DOUBLE POLE, SINGLE THROW | | | LVR | LOUVER | | | SLTD | SLOTTED |
| BOL | BOTTOM OF LOUVER, BOLLARD | DS | DOWN SPOUT | | | LW | LIGHTWEIGHT | | | SLV | SLEEVE |
| BOP | BOTTOM OF PIPE | DT | DOUBLE TEE, DRIP TRAP ASSEMBLY | | | LWC | LIGHTWEIGHT CONCRETE | | | SMLS | SEAMLESS |
| BOR | BOTTOM OF REGISTER | DUP | DUPLICATE | | | LWL | LOW WATER LEVEL | | | SOG | SLAB ON GRADE |
| BOT | BOTTOM | DWG | DRAWING | | | | | | | SP | SOUNDPROOF, STANDPIPE |
| BOU | BOTTOM OF UNIT | DWL | DOWEL | | | | | | | SPA | SPACING |
| BP | BASE PLATE | DWR | DRAWER | | | | | | | SPEC | SPECIFICATION |
| BRG | BEARING | | | | | | | | | SPLY | SUPPLY |
| BRGP | BEARING PLATE | E | EAST | | | | | | | SPST | SINGLE POLE SINGLE THROW |
| BRKT | BRACKET | EA | EACH, EXHAUST AIR | | | | | | | SPT | SET POINT |
| BS | BOTH SIDES | ECC | ELECTRICAL CONTRACTOR | | | | | | | SQ | SQUARE |
| BTU | BRITISH THERMAL UNIT | ECC | ECCENTRIC | | | | | | | SR | SHORT RADIUS |
| BTW | BETWEEN | ED | EQUIPMENT DRAIN | | | | | | | SS | SERVICE SINK |
| BTWLD | BUTT WELD | EDB | ELECTRICAL DUCT BANK | | | | | | | SS | STAINLESS STEEL |
| BU | BELL UP, BUILT-UP | EE | EACH END | | | | | | | ST | STREET |
| BUR | BUILT-UP ROOFING | EF | EACH FACE | | | | | | | STA | STATION |
| BW | BOTH WAYS | EFF | EFFLUENT, EFFICIENCY | | | | | | | STD | STANDARD |
| BYP | BYPASS | EHH | ELECTRICAL HANDHOLE | | | | | | | STIF | STIFFENER |
| | | EIFS | EXTERIOR INSULATION & FINISH SYSTEM | | | | | | | STIR | STIRRUP |
| | | EJ | EXPANSION JOINT | | | | | | | STL | STEEL |
| C TO C | CENTER TO CENTER | EL | ELBOW, ELEVATION | | | | | | | STOR | STORAGE |
| C&G | CURB AND GUTTER | ELC | ELECTRICAL | | | | | | | STR | STRUCTURAL, STRAIGHT |
| C | CHANNEL SHAPE, CENTIGRADE, CONDUIT | EMB | EMBEDDED | | | | | | | SUB | SUBSTITUTE |
| CAB | CABINET | EMER | EMERGENCY | | | | | | | SUC | SUCTION |
| CAP | CAPACITY | ENCL | ENCLOSURE | | | | | | | SUSP | SUSPENDED |
| CAT | CATALOG, CATALOGIORY | ENGR | ENGINEER | | | | | | | SY | SQUARE YARD |
| CAV | CAVITY | ENTR | ENTRANCE | | | | | | | SYM | SYMBOL |
| CB | CATCH BASIN | EOP | EDGE OF PAVEMENT | | | | | | | SYMM | SYMMETRICAL |
| CCB | CONCRETE BLOCK | EQ | EQUAL | | | | | | | SYN | SYNTHETIC |
| CCW | COUNTER CLOCKWISE | EQUIP | EQUIPMENT | | | | | | | SYS | SYSTEM |
| CDF | CONTROLLED-DENSITY FILL | ES | EQUIVALENT | | | | | | | | |
| CE | CONCRETE EDGE | ESEW | EMERGENCY SHOWER AND EYE WASH | | | | | | | | |
| CER | CERAMIC | EST | ESTIMATE | | | | | | | | |
| CF | CUBIC FEET (FOOT) | EW | EACH WAY, EMERGENCY | | | | | | | | |
| CFL | COUNTER FLASHING | EW | EYE/FACE WASH | | | | | | | | |
| CHBD | CHALKBOARD | EW | EYE/FACE WASH | | | | | | | | |
| CHD | CHORD | EW | EYE/FACE WASH | | | | | | | | |
| CHFR | CHAMFER | EW | EYE/FACE WASH | | | | | | | | |
| CHH | COMMUNICATION HANDHOLE | EW | EYE/FACE WASH | | | | | | | | |
| CI | CURB INLET | EW | EYE/FACE WASH | | | | | | | | |
| CIP | CAST-IN-PLACE | EW | EYE/FACE WASH | | | | | | | | |
| CIPB | CONCRETE INTERLOCKING PAVER | EW | EYE/FACE WASH | | | | | | | | |
| | BALLAST | EW | EYE/FACE WASH | | | | | | | | |
| CIRC | CIRCULATION, CIRCULAR | EW | EYE/FACE WASH | | | | | | | | |
| CJ | CONSTRUCTION JOINT | EW | EYE/FACE WASH | | | | | | | | |
| CKT | CIRCUIT | EW | EYE/FACE WASH | | | | | | | | |
| CL | CENTERLINE, CLASS, CLOSE | EW | EYE/FACE WASH | | | | | | | | |

GENERAL NOTES:

- THESE ABBREVIATIONS APPLY TO THE ENTIRE SET OF CONTRACT DRAWINGS.
- LISTING OF ABBREVIATIONS DOES NOT IMPLY THAT ALL ABBREVIATIONS ARE USED IN THE CONTRACT DRAWINGS.
- ABBREVIATIONS SHOWN ON THIS SHEET INCLUDE VARIATIONS OF A WORD. FOR EXAMPLE, "MOD" MAY MEAN MODIFY OR MODIFICATION; "INC" MAY MEAN INCLUDED OR INCLUDING AND "REINF" MAY MEAN EITHER REINFORCE OR REINFORCING.
- SEE INSTRUMENTATION LEGEND SHEET FOR PROJECT-SPECIFIC EQUIPMENT SYMBOLS, EQUIPMENT ABBREVIATIONS, AND PIPING SYSTEM ABBREVIATIONS.



| | | |
|-------|----------|----------------------------------|
| | | |
| | | |
| | | |
| | | |
| 1 | APR 2014 | RECORD DRAWINGS |
| 0 | NOV 2011 | ISSUE FOR CONSTRUCTION SUBMITTAL |
| ISSUE | DATE | DESCRIPTION |

| | |
|-----------------|-------------|
| PROJECT MANAGER | A. MEILLEUR |
| DESIGNED | B. DUDZIK |
| DRAWN | B. LILLY |
| CHECKED | J. KOCH |
| PROJECT NUMBER | 171097 |

 
 



 

 
 
 














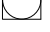
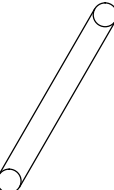
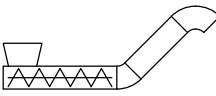



 
 




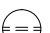




 





 


 
 



 
 
 
 

 
 
 



 

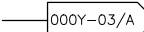
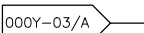
ELECTRONIC SEAL AND SIGNATURE HAS BEEN REMOVED. THIS MEDIA SHOULD NOT BE CONSIDERED A CERTIFIED DOCUMENT



GENERAL ABBREVIATIONS

| | | |
|----------|--------------|---------|
| FILENAME | 000G-05.dwg | SHEET |
| SCALE | NOT TO SCALE | 000G-05 |

ELECTRONIC MEDIA DISCLAIMER: THIS ELECTRONIC MEDIA PROVIDED BY HDR ENGINEERING, INC. IS SUBJECT TO AN ELECTRONIC MEDIA RELEASE. ALL USE AND RE-USE OF THIS MEDIA IS SUBJECT TO THE TERMS AND CONDITIONS OF THE RELEASE.

| PRIMARY ELEMENT SYMBOLOGY | | INSTRUMENT SYMBOLOGY | | INSTRUMENT IDENTIFICATION LETTERS | | | | | | CONTROL SWITCH NOTATION ABBREVIATIONS | | MISCELLANEOUS SYMBOLOGY | |
|---|
| <div><div><div></div><div>ORIFICE PLATE</div></div><div><div></div><div>PITOT TUBE OR ANNUBAR</div></div><div><div></div><div>FLOW INDICATOR – ROTAMETER</div></div><div><div></div><div>SONIC OR ULTRASONIC FLOWMETER</div></div><div><div></div><div>MAGNETIC FLOWMETER</div></div><div><div></div><div>MASS DISPERSION FLOWMETER</div></div><div><div></div><div>FLUME</div></div><div><div></div><div>WEIR</div></div><div><div></div><div>PROPELLER OR TURBINE METER</div></div><div><div></div><div>VENTURI TUBE</div></div><div><div></div><div>FLOAT SWITCH</div></div><div><div></div><div>TEMPERATURE ELEMENT WITH THERMOWELL</div></div><div><div></div><div>SIGHT FLOW GLASS</div></div></div> | | <div><div><div></div><div>LOCALLY MOUNTED FIELD INSTRUMENTATION</div></div><div><div></div><div>MOUNTED ON PANEL FRONT</div></div><div><div></div><div>MOUNTED INSIDE PANEL</div></div><div><div><div></div><div>FRONT PANEL MOUNTED ON AUXILIARY PANEL (SUBSCRIPT INDICATES PANEL)</div></div><div><div></div><div>MOUNTED INSIDE AUXILIARY PANEL</div></div><div><div></div><div>PILOT LIGHT</div></div><div><div></div><div>INSTRUMENT FUNCTIONS SHARING COMMON HOUSING</div></div><div><div></div><div>COMPLEX INTERLOCK AS DEFINED IN CONTROL DIAGRAM OR IN SPECIFICATIONS</div></div><div><div></div><div>SHARED DISPLAY, SHARED CONTROL, FIELD MOUNTED</div></div><div><div></div><div>SHARED DISPLAY, SHARED CONTROL, PRIMARY LOCATION – NORMALLY ACCESSIBLE TO OPERATOR</div></div><div><div></div><div>PROGRAMMABLE LOGIC CONTROL, PRIMARY LOCATION – NORMALLY ACCESSIBLE TO OPERATOR</div></div><div><div></div><div>PROGRAMMABLE LOGIC CONTROL, FIELD MOUNTED</div></div></div></div> | | <table><tr><th></th><th colspan="2">FIRST LETTER</th><th colspan="3">SUCCEEDING LETTERS</th></tr><tr><th></th><th>MEASURED OR INITIATING VARIABLE</th><th>MODIFIER</th><th>READOUT OR PASSIVE FUNCTION</th><th>OUTPUT FUNCTION</th><th>MODIFIER</th></tr><tr><td>A</td><td>ANALYSIS</td><td></td><td>ALARM</td><td></td><td></td></tr><tr><td>B</td><td>BURNER, COMBUSTION</td><td></td><td>USER’S CHOICE</td><td>USER’S CHOICE</td><td>USER’S CHOICE</td></tr><tr><td>C</td><td>USERS CHOICE</td><td></td><td></td><td>CONTROL</td><td>CLOSED</td></tr><tr><td>D</td><td>USERS CHOICE</td><td>DIFFERENTIAL</td><td></td><td></td><td></td></tr><tr><td>E</td><td>VOLTAGE</td><td></td><td>SENSOR (PRIMARY ELEMENT)</td><td></td><td></td></tr><tr><td>F</td><td>FLOW RATE</td><td>RATIO (FRACTION)</td><td></td><td></td><td></td></tr><tr><td>G</td><td>USER’S CHOICE</td><td></td><td>GLASS, VIEWING DEVICE</td><td></td><td></td></tr><tr><td>H</td><td>HAND</td><td></td><td></td><td></td><td>HIGH</td></tr><tr><td>I</td><td>CURRENT (ELECTRICAL)</td><td></td><td>INDICATE</td><td></td><td></td></tr><tr><td>J</td><td>POWER</td><td>SCAN</td><td></td><td></td><td></td></tr><tr><td>K</td><td>TIME, TIME SCHEDULE</td><td>TIME; RATE OF CHANGE</td><td></td><td>CONTROL STATION</td><td></td></tr><tr><td>L</td><td>LEVEL</td><td></td><td>LIGHT</td><td></td><td>LOW</td></tr><tr><td>M</td><td>USER’S CHOICE</td><td>MOMENTARY</td><td></td><td></td><td>MIDDLE, INTERMEDIATE</td></tr><tr><td>N</td><td>USER’S CHOICE</td><td></td><td>USER’S CHOICE</td><td>USER’S CHOICE</td><td>USER’S CHOICE</td></tr><tr><td>O</td><td>USER’S CHOICE</td><td></td><td>ORIFICE, RESTRICTION</td><td></td><td></td></tr><tr><td>P</td><td>PRESSURE, VACUUM</td><td></td><td>POINT (TEST) CONNECTION</td><td></td><td></td></tr><tr><td>Q</td><td>QUANTITY</td><td>INTEGRATE, TOTALIZE</td><td></td><td></td><td></td></tr><tr><td>R</td><td>RADIATION</td><td></td><td>RECORD</td><td></td><td></td></tr><tr><td>S</td><td>SPEED, FREQUENCY</td><td>SAFETY</td><td></td><td>SWITCH</td><td></td></tr><tr><td>T</td><td>TEMPERATURE</td><td></td><td></td><td>TRANSMIT</td><td></td></tr><tr><td>U</td><td>MULTIVARIABLE</td><td></td><td>MULTIFUNCTION</td><td>MULTIFUNCTION</td><td>MULTIFUNCTION</td></tr><tr><td>V</td><td>VIBRATION, MECH. ANALYSIS</td><td></td><td></td><td>VALVE, DAMPER, LOUVER</td><td></td></tr><tr><td>W</td><td>WEIGHT, FORCE</td><td></td><td>WELL</td><td></td><td></td></tr><tr><td>X</td><td>UNCLASSIFIED</td><td>X AXIS</td><td>UNCLASSIFIED</td><td>UNCLASSIFIED</td><td>UNCLASSIFIED</td></tr><tr><td>Y</td><td>EVENT, STATE OR PRESENCE</td><td>Y AXIS</td><td></td><td>RELAY, COMPUTE, CONVERT</td><td></td></tr><tr><td>Z</td><td>POSITION, DIMENSION</td><td>Z AXIS</td><td></td><td>DRIVER, ACTUATOR, UNCLASSIFIED FINAL CONTROL ELEMENT</td><td></td></tr></table> | | | | | | | FIRST LETTER | | SUCCEEDING LETTERS | | | | MEASURED OR INITIATING VARIABLE | MODIFIER | READOUT OR PASSIVE FUNCTION | OUTPUT FUNCTION | MODIFIER | A | ANALYSIS | | ALARM | | | B | BURNER, COMBUSTION | | USER’S CHOICE | USER’S CHOICE | USER’S CHOICE | C | USERS CHOICE | | | CONTROL | CLOSED | D | USERS CHOICE | DIFFERENTIAL | | | | E | VOLTAGE | | SENSOR (PRIMARY ELEMENT) | | | F | FLOW RATE | RATIO (FRACTION) | | | | G | USER’S CHOICE | | GLASS, VIEWING DEVICE | | | H | HAND | | | | HIGH | I | CURRENT (ELECTRICAL) | | INDICATE | | | J | POWER | SCAN | | | | K | TIME, TIME SCHEDULE | TIME; RATE OF CHANGE | | CONTROL STATION | | L | LEVEL | | LIGHT | | LOW | M | USER’S CHOICE | MOMENTARY | | | MIDDLE, INTERMEDIATE | N | USER’S CHOICE | | USER’S CHOICE | USER’S CHOICE | USER’S CHOICE | O | USER’S CHOICE | | ORIFICE, RESTRICTION | | | P | PRESSURE, VACUUM | | POINT (TEST) CONNECTION | | | Q | QUANTITY | INTEGRATE, TOTALIZE | | | | R | RADIATION | | RECORD | | | S | SPEED, FREQUENCY | SAFETY | | SWITCH | | T | TEMPERATURE | | | TRANSMIT | | U | MULTIVARIABLE | | MULTIFUNCTION | MULTIFUNCTION | MULTIFUNCTION | V | VIBRATION, MECH. ANALYSIS | | | VALVE, DAMPER, LOUVER | | W | WEIGHT, FORCE | | WELL | | | X | UNCLASSIFIED | X AXIS | UNCLASSIFIED | UNCLASSIFIED | UNCLASSIFIED | Y | EVENT, STATE OR PRESENCE | Y AXIS | | RELAY, COMPUTE, CONVERT | | Z | POSITION, DIMENSION | Z AXIS | | DRIVER, ACTUATOR, UNCLASSIFIED FINAL CONTROL ELEMENT | | <div><div><div><div>xxx xxxx</div><div>ACK ESTOP FAIL FOR FR FS HA HOA HOR LL LLS LOR LR LS MA OAC OC OO OSC RJ RJR SIL SS</div><div>ACKNOWLEDGE EMERGENCY STOP FAILURE FORWARD–OFF–REVERSE FORWARD–REVERSE FAST–SLOW HAND–AUTO HAND–OFF–AUTO HAND–OFF–REMOTE LEAD–LAG LEAD–LAG–STANDBY LOCAL–OFF–REMOTE LOCAL–REMOTE LEAD–STANDBY MANUAL–AUTO OPEN–AUTO–CLOSE OPEN–CLOSE ON–OFF OPEN–STOP–CLOSE RUN–JOG RUN–JOG–REVERSE SILENCE START–STOP</div></div></div></div> | | <div><div><div></div><div>PERFORATED FILTER SCREEN</div></div><div><div></div><div>WASHER/COMPACTOR</div></div><div><div></div><div>SLIDE GATE</div></div></div> | |
| | FIRST LETTER | | SUCCEEDING LETTERS | |
| | MEASURED OR INITIATING VARIABLE | MODIFIER | READOUT OR PASSIVE FUNCTION | OUTPUT FUNCTION | MODIFIER | |
| A | ANALYSIS | | ALARM | |
| B | BURNER, COMBUSTION | | USER’S CHOICE | USER’S CHOICE | USER’S CHOICE | |
| C | USERS CHOICE | | | CONTROL | CLOSED | |
| D | USERS CHOICE | DIFFERENTIAL | |
| E | VOLTAGE | | SENSOR (PRIMARY ELEMENT) | |
| F | FLOW RATE | RATIO (FRACTION) | |
| G | USER’S CHOICE | | GLASS, VIEWING DEVICE | |
| H | HAND | | | | HIGH | |
| I | CURRENT (ELECTRICAL) | | INDICATE | |
| J | POWER | SCAN | |
| K | TIME, TIME SCHEDULE | TIME; RATE OF CHANGE | | CONTROL STATION | |
| L | LEVEL | | LIGHT | | LOW | |
| M | USER’S CHOICE | MOMENTARY | | | MIDDLE, INTERMEDIATE | |
| N | USER’S CHOICE | | USER’S CHOICE | USER’S CHOICE | USER’S CHOICE | |
| O | USER’S CHOICE | | ORIFICE, RESTRICTION | |
| P | PRESSURE, VACUUM | | POINT (TEST) CONNECTION | |
| Q | QUANTITY | INTEGRATE, TOTALIZE | |
| R | RADIATION | | RECORD | |
| S | SPEED, FREQUENCY | SAFETY | | SWITCH | |
| T | TEMPERATURE | | | TRANSMIT | |
| U | MULTIVARIABLE | | MULTIFUNCTION | MULTIFUNCTION | MULTIFUNCTION | |
| V | VIBRATION, MECH. ANALYSIS | | | VALVE, DAMPER, LOUVER | |
| W | WEIGHT, FORCE | | WELL | |
| X | UNCLASSIFIED | X AXIS | UNCLASSIFIED | UNCLASSIFIED | UNCLASSIFIED | |
| Y | EVENT, STATE OR PRESENCE | Y AXIS | | RELAY, COMPUTE, CONVERT | |
| Z | POSITION, DIMENSION | Z AXIS | | DRIVER, ACTUATOR, UNCLASSIFIED FINAL CONTROL ELEMENT | |
| LINE TYPES | | ACTUATOR SYMBOLOGY | | MISCELLANEOUS INSTRUMENTATION ABBREVIATIONS | | | | | | VALVES | | GENERAL NOTES: | |
| <div><div><div></div><div>MAIN PROCESS LINE</div></div><div><div></div><div>SECONDARY PROCESS LINE</div></div><div><div></div><div>AUXILIARY PROCESS LINE</div></div><div><div></div><div>DIRECTION OF FLOW</div></div><div><div></div><div>DISCRETE SIGNAL</div></div><div><div></div><div>PNEUMATIC SIGNAL</div></div><div><div></div><div>ELECTRICAL POWER</div></div><div><div></div><div>ELECTRICAL SIGNAL</div></div><div><div></div><div>HYDRAULIC SIGNAL</div></div><div><div></div><div>SOFTWARE OR DATA LINK</div></div><div><div></div><div>SIGNAL CONNECTION</div></div><div><div></div><div>CROSSOVER – NO CONNECTION</div></div><div><div></div><div>CAPILLARY</div></div></div> | | <div><div><div><div></div><div>OPERATOR ABBREVIATIONS: M = MOTOR P = PNEUMATIC S = SOLENOID</div></div><div><div></div><div>FLOAT OPERATOR</div></div><div><div></div><div>SPRING–OPOSED SINGLE–ACTING PNEUMATIC CYLINDER</div></div><div><div></div><div>DOUBLE–ACTING PNEUMATIC CYLINDER</div></div><div><div></div><div>PNEUMATIC DIAPHRAGM</div></div><div><div></div><div>PNEUMATIC DIAPHRAGM WITH POSITIONER</div></div></div></div> | | <div><div>AI AO CL2 CO CO2 COMB COND DEN DI DO DO E/P H2S HCL I/O I/P NOX OI O2 P&ID SS TURB WAN</div><div>ANALOG INPUT ANALOG OUTPUT CHLORINE (ANALYZER MODIFIER) CARBON MONOXIDE (ANALYZER MODIFIER) CARBON DIOXIDE (ANALYZER MODIFIER) COMBUSTIBLES (ANALYZER MODIFIER) CONDUCTIVITY (ANALYZER MODIFIER) DENSITY (ANALYZER MODIFIER) DIGITAL INPUT DIGITAL OUTPUT DISSOLVED OXYGEN (ANALYZER MODIFIER) VOLTAGE TO PNEUMATIC HYDROGEN SULFIDE (ANALYZER MODIFIER) HYDROGEN CHLORIDE (ANALYZER MODIFIER) INPUT/OUTPUT CURRENT TO PNEUMATIC NITROGEN OXIDE (ANALYZER MODIFIER) OPERATOR INTERFACE OXYGEN (ANALYZER MODIFIER) PROCESS AND INSTRUMENTATION DIAGRAM SUSPENDED SOLIDS (ANALYZER MODIFIER) TURBIDITY (ANALYZER MODIFIER) WIDE AREA NETWORK</div></div> | | | | | | <div><div><div>OR </div><div>PRESSURE–RELIEF VALVE</div></div><div><div><div></div><div>AIR–RELEASE VACUUM VALVE A = AIR RELEASE VAC = VACUUM</div></div></div></div> | | <div><div><div></div><div>BALL VALVE</div></div><div><div></div><div>BUTTERFLY VALVE</div></div><div><div></div><div>CONE VALVE</div></div><div><div></div><div>CHECK VALVE</div></div><div><div></div><div>DOUBLE–DISK CHECK VALVE</div></div><div><div></div><div>BALL CHECK VALVE</div></div><div><div></div><div>DIAPHRAGM VALVE</div></div><div><div></div><div>GATE VALVE</div></div><div><div></div><div>GLOBE VALVE</div></div><div><div></div><div>KNIFE GATE VALVE</div></div><div><div></div><div>NEEDLE VALVE</div></div><div><div></div><div>PINCH VALVE</div></div><div><div></div><div>PLUG VALVE</div></div><div><div></div><div>THREE–WAY BALL VALVE</div></div><div><div></div><div>THREE–WAY PLUG VALVE</div></div><div><div></div><div>PRESSURE–REDUCING VALVE</div></div><div><div></div><div>PRESSURE–REGULATING VALVE</div></div><div><div></div><div>THREE–WAY CONTROL VALVE</div></div></div> | | <div>1. THIS IS A STANDARD INSTRUMENTATION SYMBOLOGY AND ABBREVIATIONS SHEET. LISTING OF SYMBOLS AND ABBREVIATIONS DOES NOT IMPLY ALL SYMBOLS AND ABBREVIATIONS HAVE BEEN USED ON THIS PROJECT.</div> <div>2. SEE PROCESS, MECHANICAL AND PLUMBING LEGEND SHEET FOR MISCELLANEOUS PIPING SYMBOLS.</div> <div>3. SCREENING OR SHADING OF WORK IS USED TO INDICATE EXISTING COMPONENTS OR TO DE–EMPHASIZE PROPOSED IMPROVEMENTS TO HIGHLIGHT SELECTED TRADE WORK. REFER TO CONTEXT OF EACH SHEET FOR USAGE.</div> <div>4. VALVE SYMBOLS SHOWN HERE ARE APPLICABLE ONLY TO INSTRUMENTATION DIAGRAMS. SEE PROCESS, MECHANICAL AND PLUMBING LEGEND SHEET FOR VALVE SYMBOLS USED ELSEWHERE ON THE SHEETS.</div> | |
| CROSS REFERENCE SYMBOLOGY | | TYPES OF POWER SUPPLY | |
| <div><div><div></div><div>CONTINUATION "A" ON SHEET 000Y–03</div></div><div><div></div><div>CONTINUATION "A" FROM SHEET 000Y–03</div></div></div> | | <div><div>A IA ES NG HYD</div><div>PLANT COMPRESSED AIR INSTRUMENTATION AIR ELECTRIC SUPPLY NATURAL GAS HYDRAULIC</div></div> | |




| | | |
|-------|----------|----------------------------------|
| | | |
| | | |
| | | |
| 1 | APR 2014 | RECORD DRAWINGS |
| 0 | NOV 2011 | ISSUE FOR CONSTRUCTION SUBMITTAL |
| ISSUE | DATE | DESCRIPTION |

| | |
|-----------------|-------------|
| PROJECT MANAGER | A. MEILLEUR |
| DESIGNED | B. DUDZIK |
| DRAWN | B. LILLY |
| CHECKED | J. KOCK |
| PROJECT NUMBER | 171097 |

ELECTRONIC SEAL AND SIGNATURE HAS BEEN REMOVED. THIS MEDIA SHOULD NOT BE CONSIDERED A CERTIFIED DOCUMENT





 
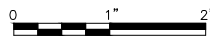 















 









 

 





















 



























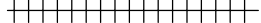












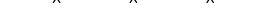


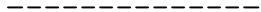











GENERAL INSTRUMENTATION LEGEND



| | |
|----------|--------------|
| FILENAME | 000G-07.dwg |
| SCALE | NOT TO SCALE |

| | |
|-------|---------|
| SHEET | 000G-07 |
|-------|---------|

ELECTRONIC MEDIA DISCLAIMER: THIS ELECTRONIC MEDIA PROVIDED BY HDR ENGINEERING, INC. IS SUBJECT TO AN ELECTRONIC MEDIA RELEASE. ALL USE AND RE-USE OF THIS MEDIA IS SUBJECT TO THE TERMS AND CONDITIONS OF THE RELEASE.

| CIVIL MAPPING SYMBOLOGY | | | UTILITY/CIVIL LINE SYMBOLOGY | | |
|--|--|---|--|---|--|
| <div><div></div><div>EMBANKMENT SLOPE (CUT)</div></div> <div><div></div><div>EMBANKMENT SLOPE (FILL)</div></div> <div><div></div><div>EMBANKMENT SLOPE RIGHT ARROW RIGHT</div></div> <div><div></div><div>EMBANKMENT SLOPE LEFT ARROW LEFT</div></div> <div><div></div><div>SPOT ELEVATION/POINT #</div></div> <div><div></div><div>SURVEY BENCHMARK</div></div> <div><div></div><div>SURVEY CONTROL POINT</div></div> <div><div></div><div>HORIZONTAL CONTROL POINT</div></div> <div><div></div><div>VERTICAL CONTROL POINT</div></div> <div><div></div><div>SECTION CORNER MONUMENT</div></div> <div><div></div><div>SECTION CORNER NO MONUMENT</div></div> <div><div></div><div>IDENTIFICATION AND APPROXIMATE LOCATION OF SOIL TEST HOLE</div></div> <div><div></div><div>TEST PIT</div></div> <div><div></div><div>SOIL BORING</div></div> <div><div></div><div>BUOY</div></div> <div><div></div><div>FLOW ARROW</div></div> <div><div></div><div>WATER LEVEL IN SECTION/PROFILE</div></div> <div><div></div><div>TIDE GAUGE</div></div> <div><div></div><div>EXISTING UTILITY POLE</div></div> <div><div></div><div>DOWNGUY</div></div> <div><div></div><div>EXTERIOR UTILITY JUNCTION BOX</div></div> <div><div></div><div>INTERSTATE HIGHWAY SYMBOL</div></div> <div><div></div><div>US HIGHWAY SYMBOL</div></div> <div><div></div><div>STATE HIGHWAY SYMBOL</div></div> <div><div></div><div>HAY BALE SILT CHECK</div></div> <div><div></div><div>TEMPORARY SEDIMENT TRAP</div></div> <div><div></div><div>PIEZOMETER</div></div> <div><div></div><div>RAIL SIGNAL</div></div> <div><div></div><div>RAIL SWITCH</div></div> <div><div></div><div>SIGN</div></div> <div><div></div><div>TIRE TREDDLE</div></div> <div><div></div><div>TRAFFIC ARM WITH CARD READER</div></div> <div><div></div><div>TRAFFIC ARM MECHANICAL SWING</div></div> | <div><div></div><div>CLEANOUT</div></div> <div><div></div><div>CULVERT END SYMBOL (WITH CULVERT SHOWN BETWEEN SYMBOLS)</div></div> <div><div></div><div>FIRE HYDRANT</div></div> <div><div></div><div>FUEL OIL METER</div></div> <div><div></div><div>FUEL OIL MANHOLE</div></div> <div><div></div><div>FUEL OIL VAULT</div></div> <div><div></div><div>GREASE TRAP</div></div> <div><div></div><div>GRIT CHAMBER</div></div> <div><div></div><div>HEADWALL</div></div> <div><div></div><div>INDUSTRIAL WASTE WATER METER</div></div> <div><div></div><div>INDUSTRIAL WASTE WATER MANHOLE</div></div> <div><div></div><div>NATURAL GAS METER</div></div> <div><div></div><div>NATURAL GAS RECEIVER</div></div> <div><div></div><div>NATURAL GAS TRAP</div></div> <div><div></div><div>NATURAL GAS LINE VAULT</div></div> <div><div></div><div>MONITORING WELL</div></div> <div><div></div><div>POST INDICATOR VALVE</div></div> <div><div></div><div>PUMP STATION</div></div> <div><div></div><div>SANITARY MANHOLE</div></div> <div><div></div><div>SEPTIC TANK</div></div> <div><div></div><div>TANK BELOW GROUND</div></div> <div><div></div><div>TANK HORIZONTAL ABOVE GROUND</div></div> <div><div></div><div>TANK VERTICAL ABOVE GROUND</div></div> | <div><div></div><div>STORM CATCH BASIN</div></div> <div><div></div><div>STORM ROUND CATCH BASIN</div></div> <div><div></div><div>STORM DRAINAGE MANHOLE</div></div> <div><div></div><div>WATER/AIR VENT</div></div> <div><div></div><div>WATER BACKFLOW PREVENTER</div></div> <div><div></div><div>WATER BLOWOFF</div></div> <div><div></div><div>WATER METER</div></div> <div><div></div><div>WATER SHUTOFF</div></div> <div><div></div><div>WATER SOFTENER</div></div> <div><div></div><div>WATER VALVE VAULT</div></div> <div><div></div><div>VALVE</div></div> | <div><div></div><div>PIPELINE</div></div> <div><div></div><div>LARGE PIPELINE</div></div> <div><div></div><div>UTILITY BENEATH STRUCTURE</div></div> <div><div></div><div>RAILROAD</div></div> <div><div></div><div>CENTERLINE</div></div> <div><div></div><div>BOTTOM OF DITCH</div></div> <div><div></div><div>PROPERTY LINE</div></div> <div><div></div><div>EASEMENT</div></div> <div><div></div><div>LIMITS OF CONSTRUCTION</div></div> <div><div></div><div>ROW</div></div> <div><div></div><div>EXISTING CONTOUR (MINOR)</div></div> <div><div></div><div>EXISTING CONTOUR W/ELEVATION (MAJOR)</div></div> <div><div></div><div>EXISTING FENCE</div></div> <div><div></div><div>EXISTING VEGETATION/BRUSH LINE</div></div> <div><div></div><div>FENCE - BARB WIRE</div></div> <div><div></div><div>FENCE - CHAIN LINK</div></div> <div><div></div><div>FENCE - FIELD</div></div> <div><div></div><div>FENCE - OTHER</div></div> <div><div></div><div>FENCE - WOOD</div></div> <div><div></div><div>FENCE - WOVEN WIRE</div></div> <div><div></div><div>FLOOD LIMIT (25 YEAR)</div></div> <div><div></div><div>FLOOD LIMIT (50 YEAR)</div></div> <div><div></div><div>FLOOD LIMIT (100 YEAR)</div></div> <div><div></div><div>FLOOD LIMIT (200 YEAR)</div></div> <div><div></div><div>FLOOD LIMIT (500 YEAR)</div></div> <div><div></div><div>HIGHWAY GUARDRAIL</div></div> <div><div></div><div>LEVEE TOP</div></div> <div><div></div><div>LEVEE TOE</div></div> <div><div></div><div>NEW CONTOUR (MINOR)</div></div> <div><div></div><div>NEW CONTOUR (MAJOR)</div></div> <div><div></div><div>ROCK BERM</div></div> <div><div></div><div>SILT FENCE</div></div> <div><div></div><div>TOE OF SLOPE</div></div> <div><div></div><div>TOP OF SLOPE</div></div> | <div><div></div><div>FO FIBER OPTIC</div></div> <div><div></div><div>IW FUEL OIL</div></div> <div><div></div><div>G NATURAL GAS</div></div> <div><div></div><div>IW INDUSTRIAL WASTE WATER</div></div> <div><div></div><div>SS SANITARY SEWER</div></div> <div><div></div><div>SD STORM SEWER</div></div> <div><div></div><div>W DOMESTIC WATER</div></div> <div><div></div><div>NPW DOMESTIC WATER NON-POTABLE</div></div> | |
| | | | | <div>GENERAL NOTES:</div> <div>1. THIS IS A STANDARD CIVIL SYMBOLOGY SHEET. ALL SYMBOLS ARE NOT NECESSARILY USED ON THIS PROJECT.</div> <div>2. SCREENING OR SHADING OF WORK IS USED TO INDICATE EXISTING COMPONENTS OR TO DE-EMPHASIZE PROPOSED IMPROVEMENTS TO HIGHLIGHT SELECTED TRADE WORK. REFER TO CONTEXT OF EACH SHEET FOR USAGE.</div> | |

UNDERGROUND SERVICE ALERT



ONE-CALL NUMBER
1-800-424-5555
CALL TWO BUSINESS DAYS
BEFORE YOU DIG



HDR Engineering, Inc.

| | | |
|-------|----------|----------------------------------|
| | | |
| | | |
| | | |
| | | |
| 1 | APR 2014 | RECORD DRAWINGS |
| 0 | NOV 2011 | ISSUE FOR CONSTRUCTION SUBMITTAL |
| ISSUE | DATE | DESCRIPTION |

| | |
|-----------------|-------------|
| PROJECT MANAGER | A. MEILLEUR |
| DESIGNED | B. DUDZIK |
| DRAWN | B. LILLY |
| CHECKED | J. KOCH |
| PROJECT NUMBER | 171097 |

ELECTRONIC SEAL AND SIGNATURE HAS BEEN REMOVED. THIS MEDIA SHOULD NOT BE CONSIDERED A CERTIFIED DOCUMENT



WASTE WATER TREATMENT
PLANT IMPROVEMENTS

012

01"2"

| | | |
|----------|--------------|---------|
| FILENAME | 000G-08.dwg | SHEET |
| SCALE | NOT TO SCALE | 000G-08 |

ELECTRONIC MEDIA DISCLAIMER: THIS ELECTRONIC MEDIA PROVIDED BY HDR ENGINEERING, INC. IS SUBJECT TO AN ELECTRONIC MEDIA RELEASE. ALL USE AND RE-USE OF THIS MEDIA IS SUBJECT TO THE TERMS AND CONDITIONS OF THE RELEASE.

| PIPING SYMBOLOGY | | |
|------------------|-------------|---|
| VALVES | DOUBLE LINE | ISOLATION |
| | | BALL VALVE |
| | | BUTTERFLY VALVE |
| | | DIAPHRAGM VALVE |
| | | GATE VALVE |
| | | GLOBE VALVE |
| | | KNIFE GATE VALVE |
| | | NEEDLE VALVE |
| | | PINCH VALVE |
| | | PLUG VALVE |
| | | THREE-WAY BALL VALVE |
| | | THREE-WAY PLUG VALVE |
| CONTROL | | |
| | | BALL CHECK VALVE |
| | | CHECK VALVE |
| | | DOUBLE-DISK CHECK VALVE |
| | | CONE VALVE |
| | | PRESSURE RELIEF VALVE |
| | | PRESSURE-REDUCING VALVE |
| | | AIR RELEASE VACUUM VALVE A = AIR RELEASE VAC = VACUUM |
| | | PRESSURE-REGULATING VALVE |
| | | 3-WAY CONTROL VALVE |

| MISCELLANEOUS | |
|--|---------------------------------------|
| | BACKFLOW PREVENTER |
| | WATER METER |
| | VARIABLE AREA METER |
| | UNION |
| | WYE-STRAINER |
| | PENETRATION THROUGH STRUCTURE |
| | FLEXIBLE HOSE OR TUBING |
| | FLEXIBLE PIPING CONNECTION |
| | LINE SIZE CHANGE (CONCENTRIC REDUCER) |
| | LINE SIZE CHANGE (ECCENTRIC REDUCER) |
| | LINE TURNING DOWN |
| | LINE TURNING UP |
| | BLIND FLANGE |
| | PIPE BREAK |
| NOTE: MISCELLANEOUS SYMBOLOGY SHOWN IS FOR SINGLE-LINE PIPING. DOUBLE-LINE PIPING SYMBOLS ARE SIMILAR. | |

| MISCELLANEOUS | |
|---------------------------------------|---|
| | PIPE JOINT (SEE SPECS FOR REQUIREMENTS) |
| | COMPRESSION SLEEVE TYPE COUPLING |
| | FLANGED COUPLING ADAPTER (FCA) |
| | FLEXIBLE CONNECTION |
| | HARNESSED MECHANICAL COUPLING |
| | PRESSURE GAGE (W/COCK) |
| | TRAP |
| | QUICK DISCONNECT CAM & GROOVE COUPLING |
| | CAP OR PLUG |
| | INTERIOR CLEANOUT |
| | HOSE VALVE, HOSE BIBB, OR FLUSHING CONNECTION |
| | HOSE RACK |
| | FLOOR DRAIN |
| X = TYPE DESIGNATED IN SPECIFICATIONS | |
| | PIPE IN SECTION |
| | BELL UP (PLAN) |
| | BELL UP (SECTION OR SCHEMATIC) |
| | DRAIN (SECTION OR SCHEMATIC) |
| | AIR TOOL ASSEMBLY |
| | AUTOMATIC VALVE STATION |
| | PRESSURE-REDUCING STATION |

| PLUMBING SYMBOLOGY | |
|--------------------|---------------------------|
| | VENT (VT) |
| | POTABLE WATER, COLD (PWC) |
| | POTABLE WATER, HOT (PWH) |

| HVAC SYMBOLOGY | |
|----------------|--|
| | SUPPLY AIR OR OUTSIDE AIR DUCT UP (SECTION CUT, FIRST DIMENSION DUCT WIDTH) |
| | SUPPLY AIR OR OUTSIDE AIR DUCT DOWN (NO SECTION CUT) |
| | RETURN AIR DUCT UP (SECTION CUT) |
| | RETURN AIR DUCT DOWN (NO SECTION CUT) |
| | EXHAUST AIR DUCT UP (NO SECTION CUT) |
| | EXHAUST AIR DUCT DOWN (NO SECTION CUT) |
| | ROUND ELBOW UP |
| | ROUND ELBOW DOWN |
| | TRANSITION - DOUBLE SIDED |
| | TRANSITION - ONE SIDED |
| | TRANSITION - RECTANGULAR TO ROUND DUCT |
| | STANDARD BRANCH - FOR SUPPLY AIR W/EXTRACTOR AND RETURN AIR W/O EXTRACTOR |
| | ELBOW - W/TURNING VANE (RECTANGULAR) |
| | ELBOW - W/TURNING VANES (RECTANGULAR), SMOOTH RADIUS |
| | GOOSENECK HOOD (COWL) |
| | RECTANGULAR DUCT OR OPENING SIZE - FIRST NUMBER INDICATES SIZE OF SIDE SHOWN |
| | ROUND DUCT SIZE |
| | RECTANGULAR DUCT INCLINE - RISE OR DROP IN RESPECT TO THE AIR FLOW |
| | ROUND DUCT INCLINE - RISE OR DROP IN RESPECT TO THE AIR FLOW |
| | HIDDEN DUCT |
| | DUCT ELEVATION TAG ABOVE FINISH FLOOR |
| | PRESSURE/TEMPERATURE TEST PLUG (PETE PLUG OR EQUAL) |
| | SOUND ATTENUATOR |
| | SPLITTER DAMPER |
| | VD = VOLUME DAMPER BDD = BACKDRAFT DAMPER |
| | MOTOR OPERATED DAMPER |
| | FIRE DAMPER |
| | SMOKE DAMPER |
| | SMOKE AND FIRE DAMPER |

| HVAC SYMBOLOGY | |
|----------------|--|
| | FLEXIBLE CONNECTION |
| | FLEXIBLE DUCT |
| | ACOUSTICAL LINING - DUCT DIMENSIONS FOR NET FREE AREA |
| | SUPPLY AIR REGISTER OR GRILLE - W/DUCT-MOUNTED EXTRACTOR |
| | EXHAUST AIR OR RETURN AIR REGISTER OR GRILLE |
| | EXHAUST AIR OR RETURN AIR REGISTER OR GRILLE |
| | SUPPLY AIR ASSEMBLY SQUARE DIFFUSER |
| | SUPPLY AIR ASSEMBLY ROUND DIFFUSER |
| | WALL LOUVER |
| | ACCESS DOOR |
| | UNDERCUT DOOR 3/4" |
| | ACCESS DOOR OR ACCESS PANEL IN DUCTWORK |
| | INTAKE OR RELIEF HOOD |
| | DOOR GRILLE |
| | BACKDRAFT DAMPER |
| | EXHAUST ROOF VENTILATOR PROPELLER OR CENTRIFUGAL TYPE |
| | PROPELLER WALL FAN |
| | ROOM AIR CONDITIONING UNIT |
| | INTAKE/EXHAUST LOUVER |
| | SUPPLY, RETURN OR EXHAUST FAN |
| | AIR FILTER |

| HVAC CONTROL SYMBOLOGY | |
|------------------------|------------------------------|
| | TEMPERATURE CONTROLLER |
| | TEMPERATURE TRANSMITTER |
| | TEMPERATURE SWITCH |
| | THERMOSTAT |
| | TEMPERATURE INDICATOR |
| | PERCENTAGE TIMER |
| | RECEIVER CONTROLLER |
| | HAND-OFF-AUTO |
| | MOTOR STARTER |
| | DAMPER ACTUATOR |
| | PRESSURE INDICATOR |
| | FREEZE STAT |
| | FIRE STAT |
| | DIFFERENTIAL PRESSURE SWITCH |
| | SMOKE DETECTOR |
| | FLOW SWITCH |
| | PRESSURE SWITCH |
| | TIME DELAY |
| | MINIMUM POSITION RELAY |
| | SIGNAL |
| | ANALOG OUTPUT |
| | ANALOG INPUT |
| | DIGITAL OUTPUT |
| | DIGITAL INPUT |
| | COMMON PORT |
| | SIGNAL PORT |
| | NORMALLY OPEN |
| | NORMALLY CLOSED |
| | BALANCING VALVE |
| | RESISTANCE HEATING CONTACTOR |
| | TEST-AUTO |
| | TEST-OFF-AUTO |
| | ELECTRIC SIGNAL |
| | PIPING |
| | BULB-TYPE THERMOSTAT |

| AIR FLOW SCHEMATIC AND TEMPERATURE CONTROL DIAGRAM SYMBOLOGY | |
|--|--|
| | CHILLED WATER COOLING COIL |
| | HOT WATER HEATING COIL |
| | DIRECT EVAPORATIVE COOLER |
| | DIRECT EXPANSION COOLING COIL |
| | ELECTRIC HEATING COIL |
| | VFD (VARIABLE FREQUENCY DRIVE) |
| | CONSTANT AIR VOLUME BOX WITH REHEAT COIL |
| | VARIABLE AIR VOLUME BOX WITH REHEAT COIL |

| MISCELLANEOUS SYMBOLOGY | |
|-------------------------|-------------------------------------|
| | MIST ELIMINATOR |
| | ACTIVATED CARBON OR CHEMICAL FILTER |
| | CENTRIFUGAL PUMP |
| | SPRAY NOZZLE/HUMIDIFIER |

| GENERAL NOTES: | |
|--|--|
| 1. THIS IS A STANDARD PROCESS, MECHANICAL AND PLUMBING SYMBOLOGY SHEET. ALL SYMBOLS ARE NOT NECESSARILY USED ON THIS PROJECT. | |
| 2. SCREENING OR SHADING OF WORK IS USED TO INDICATE EXISTING COMPONENTS OR TO DE-EMPHASIZE PROPOSED IMPROVEMENTS TO HIGHLIGHT SELECTED TRADE WORK. REFER TO CONTEXT OF EACH SHEET FOR USAGE. | |
| 3. SEE INSTRUMENTATION LEGEND SHEET FOR PROJECT-SPECIFIC EQUIPMENT SYMBOLS, EQUIPMENT ABBREVIATIONS, AND PIPING SYSTEM ABBREVIATIONS. | |







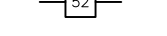
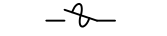









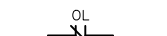


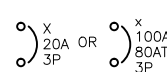




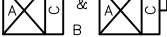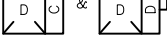





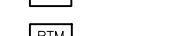
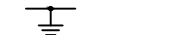



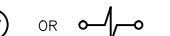


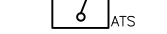
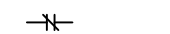


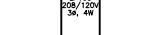
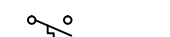





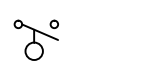
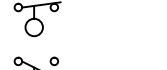














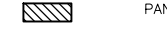

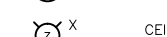
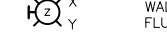
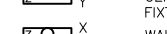

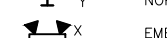

| | | |
|-------|----------|----------------------------------|
| | | |
| | | |
| | | |
| | | |
| 1 | APR 2014 | RECORD DRAWINGS |
| 0 | NOV 2011 | ISSUE FOR CONSTRUCTION SUBMITTAL |
| ISSUE | DATE | DESCRIPTION |

| | |
|-----------------|-------------|
| PROJECT MANAGER | A. MEILLEUR |
| DESIGNED | B. DUDZIK |
| DRAWN | B. LILLY |
| CHECKED | B. LILLY |
| PROJECT NUMBER | 171097 |

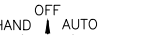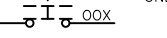ELECTRONIC SEAL AND SIGNATURE HAS BEEN REMOVED. THIS MEDIA SHOULD NOT BE CONSIDERED A CERTIFIED DOCUMENT



| GENERAL MECHANICAL LEGEND | | |
|---------------------------|--------------|---------|
| | | |
| FILENAME | 000G-09.dwg | SHEET |
| SCALE | NOT TO SCALE | 000G-09 |
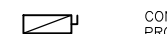
| | | | | | |
|---|---|---|---|---|---|
|                         | <p>LOW – VOLTAGE CIRCUIT BREAKER (CB). RATINGS AND NO. OF POLES AS SHOWN. WHEN SPECIFIC TYPE IS REQUIRED, X INDICATES TYPE.</p> <p><u>TYPES:</u> MCCB – MOLDED CASE ICCB – INSULATED CASE LVP – LOW – VOLTAGE POWER MCP – MOTOR CIRCUIT PROTECTOR (RATING PER CONNECTED LOAD)</p> <p>SEPARATELY MOUNTED CIRCUIT BREAKER; SEE ELECTRICAL ONE – LINE DIAGRAM OR SCHEDULE FOR DESCRIPTION</p> <p>GROUND FAULT PROTECTION</p> <p>MEDIUM – VOLTAGE CIRCUIT BREAKER</p> <p>FUSE, SIZE, AND NUMBER OF FUSES AS NOTED</p> <p>FUSED CUTOUT, CURRENT RATING, FUSE SIZE, AND NUMBER OF POLES AS NOTED</p> <p>FUSIBLE SWITCH, CURRENT RATING, FUSE SIZE, AND QUANTITY AS NOTED</p> <p>NON-FUSED SWITCH, CURRENT RATING, AND NUMBER OF POLES AS NOTED</p> <p>DISCONNECT OR DRAWOUT CONNECTION</p> <p>MAGNETIC MOTOR STARTER AND SEPARATELY MOUNTED COMBINATION MAGNETIC MOTOR STARTER</p> <p>MOTOR CONTROLLER AND SEPARATELY MOUNTED MOTOR CONTROLLER WITH SHORT CIRCUIT PROTECTION AND DISCONNECT</p> <p><u>MOTOR STARTER AND CONTROLLER SUBSCRIPTS:</u> A – MAGNETIC STARTER NEMA SIZE B – STARTER TYPE NONE – FULL VOLTAGE NON-REVERSING (FVNR) FVR – FULL VOLTAGE REVERSING 2S – TWO SPEED RVAT – REDUCED VOLTAGE AUTO TRANSFORMER</p> <p>C – CONTROL DIAGRAM OR CONTROLS SCHEDULE NUMBER (IF REQUIRED)</p> <p>D – CONTROLLER TYPE VFD – VARIABLE FREQUENCY DRIVE SS – SOLID STATE</p> <p>SEPARATELY MOUNTED COMBINATION MOTOR STARTER OR CONTROLLER; SEE ELECTRICAL ONE – LINE DIAGRAM OR SCHEDULE FOR DESCRIPTION</p> <p>THERMAL OVERLOAD ELEMENT</p> <p>THERMAL OVERLOAD RELAY CONTACT</p> <p>DISCONNECT OR SAFETY SWITCH, 30A, 3P, NON-FUSED UNLESS OTHERWISE NOTED</p> <p>MOTOR WITH DESIGN HORSEPOWER (WHEN INDICATED)</p> <p>GENERATOR</p> <p>TRANSFER SWITCH, CURRENT RATING, AND NUMBER OF POLES AS NOTED ATS – AUTOMATIC MTS – MANUAL</p> <p>TRANSFORMER</p> <p>3-PHASE, 3-WIRE DELTA CONNECTION</p> <p>3-PHASE, 4-WIRE GROUNDED WYE CONNECTION</p> <p>SWITCHBOARD OR PANELBOARD; NAME, VOLTAGE, PHASE, NUMBER OF WIRES WHEN INDICATED</p> |                         | <p>NON-MOTOR LOAD WITH DESIGN KVA, KW, OR AMP</p> <p>CONTROL POWER TRANSFORMER (CPT)</p> <p>VOLTAGE TRANSFORMER (VT OR PT)</p> <p>CURRENT TRANSFORMER (CT)</p> <p>UTILITY WATT-HOUR METER PER UTILITY REQUIREMENTS</p> <p>DIGITAL METERING PACKAGE</p> <p>RUN TIME METER</p> <p>GROUND</p> <p>LIGHTNING ARRESTER</p> <p>LOW VOLTAGE SURGE PROTECTIVE DEVICE</p> <p>ELECTRICAL CONNECTION</p> <p>NO ELECTRICAL CONNECTION</p> <p>SOLENOID VALVE</p> <p>CONTROL/RELAY COIL; X INDICATES TYPE, Y INDICATES LOOP NO. WHEN USED</p> <p><u>TYPES:</u> CR – CONTROL RELAY DP – DEFINITE PURPOSE RELAY LC – LIGHTING CONTACTOR M – MOTOR STARTER PC – PHOTO CELL TC – TIME CLOCK TR – TIMING RELAY</p> <p>NORMALLY OPEN CONTACT (N.O.)</p> <p>NORMALLY CLOSED CONTACT (N.C.)</p> <p>NORMALLY OPEN TIME DELAY RELAY CONTACT WITH TIME DELAY ON CLOSING AFTER COIL IS ENERGIZED</p> <p>NORMALLY CLOSED TIME DELAY RELAY CONTACT WITH TIME DELAY ON OPENING AFTER COIL IS ENERGIZED</p> <p>NORMALLY OPEN TIME DELAY RELAY CONTACT WITH TIME DELAY ON OPENING AFTER COIL IS DE-ENERGIZED</p> <p>NORMALLY CLOSED TIME DELAY RELAY CONTACT WITH TIME DELAY ON CLOSING AFTER COIL IS DE-ENERGIZED</p> <p>NORMALLY OPEN TEMPERATURE SWITCH; CLOSE ON RISING TEMPERATURE</p> <p>NORMALLY CLOSED TEMPERATURE SWITCH; OPEN ON RISING TEMPERATURE</p> <p>NORMALLY OPEN FLOW SWITCH; CLOSE ON INCREASING FLOW</p> <p>NORMALLY CLOSED FLOW SWITCH; OPEN ON INCREASING FLOW</p> |                         | <p>NORMALLY OPEN LEVEL SWITCH, CLOSE ON RISING LEVEL</p> <p>NORMALLY CLOSED LEVEL SWITCH, OPEN ON RISING LEVEL</p> <p>NORMALLY OPEN PRESSURE SWITCH, CLOSE ON INCREASING PRESSURE</p> <p>NORMALLY CLOSED PRESSURE SWITCH, OPEN ON INCREASING PRESSURE</p> <p>NORMALLY OPEN LIMIT SWITCH, CLOSE ON REACHING LIMIT</p> <p>NORMALLY CLOSED LIMIT SWITCH, OPEN ON REACHING LIMIT</p> <p>FIELD WIRING EXTERNAL TO CONTROL PANEL</p> <p>INTERLOCK; X INDICATES TYPE</p> <p><u>TYPES:</u> E – ELECTRICAL M – MECHANICAL K – KEY</p> <p>3 POSITION SELECTOR SWITCH, MAINTAINED CONTACTS; UNLESS OTHERWISE NOTED, 2-POSITION SIMILAR</p> <p>NORMALLY OPEN PUSHBUTTON, MOM</p> |
|---|---|---|---|---|---|

| <p>UNDERGROUND SERVICE ALERT</p> <p>ONE-CALL NUMBER 1-800-424-5555</p> <p>CALL TWO BUSINESS DAYS BEFORE YOU DIG</p> | <p>HDR Engineering, Inc.</p> | <table border="1" style="width: 100%; border-collapse: collapse;"> <thead> <tr> <th style="width: 5%;">ISSUE</th> <th style="width: 15%;">DATE</th> <th style="width: 80%;">DESCRIPTION</th> </tr> </thead> <tbody> <tr> <td>1</td> <td>APR 2014</td> <td>RECORD DRAWINGS</td> </tr> <tr> <td>0</td> <td>NOV 2011</td> <td>ISSUE FOR CONSTRUCTION SUBMITTAL</td> </tr> </tbody> </table> | ISSUE | DATE | DESCRIPTION | 1 | APR 2014 | RECORD DRAWINGS | 0 | NOV 2011 | ISSUE FOR CONSTRUCTION SUBMITTAL | <table border="1" style="width: 100%; border-collapse: collapse;"> <tr> <td style="width: 40%;">PROJECT MANAGER</td> <td>A. MEILLEUR</td> </tr> <tr> <td>DESIGNED</td> <td>I. RINCON</td> </tr> <tr> <td>DRAWN</td> <td>HDRSTD</td> </tr> <tr> <td>CHECKED</td> <td>E. SWANSON</td> </tr> <tr> <td>PROJECT NUMBER</td> <td>171097</td> </tr> </table> | PROJECT MANAGER | A. MEILLEUR | DESIGNED | I. RINCON | DRAWN | HDRSTD | CHECKED | E. SWANSON | PROJECT NUMBER | 171097 | <p>ELECTRONIC SEAL AND SIGNATURE HAS BEEN REMOVED. THIS MEDIA SHOULD NOT BE CONSIDERED A CERTIFIED DOCUMENT</p> | WASTE WATER TREATMENT PLANT IMPROVEMENTS | <p>GENERAL ELECTRICAL LEGEND</p> <div style="display: flex; justify-content: space-around; align-items: center; margin-top: 10px;"> <div style="text-align: center;"> <p>0 1" 2"</p> </div> <table border="1" style="font-size: x-small; border-collapse: collapse;"> <tr> <td style="width: 30%;">FILENAME</td> <td>000G-10.dwg</td> </tr> <tr> <td>SCALE</td> <td>NOT TO SCALE</td> </tr> </table> </div> | FILENAME | 000G-10.dwg | SCALE | NOT TO SCALE | <p>SHEET</p> <p style="font-size: large;">000G-10</p> |
|---|------------------------------|--|-------|------|-------------|---|----------|-----------------|---|----------|----------------------------------|---|-----------------|-------------|----------|-----------|-------|--------|---------|------------|----------------|--------|--|---|--|----------|-------------|-------|--------------|--|
| ISSUE | DATE | DESCRIPTION | | | | | | | | | | | | | | | | | | | | | | | | | | | | |
| 1 | APR 2014 | RECORD DRAWINGS | | | | | | | | | | | | | | | | | | | | | | | | | | | | |
| 0 | NOV 2011 | ISSUE FOR CONSTRUCTION SUBMITTAL | | | | | | | | | | | | | | | | | | | | | | | | | | | | |
| PROJECT MANAGER | A. MEILLEUR | | | | | | | | | | | | | | | | | | | | | | | | | | | | | |
| DESIGNED | I. RINCON | | | | | | | | | | | | | | | | | | | | | | | | | | | | | |
| DRAWN | HDRSTD | | | | | | | | | | | | | | | | | | | | | | | | | | | | | |
| CHECKED | E. SWANSON | | | | | | | | | | | | | | | | | | | | | | | | | | | | | |
| PROJECT NUMBER | 171097 | | | | | | | | | | | | | | | | | | | | | | | | | | | | | |
| FILENAME | 000G-10.dwg | | | | | | | | | | | | | | | | | | | | | | | | | | | | | |
| SCALE | NOT TO SCALE | | | | | | | | | | | | | | | | | | | | | | | | | | | | | |

ELECTRONIC MEDIA DISCLAIMER: THIS ELECTRONIC MEDIA PROVIDED BY HDR ENGINEERING, INC. IS SUBJECT TO AN ELECTRONIC MEDIA RELEASE. ALL USE AND RE-USE OF THIS MEDIA IS SUBJECT TO THE TERMS AND CONDITIONS OF THE RELEASE.


SCREENINGS BUILDING
CONTROL PANEL
SRCP-12000
PLC-12000

MCC

PROCESS

GENERAL NOTES:

- VENDOR CONTROL PANEL SHALL BE LOCATED IN THE ELECTRICAL ROOM. THE ELECTRICAL ROOM IS UNCLASSIFIED UNDER NFPA 820.
- THE SCREENINGS ROOM IS A CLASS I, DIVISION 2 AREA UNDER NFPA 820.
- ALL SYSTEM DRAINS WILL DRAIN BACK INTO THE INFLUENT CHANNEL.
- COMBUSTIBLE GAS DETECTOR LOCATED IN THE SCREENINGS CHANNEL VAULT AREA.
- LEVEL TRANSMITTER LOCATED IN SCREENINGS VENDOR CONTROL PANEL CP-12004A OR CP-12004B.

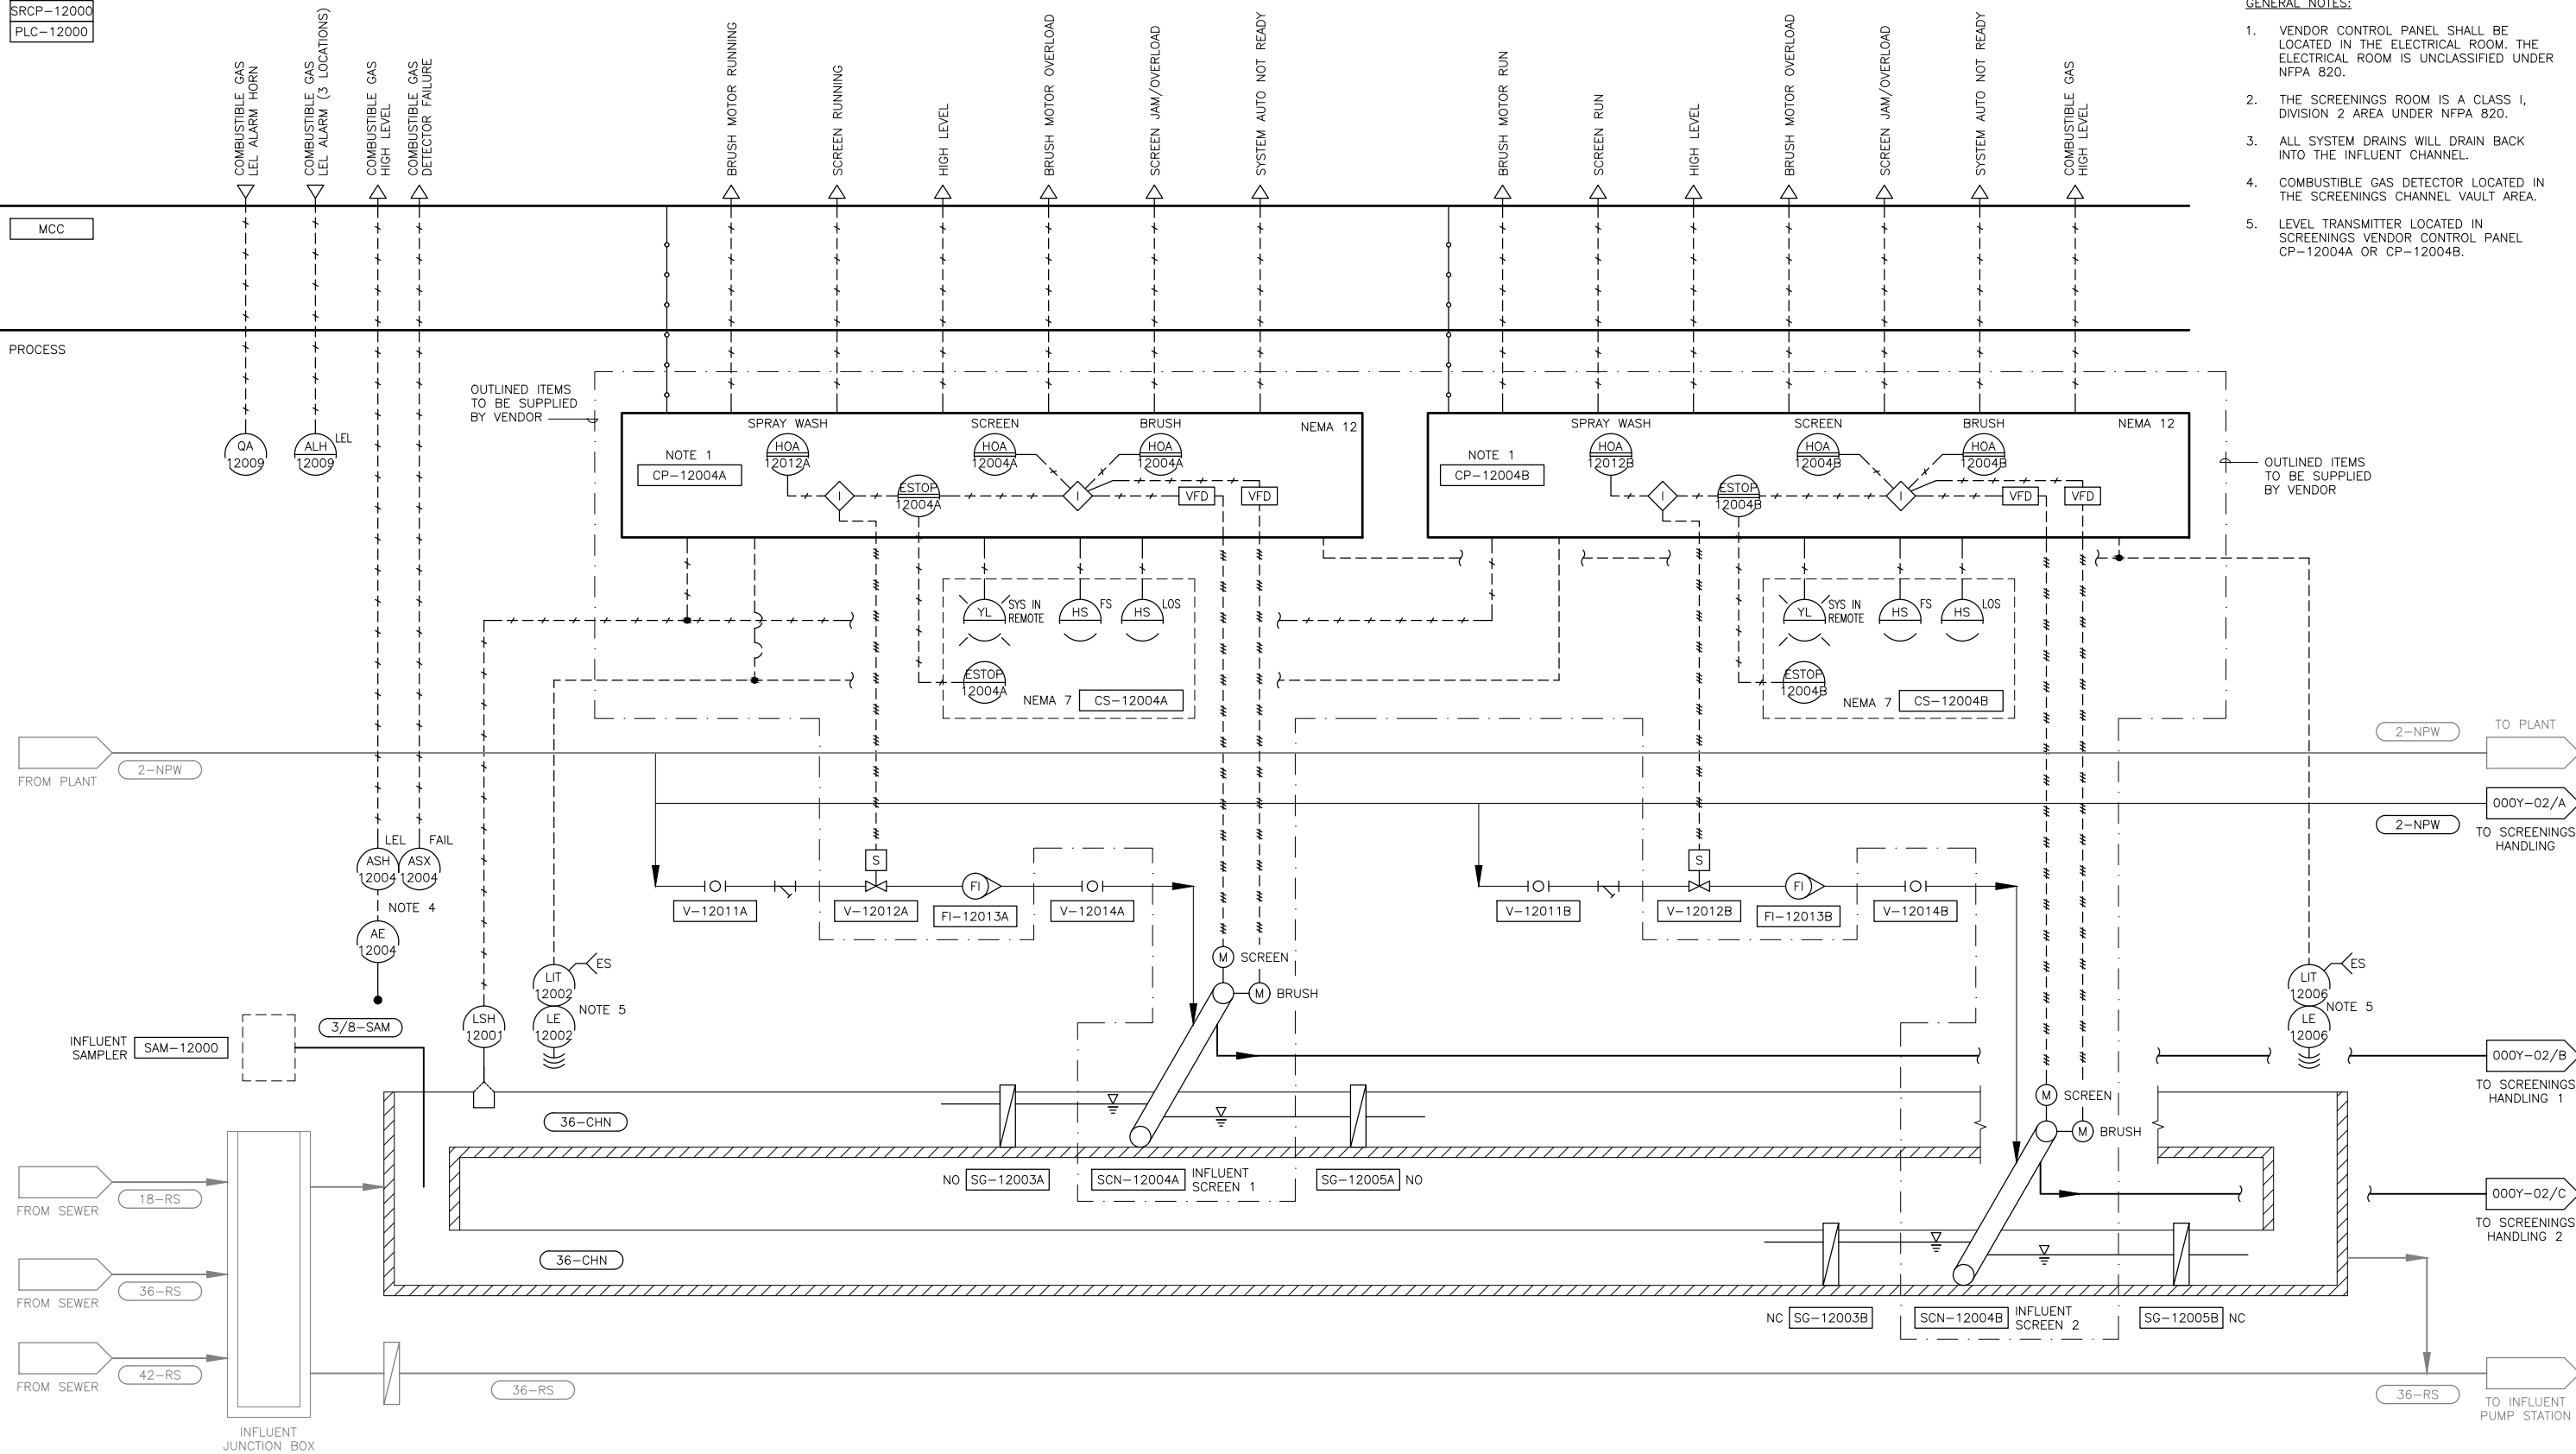


| | | |
|-------|----------|----------------------------------|
| | | |
| | | |
| | | |
| | | |
| 1 | APR 2014 | RECORD DRAWINGS |
| 0 | NOV 2011 | ISSUE FOR CONSTRUCTION SUBMITTAL |
| ISSUE | DATE | DESCRIPTION |

| | |
|-----------------|---------------|
| PROJECT MANAGER | A. MEILLEUR |
| DESIGNED | S. CHILUKURI |
| DRAWN | E. SWANSON |
| | B. LILLY |
| | P. MCCLINTOCK |
| CHECKED | J. KOCH |
| | E. SWANSON |
| PROJECT NUMBER | 171097 |

ELECTRONIC SEAL AND
SIGNATURE HAS BEEN
REMOVED. THIS MEDIA
SHOULD NOT BE CONSIDERED
A CERTIFIED DOCUMENT



SCREENINGS BUILDING
INFLUENT SCREENS
PROCESS AND INSTRUMENTATION DIAGRAM

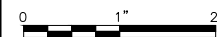

| | |
|----------|--------------|
| FILENAME | 000Y-01.dwg |
| SCALE | NOT TO SCALE |

| | |
|-------|---------|
| SHEET | 000Y-01 |
|-------|---------|

ELECTRONIC MEDIA DISCLAIMER: THIS ELECTRONIC MEDIA PROVIDED BY HDR ENGINEERING, INC. IS SUBJECT TO AN ELECTRONIC MEDIA RELEASE. ALL USE AND RE-USE OF THIS MEDIA IS SUBJECT TO THE TERMS AND CONDITIONS OF THE RELEASE.


SCREENINGS BUILDING
CONTROL PANEL
SRCP-12000
PLC-12000

MCC

PROCESS

GENERAL NOTES:

- VENDOR CONTROL PANEL SHALL BE LOCATED IN THE ELECTRICAL ROOM. THE ELECTRICAL ROOM IS UNCLASSIFIED UNDER NFPA 820.
- THE SCREENINGS ROOM IS A CLASS I, DIVISION 2 AREA UNDER NFPA 820.
- ALL SYSTEM DRAINS WILL DRAIN BACK INTO THE INFLUENT CHANNEL.

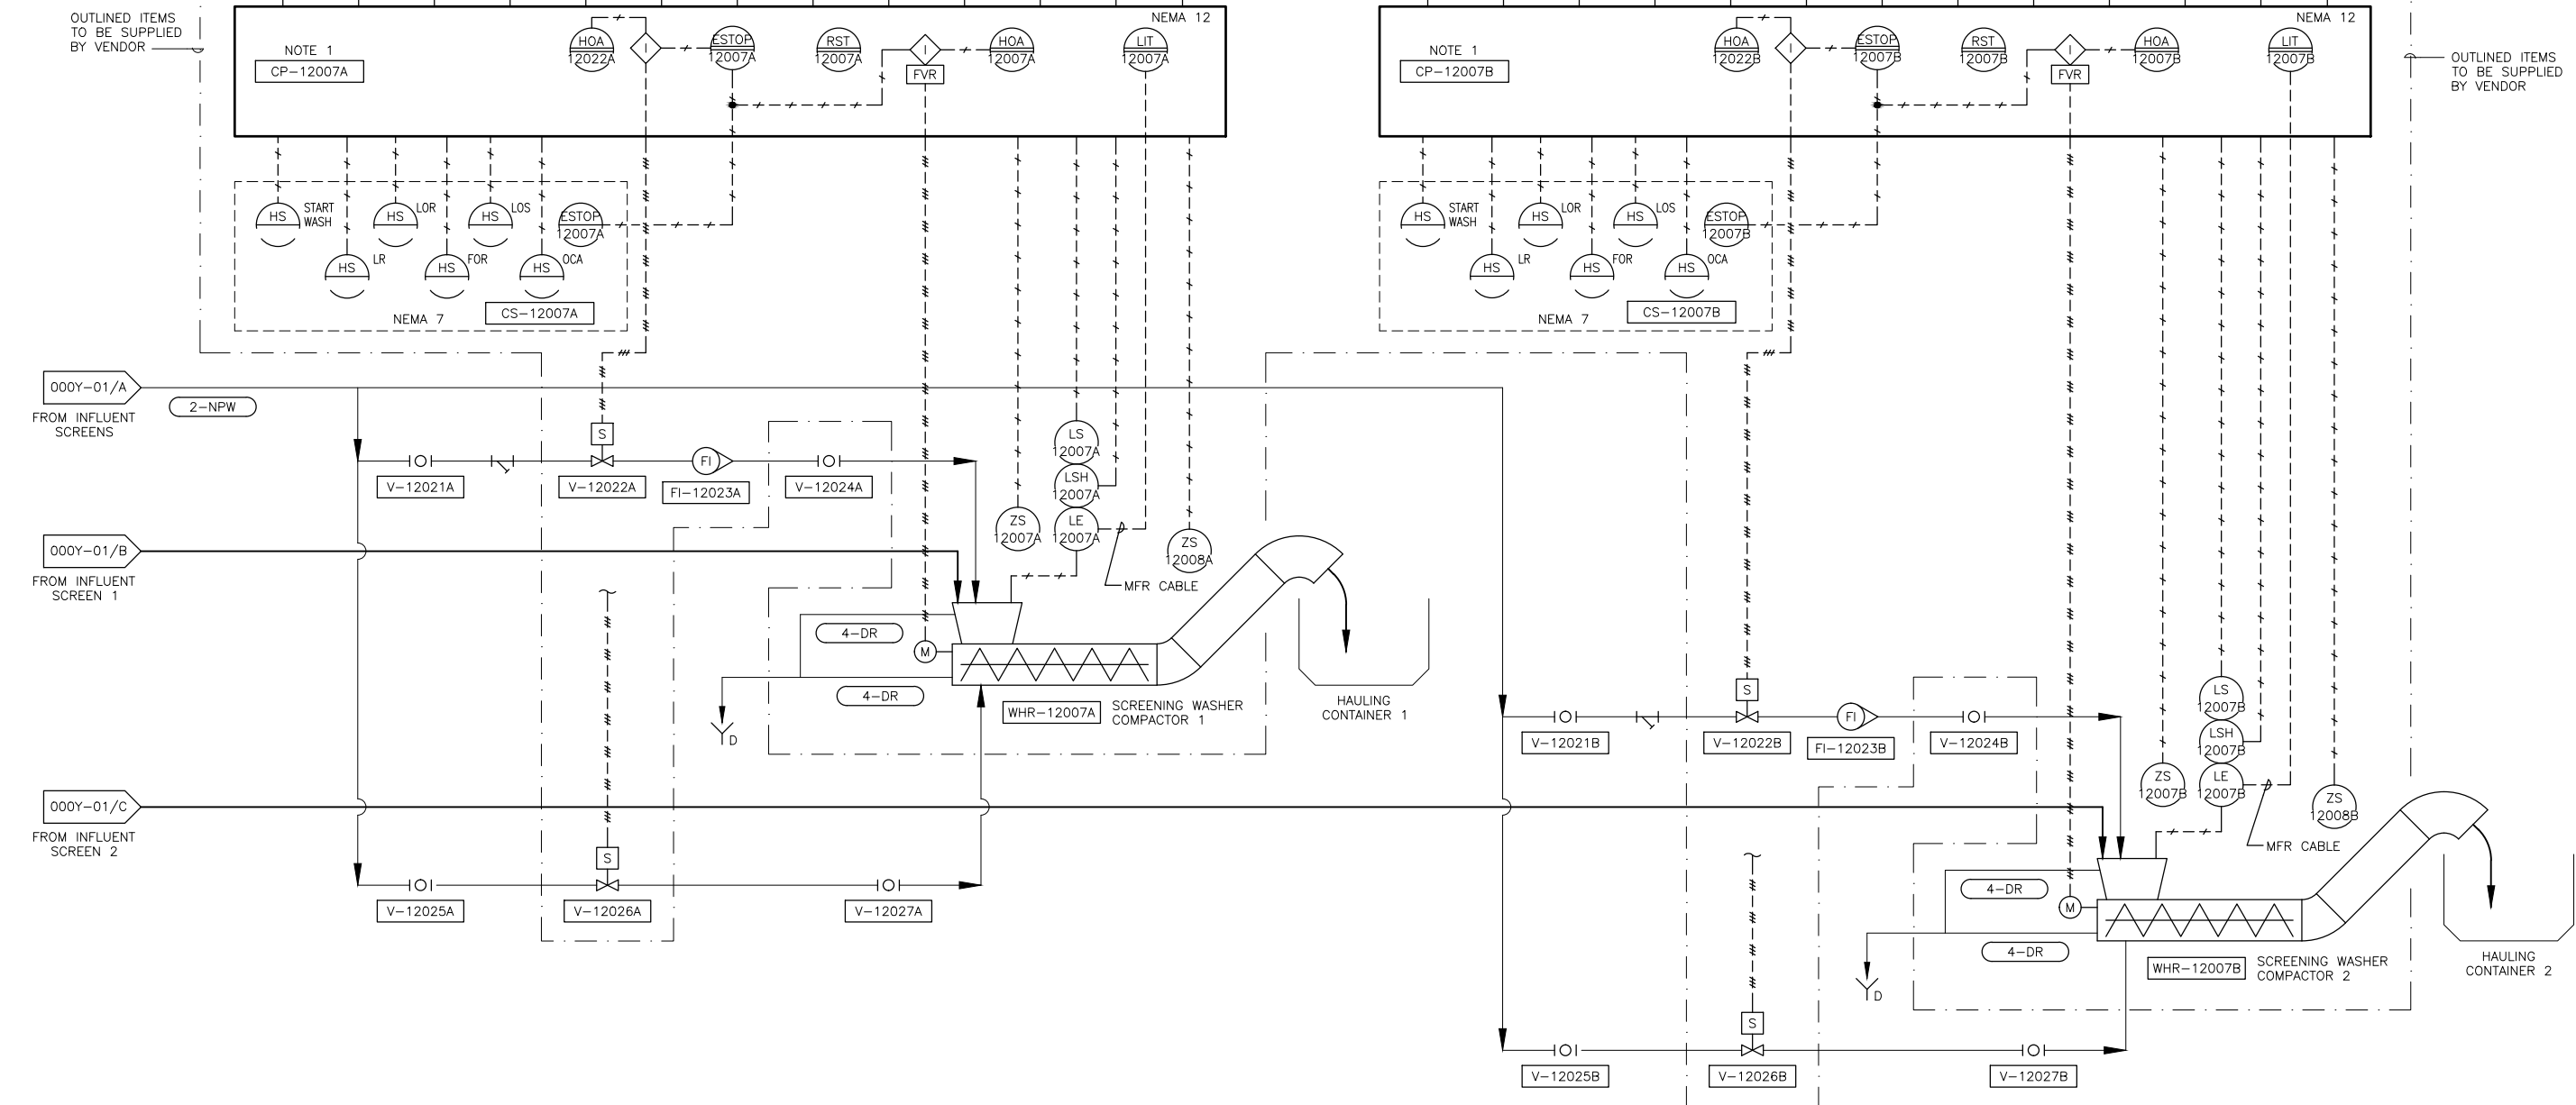


| ISSUE | DATE | DESCRIPTION |
|-------|----------|----------------------------------|
| 1 | APR 2014 | RECORD DRAWINGS |
| 0 | NOV 2011 | ISSUE FOR CONSTRUCTION SUBMITTAL |

| | |
|-----------------|---------------|
| PROJECT MANAGER | A. MEILLEUR |
| DESIGNED | S. CHILUKURI |
| DRAWN | E. SWANSON |
| CHECKED | B. LILLY |
| | P. MCCLINTOCK |
| | J. KOCH |
| | E. SWANSON |
| PROJECT NUMBER | 171097 |

ELECTRONIC SEAL AND
SIGNATURE HAS BEEN
REMOVED. THIS MEDIA
SHOULD NOT BE CONSIDERED
A CERTIFIED DOCUMENT



SCREENINGS BUILDING
WASHER/COMPACTOR
PROCESS AND INSTRUMENTATION DIAGRAM

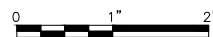

| | |
|----------|--------------|
| FILENAME | 000Y-02.dwg |
| SCALE | NOT TO SCALE |


| | |
|-------|---------|
| SHEET | 000Y-02 |
|-------|---------|

ELECTRONIC MEDIA DISCLAIMER: THIS ELECTRONIC MEDIA PROVIDED BY HDR ENGINEERING, INC. IS SUBJECT TO AN ELECTRONIC MEDIA RELEASE. ALL USE AND RE-USE OF THIS MEDIA IS SUBJECT TO THE TERMS AND CONDITIONS OF THE RELEASE.

PLC IN SCP - SOLIDS HANDLING CONTROL PANEL

MCC-4

PROCESS

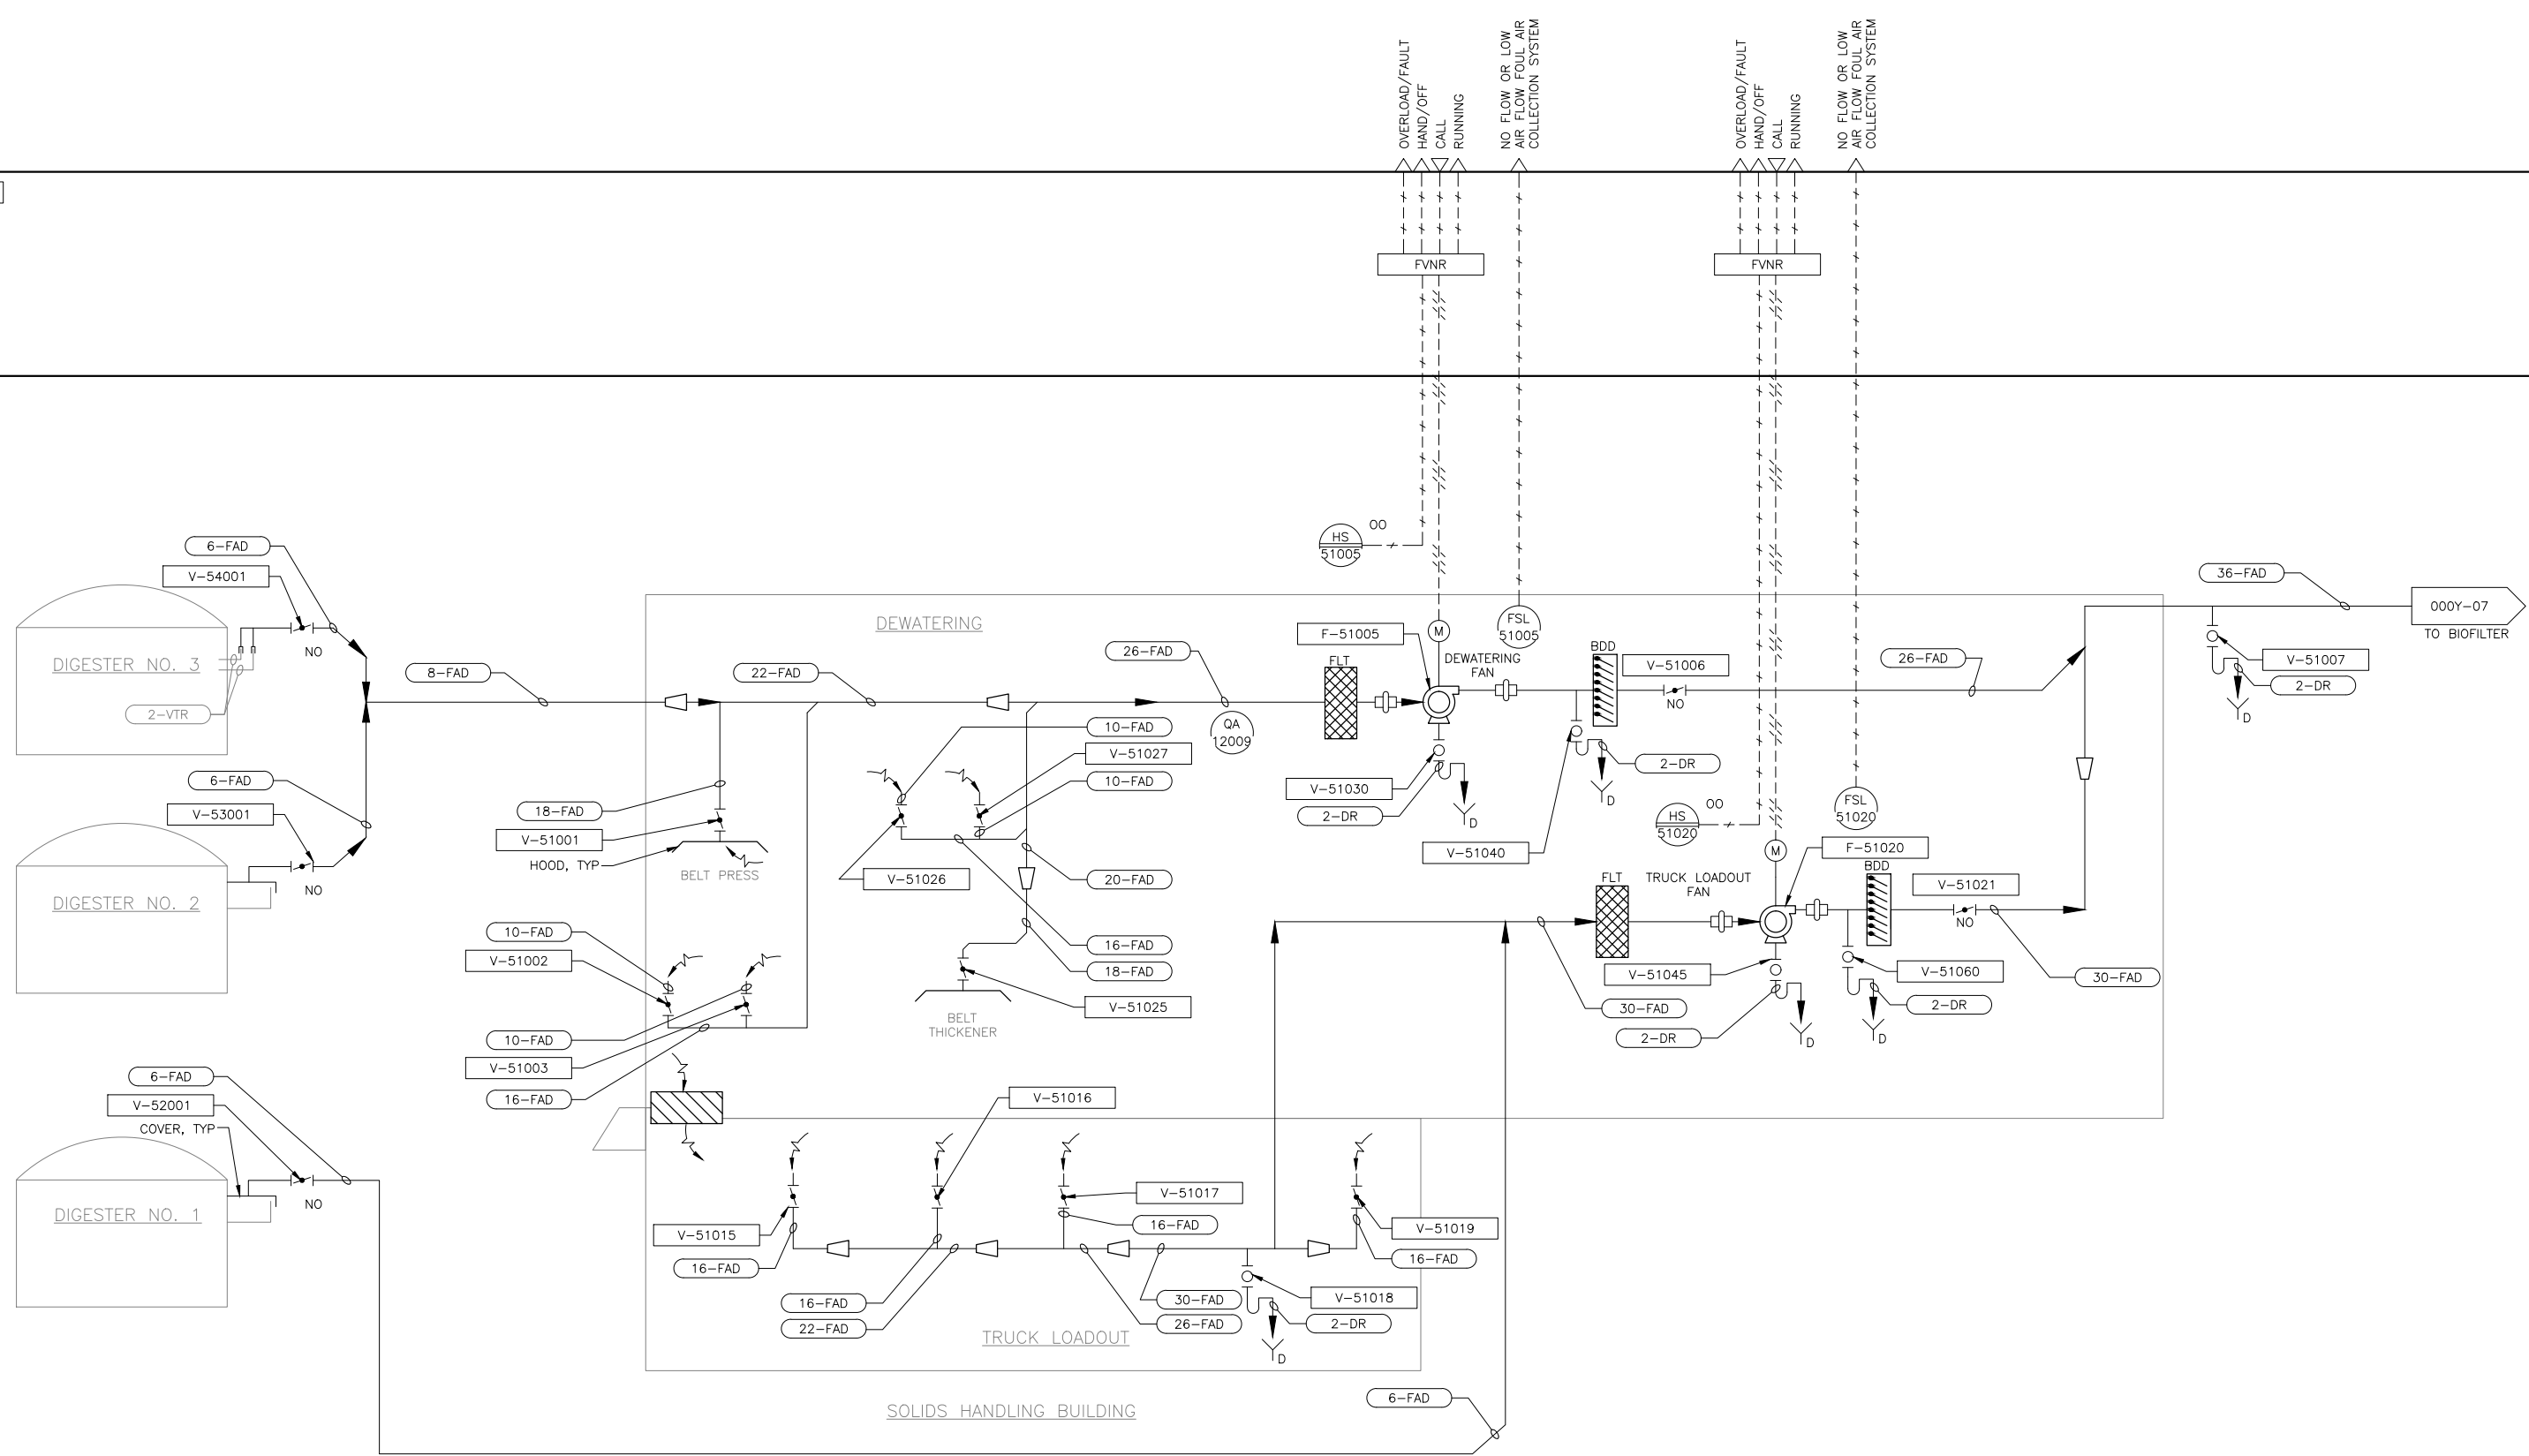

| | | |
|-------|----------|----------------------------------|
| | | |
| | | |
| 1 | APR 2014 | RECORD DRAWINGS |
| 0 | NOV 2011 | ISSUE FOR CONSTRUCTION SUBMITTAL |
| ISSUE | DATE | DESCRIPTION |

| | |
|-----------------|---------------|
| PROJECT MANAGER | A. MEILLEUR |
| DESIGNED | HARMON/MANION |
| DRAWN | H. FANCHER |
| | P. MCCLINTOCK |
| CHECKED | J. KOCH |
| | E. SWANSON |
| PROJECT NUMBER | 171097 |

ELECTRONIC SEAL AND
SIGNATURE HAS BEEN
REMOVED. THIS MEDIA
SHOULD NOT BE CONSIDERED
A CERTIFIED DOCUMENT



**SOLIDS HANDLING FACILITY
FOUL AIR COLLECTION
PROCESS AND INSTRUMENTATION DIAGRAM**

0 1" 2"


| | | |
|----------|-------------|----------------|
| FILENAME | 000Y-03.dwg | SHEET |
| SCALE | NONE | 000Y-03 |

ELECTRONIC MEDIA DISCLAIMER: THIS ELECTRONIC MEDIA PROVIDED BY HDR ENGINEERING, INC. IS SUBJECT TO AN ELECTRONIC MEDIA RELEASE. ALL USE AND RE-USE OF THIS MEDIA IS SUBJECT TO THE TERMS AND CONDITIONS OF THE RELEASE.

PLC-12000 IN NEW SRCP-SCREENINGS BUILDING CONTROL PANEL

MCC-12006E

PROCESS

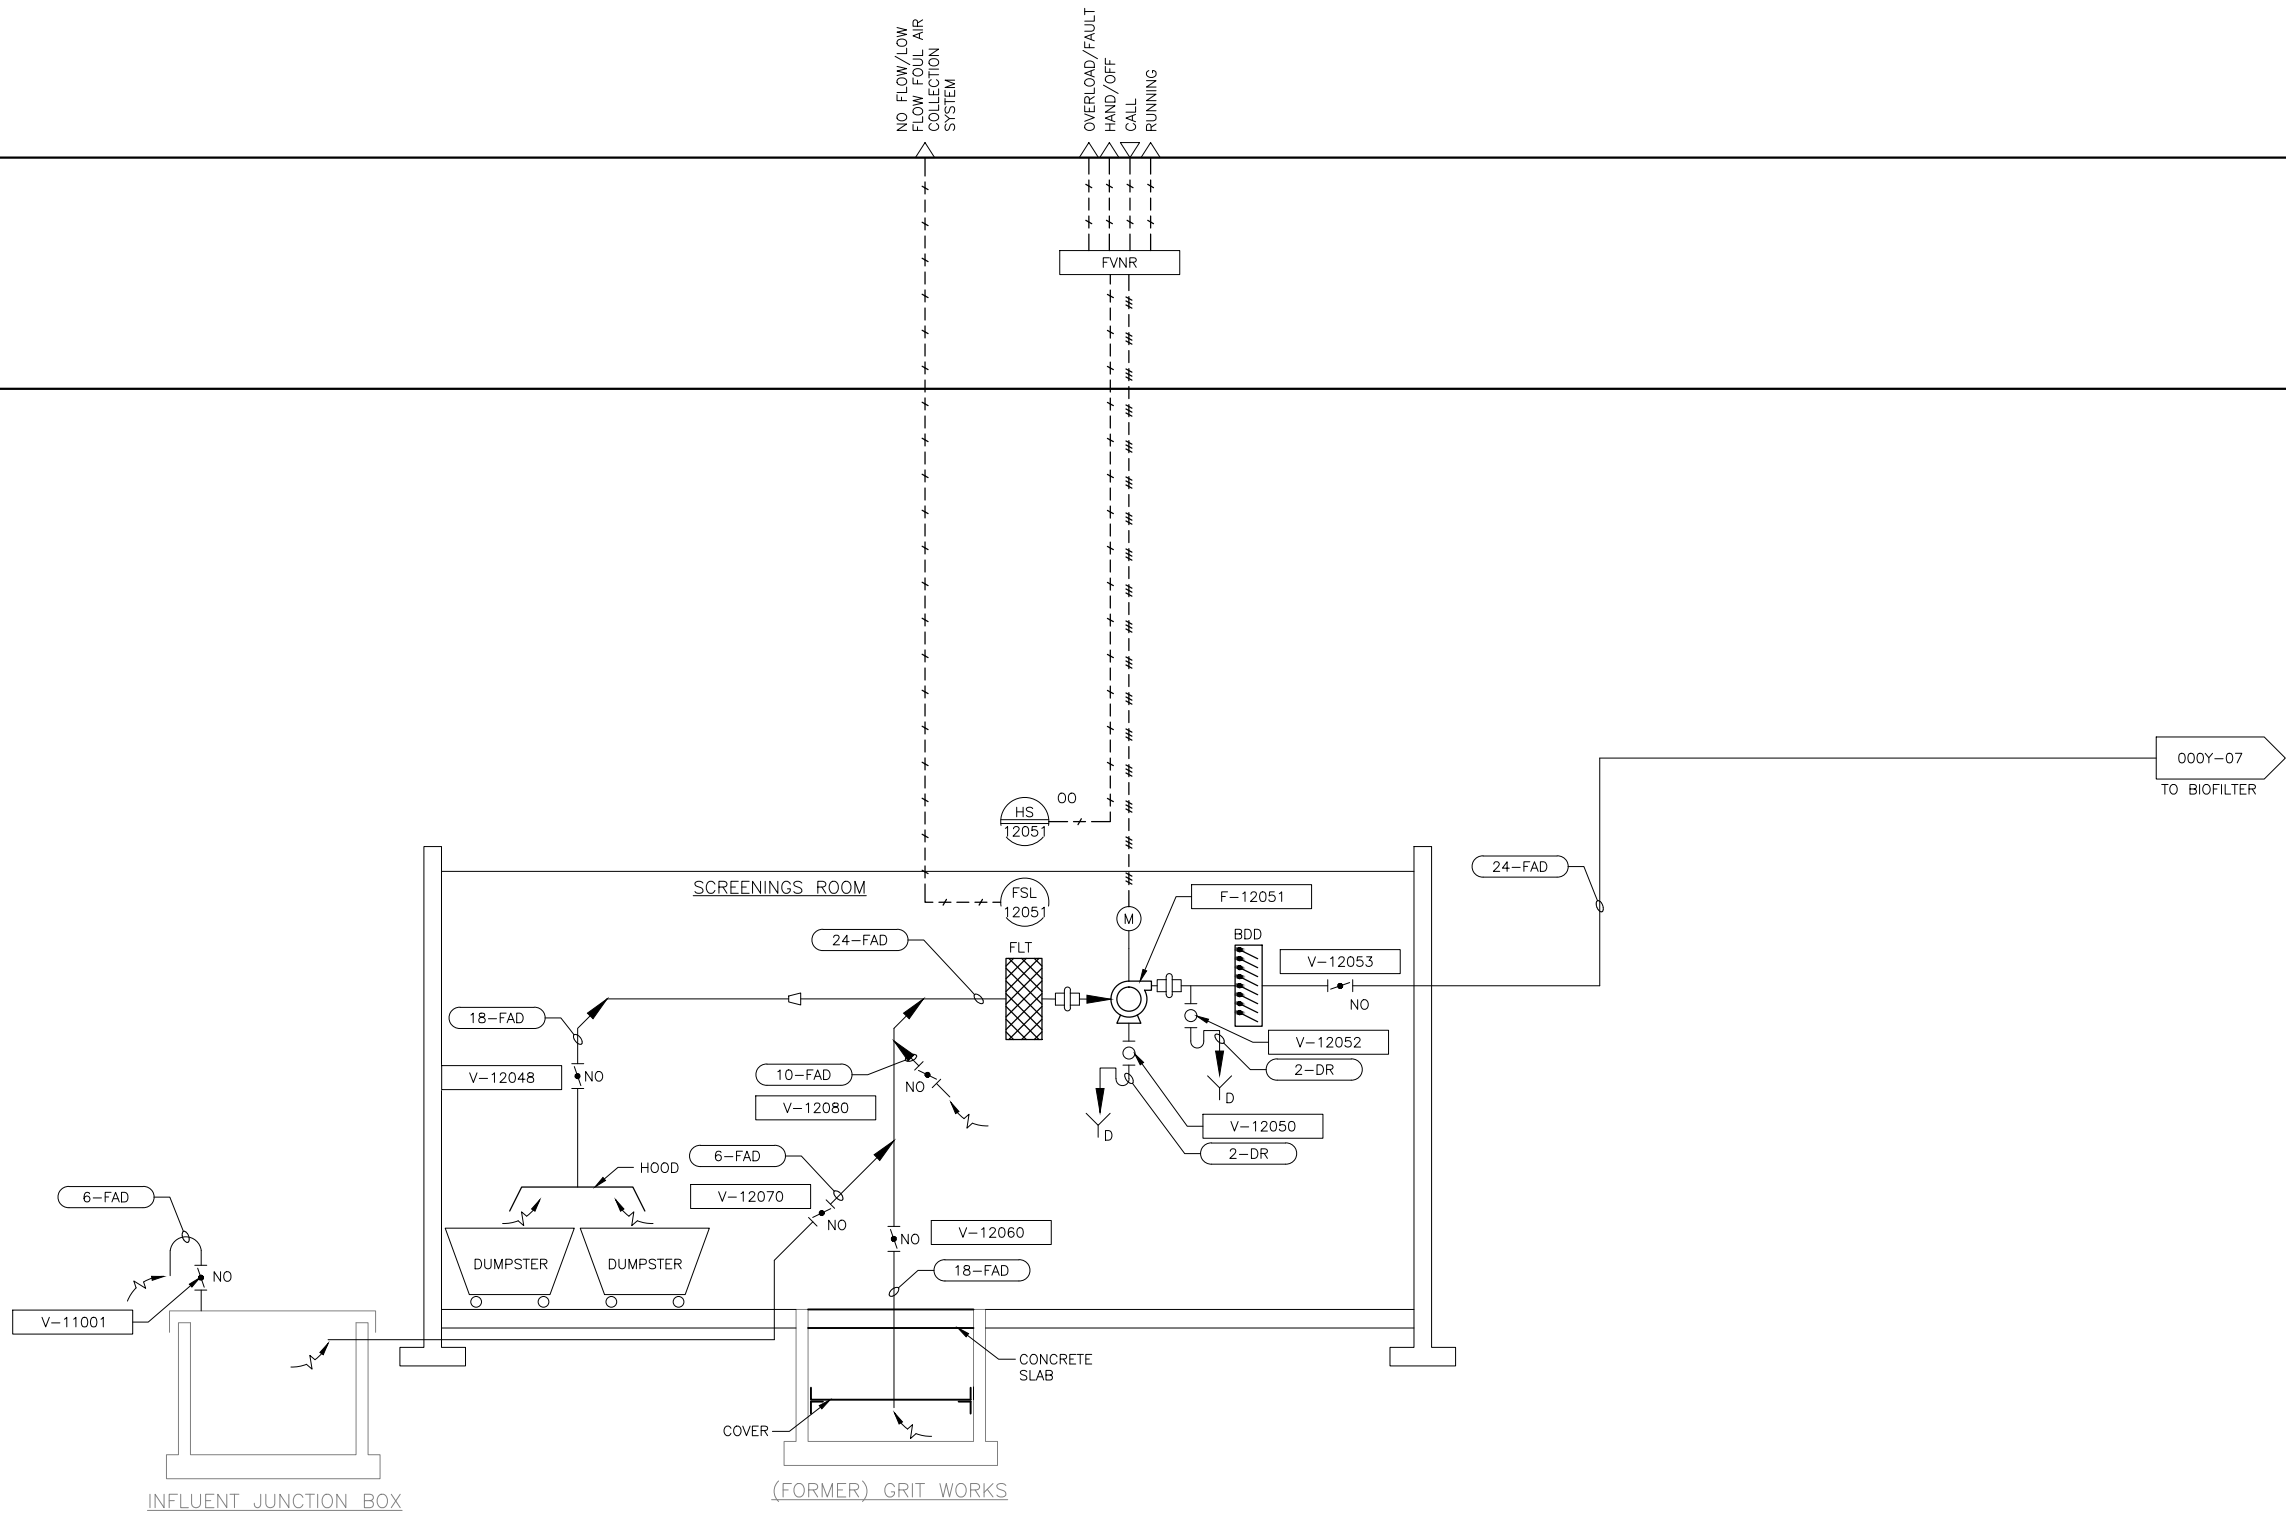

| | | |
|-------|----------|----------------------------------|
| | | |
| | | |
| | | |
| | | |
| 1 | APR 2014 | RECORD DRAWINGS |
| 0 | NOV 2011 | ISSUE FOR CONSTRUCTION SUBMITTAL |
| ISSUE | DATE | DESCRIPTION |

| | |
|-----------------|---------------|
| PROJECT MANAGER | A. MEILLEUR |
| DESIGNED | HARMON/MANION |
| DRAWN | H. FANCHER |
| | P. MCCLINTOCK |
| CHECKED | J. KOCH |
| | E. SWANSON |
| PROJECT NUMBER | 171097 |

ELECTRONIC SEAL AND
SIGNATURE HAS BEEN
REMOVED. THIS MEDIA
SHOULD NOT BE CONSIDERED
A CERTIFIED DOCUMENT



SCREENINGS BUILDING
FOUL AIR COLLECTION
PROCESS AND INSTRUMENTATION DIAGRAM



| | |
|----------|-------------|
| FILENAME | 000Y-04.dwg |
| SCALE | NONE |


| | |
|-------|---------|
| SHEET | 000Y-04 |
|-------|---------|

ELECTRONIC MEDIA DISCLAIMER: THIS ELECTRONIC MEDIA PROVIDED BY HDR ENGINEERING, INC. IS SUBJECT TO AN ELECTRONIC MEDIA RELEASE. ALL USE AND RE-USE OF THIS MEDIA IS SUBJECT TO THE TERMS AND CONDITIONS OF THE RELEASE.

PLC IN HCP=HEADWORKS CONTROL PANEL

MCC-4

PROCESS

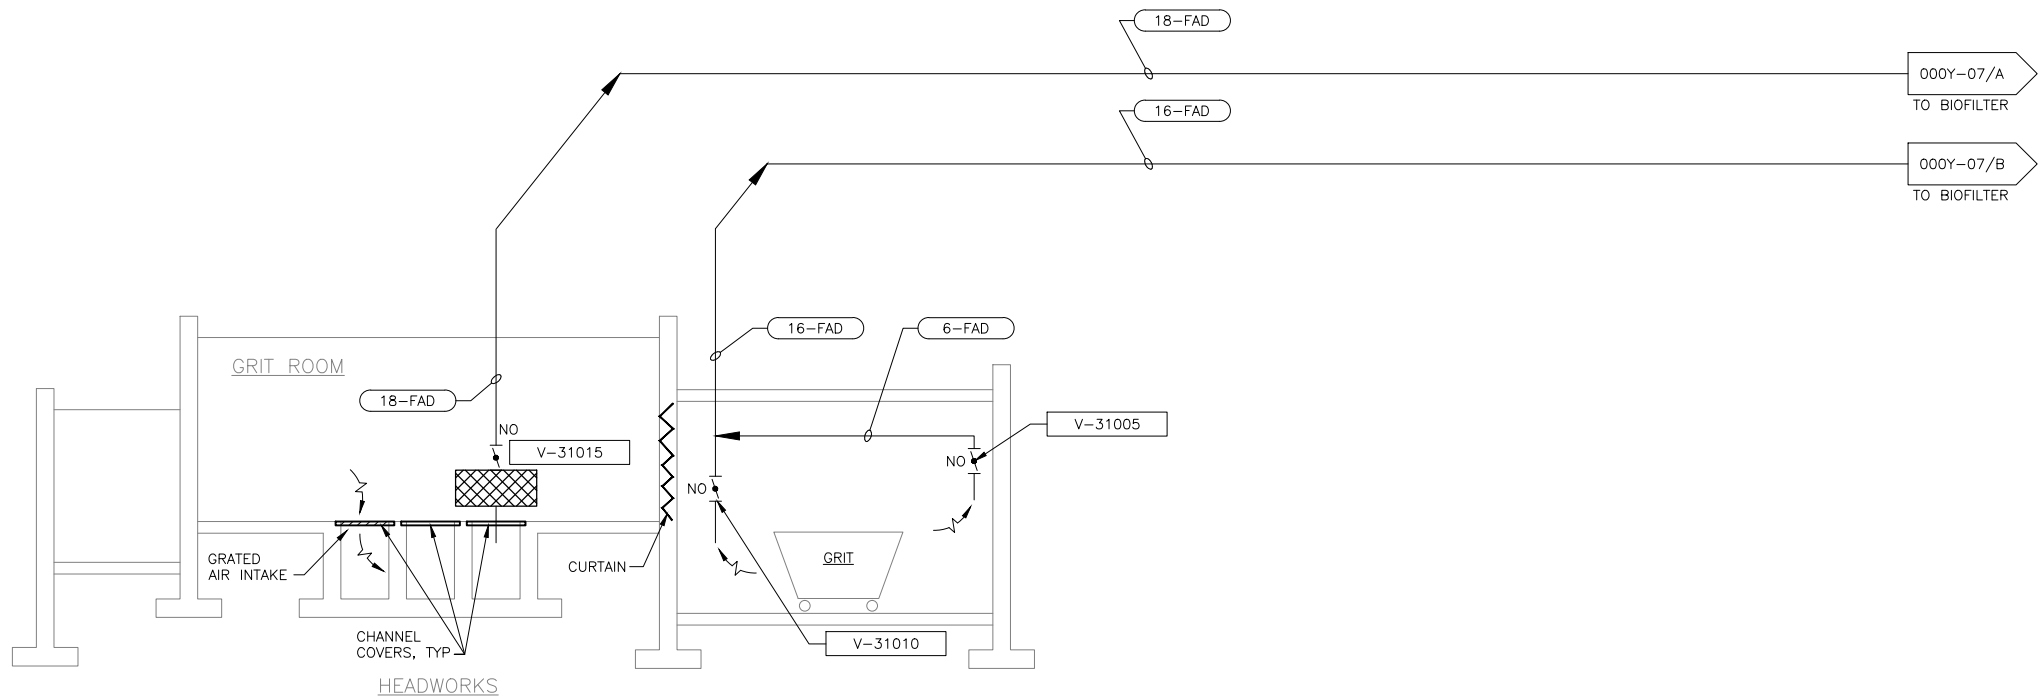


| | | |
|-------|----------|----------------------------------|
| | | |
| | | |
| | | |
| | | |
| 1 | APR 2014 | RECORD DRAWINGS |
| 0 | NOV 2011 | ISSUE FOR CONSTRUCTION SUBMITTAL |
| ISSUE | DATE | DESCRIPTION |

| | |
|-----------------|---------------|
| PROJECT MANAGER | A. MEILLEUR |
| DESIGNED | HARMON/MANION |
| DRAWN | H. FANCHER |
| CHECKED | J. KOCH |
| PROJECT NUMBER | 171097 |

ELECTRONIC SEAL AND
SIGNATURE HAS BEEN
REMOVED. THIS MEDIA
SHOULD NOT BE CONSIDERED
A CERTIFIED DOCUMENT



BIOFILTER FAN BUILDING
FOUL AIR COLLECTION
PROCESS AND INSTRUMENTATION DIAGRAM

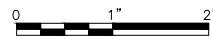

| | |
|----------|-------------|
| FILENAME | 000Y-05.dwg |
| SCALE | NONE |

| |
|---------|
| SHEET |
| 000Y-05 |


ELECTRONIC MEDIA DISCLAIMER: THIS ELECTRONIC MEDIA PROVIDED BY HDR ENGINEERING, INC. IS SUBJECT TO AN ELECTRONIC MEDIA RELEASE. ALL USE AND RE-USE OF THIS MEDIA IS SUBJECT TO THE TERMS AND CONDITIONS OF THE RELEASE.

PLC-12000 IN NEW SRCP-SCREENING BUILDING CONTROL PANEL

MCC-12006

MCC-12006E

PROCESS

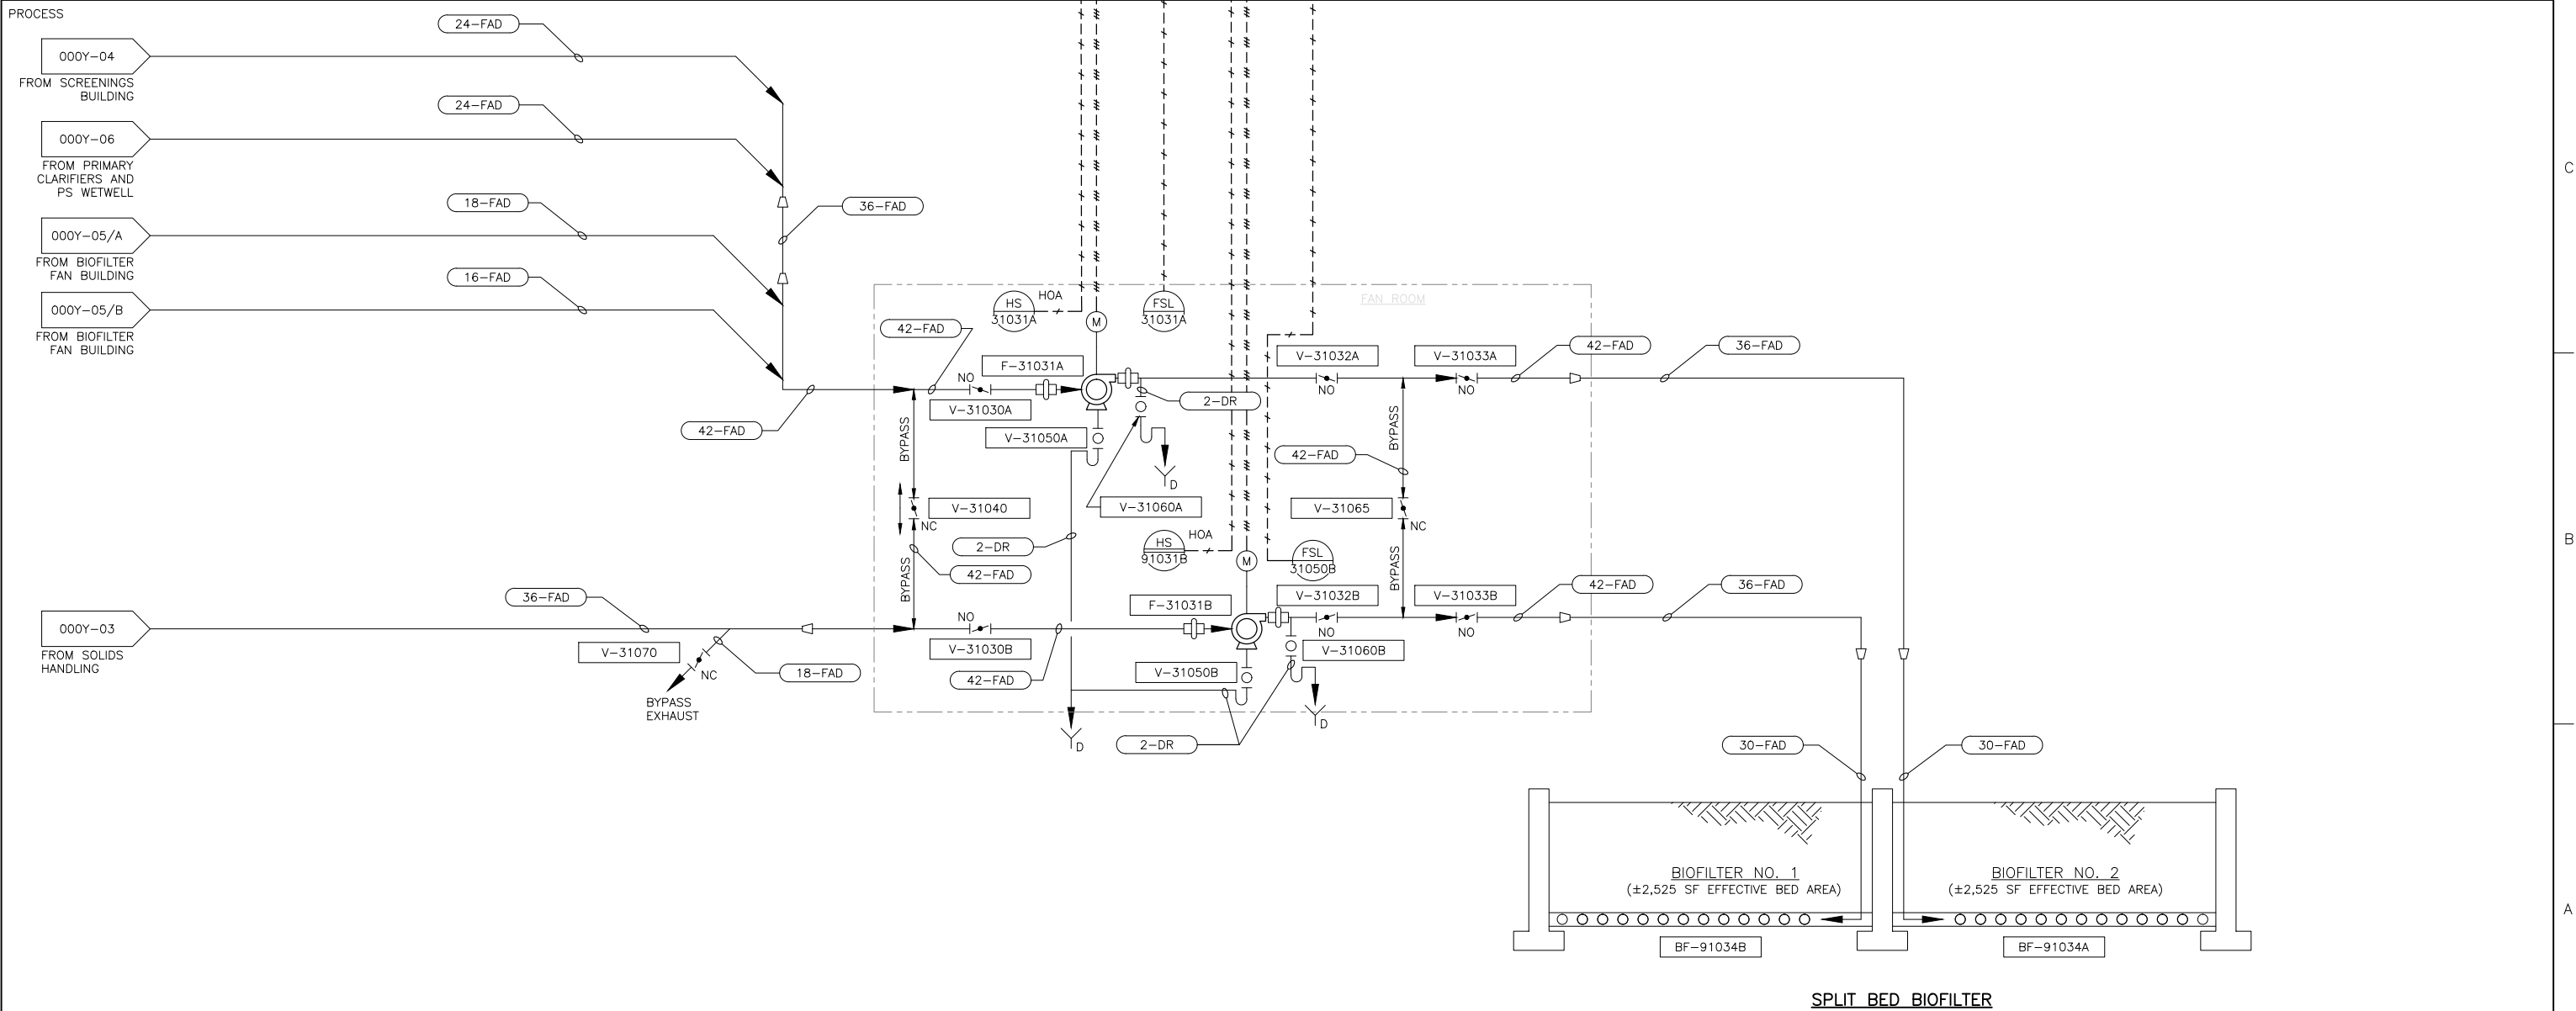


| | | |
|-------|----------|----------------------------------|
| | | |
| | | |
| | | |
| | | |
| 1 | APR 2014 | RECORD DRAWINGS |
| 0 | NOV 2011 | ISSUE FOR CONSTRUCTION SUBMITTAL |
| ISSUE | DATE | DESCRIPTION |

| | |
|-----------------|---------------|
| PROJECT MANAGER | A. MEILLEUR |
| DESIGNED | HARMON/MANION |
| DRAWN | H. FANCHER |
| | P. MCCLINTOCK |
| CHECKED | J. KOCH |
| | E. SWANSON |
| PROJECT NUMBER | 171097 |

ELECTRONIC SEAL AND
SIGNATURE HAS BEEN
REMOVED. THIS MEDIA
SHOULD NOT BE CONSIDERED
A CERTIFIED DOCUMENT




BIOFILTER
FOUL AIR COLLECTION
PROCESS AND INSTRUMENTATION DIAGRAM

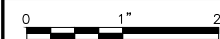

| | |
|----------|-------------|
| FILENAME | 000Y-07.dwg |
| SCALE | NONE |

| | |
|-------|---------|
| SHEET | 000Y-07 |
|-------|---------|

ELECTRONIC MEDIA DISCLAIMER: THIS ELECTRONIC MEDIA PROVIDED BY HDR ENGINEERING, INC. IS SUBJECT TO AN ELECTRONIC MEDIA RELEASE. ALL USE AND RE-USE OF THIS MEDIA IS SUBJECT TO THE TERMS AND CONDITIONS OF THE RELEASE.

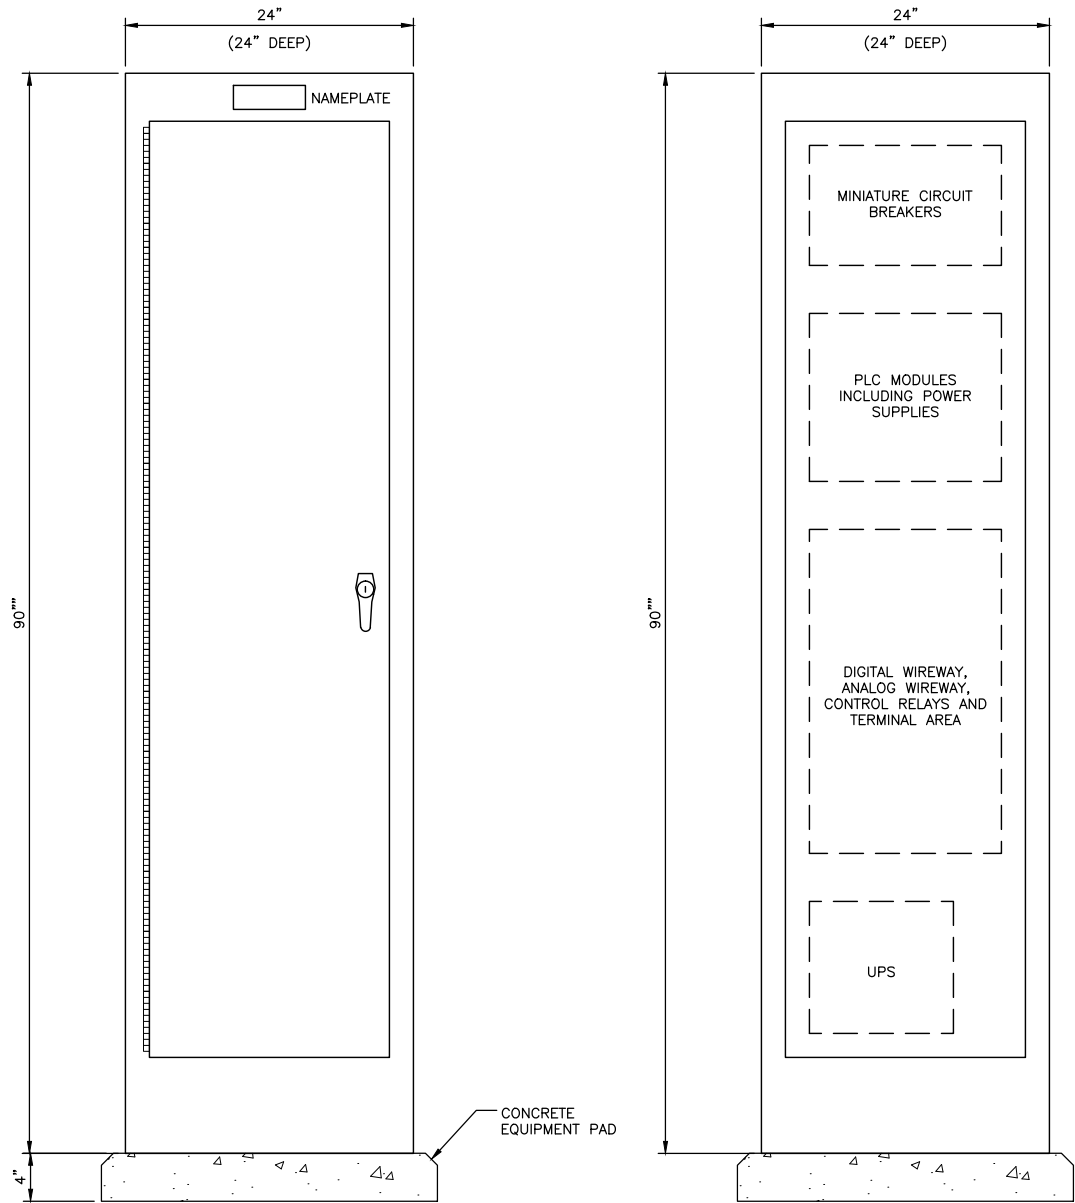


FRONT VIEW ELEVATION – EXTERIOR

FRONT VIEW ELEVATION – INTERNAL

CONTROL PANEL SRCP-12000
SCALE: NONE

| CONTROL PANEL SRCP-12000 SCHEDULE | | |
|-----------------------------------|-------------------------------|---------------|
| PANEL IDENTIFICATION | NAMEPLATE LEGEND | NOMINAL WIDTH |
| SRCP | SCREENINGS BUILDING PLC PANEL | 24" |
| ESP | ESP ETHERNET SWITCH PANEL | 24" |
| | | |

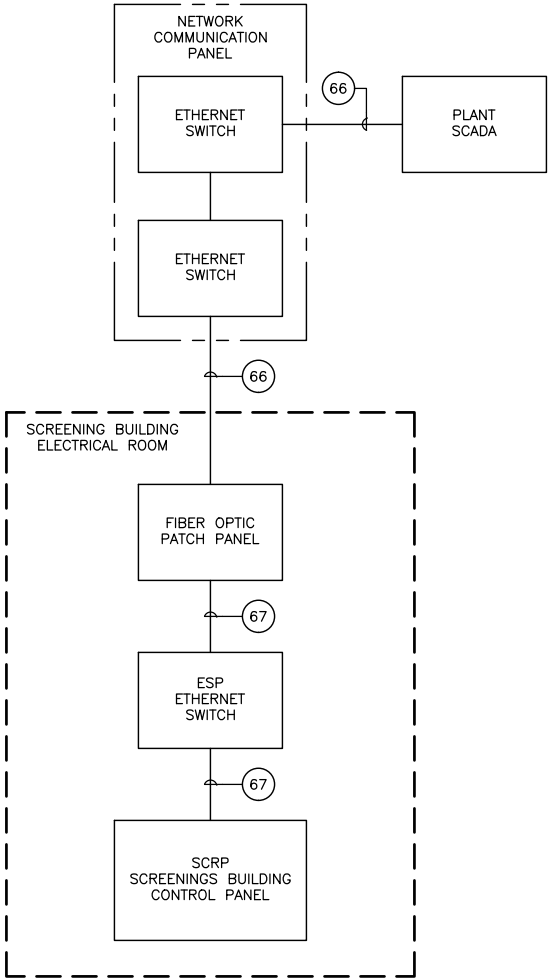

NETWORK INTERFACE BLOCK DIAGRAM

- NOTES:**
1. SECURE CONTROL PANEL TO CONCRETE WITH CONCRETE ANCHORS. SEE DESIGN SHEET 000E-10, DETAIL 8.
 2. PANEL ENCLOSURE SHALL BE 24" DEEP. PANEL WIDTH SHALL BE AS REQUIRED TO ACCOMMODATE ALL PANEL COMPONENTS AND WIRE TERMINATIONS. ALL DIMENSIONS ARE NOMINAL.
 3. REFER TO BLOCK DIAGRAMS AND SPECIFICATIONS FOR MAJOR PANEL COMPONENTS.
 4. REFER TO P&IDs AND I/O SUMMARY LIST FOR SPECIFIC I/O POINTS AND CIRCUITS REQUIRED FOR THIS PANEL.
 5. REFER TO PLC I/O WIRING, TYPICAL DIAGRAM FOR PLC I/O WIRING ARRANGEMENTS.
 6. PROVIDE A MINI-CIRCUIT BREAKER FOR EACH DISCRETE I/O MODULE.



| ISSUE | DATE | DESCRIPTION |
|-------|----------|----------------------------------|
| 1 | APR 2014 | RECORD DRAWINGS |
| 0 | NOV 2011 | ISSUE FOR CONSTRUCTION SUBMITTAL |

| | |
|-----------------|---------------|
| PROJECT MANAGER | A. MEILLEUR |
| DESIGNED | I. RINCON |
| DRAWN | P. McCLINTOCK |
| CHECKED | J. KOCH |
| | E. SWANSON |
| PROJECT NUMBER | 171097 |

ELECTRONIC SEAL AND
SIGNATURE HAS BEEN
REMOVED. THIS MEDIA
SHOULD NOT BE CONSIDERED
A CERTIFIED DOCUMENT




CONTROL PANEL
ELEVATION



| | |
|----------|-------------|
| FILENAME | 000Y-08.dwg |
| SCALE | NOTED |

SHEET
000Y-08

ELECTRONIC MEDIA DISCLAIMER: THIS ELECTRONIC MEDIA PROVIDED BY HDR ENGINEERING, INC. IS SUBJECT TO AN ELECTRONIC MEDIA RELEASE. ALL USE AND RE-USE OF THIS MEDIA IS SUBJECT TO THE TERMS AND CONDITIONS OF THE RELEASE.

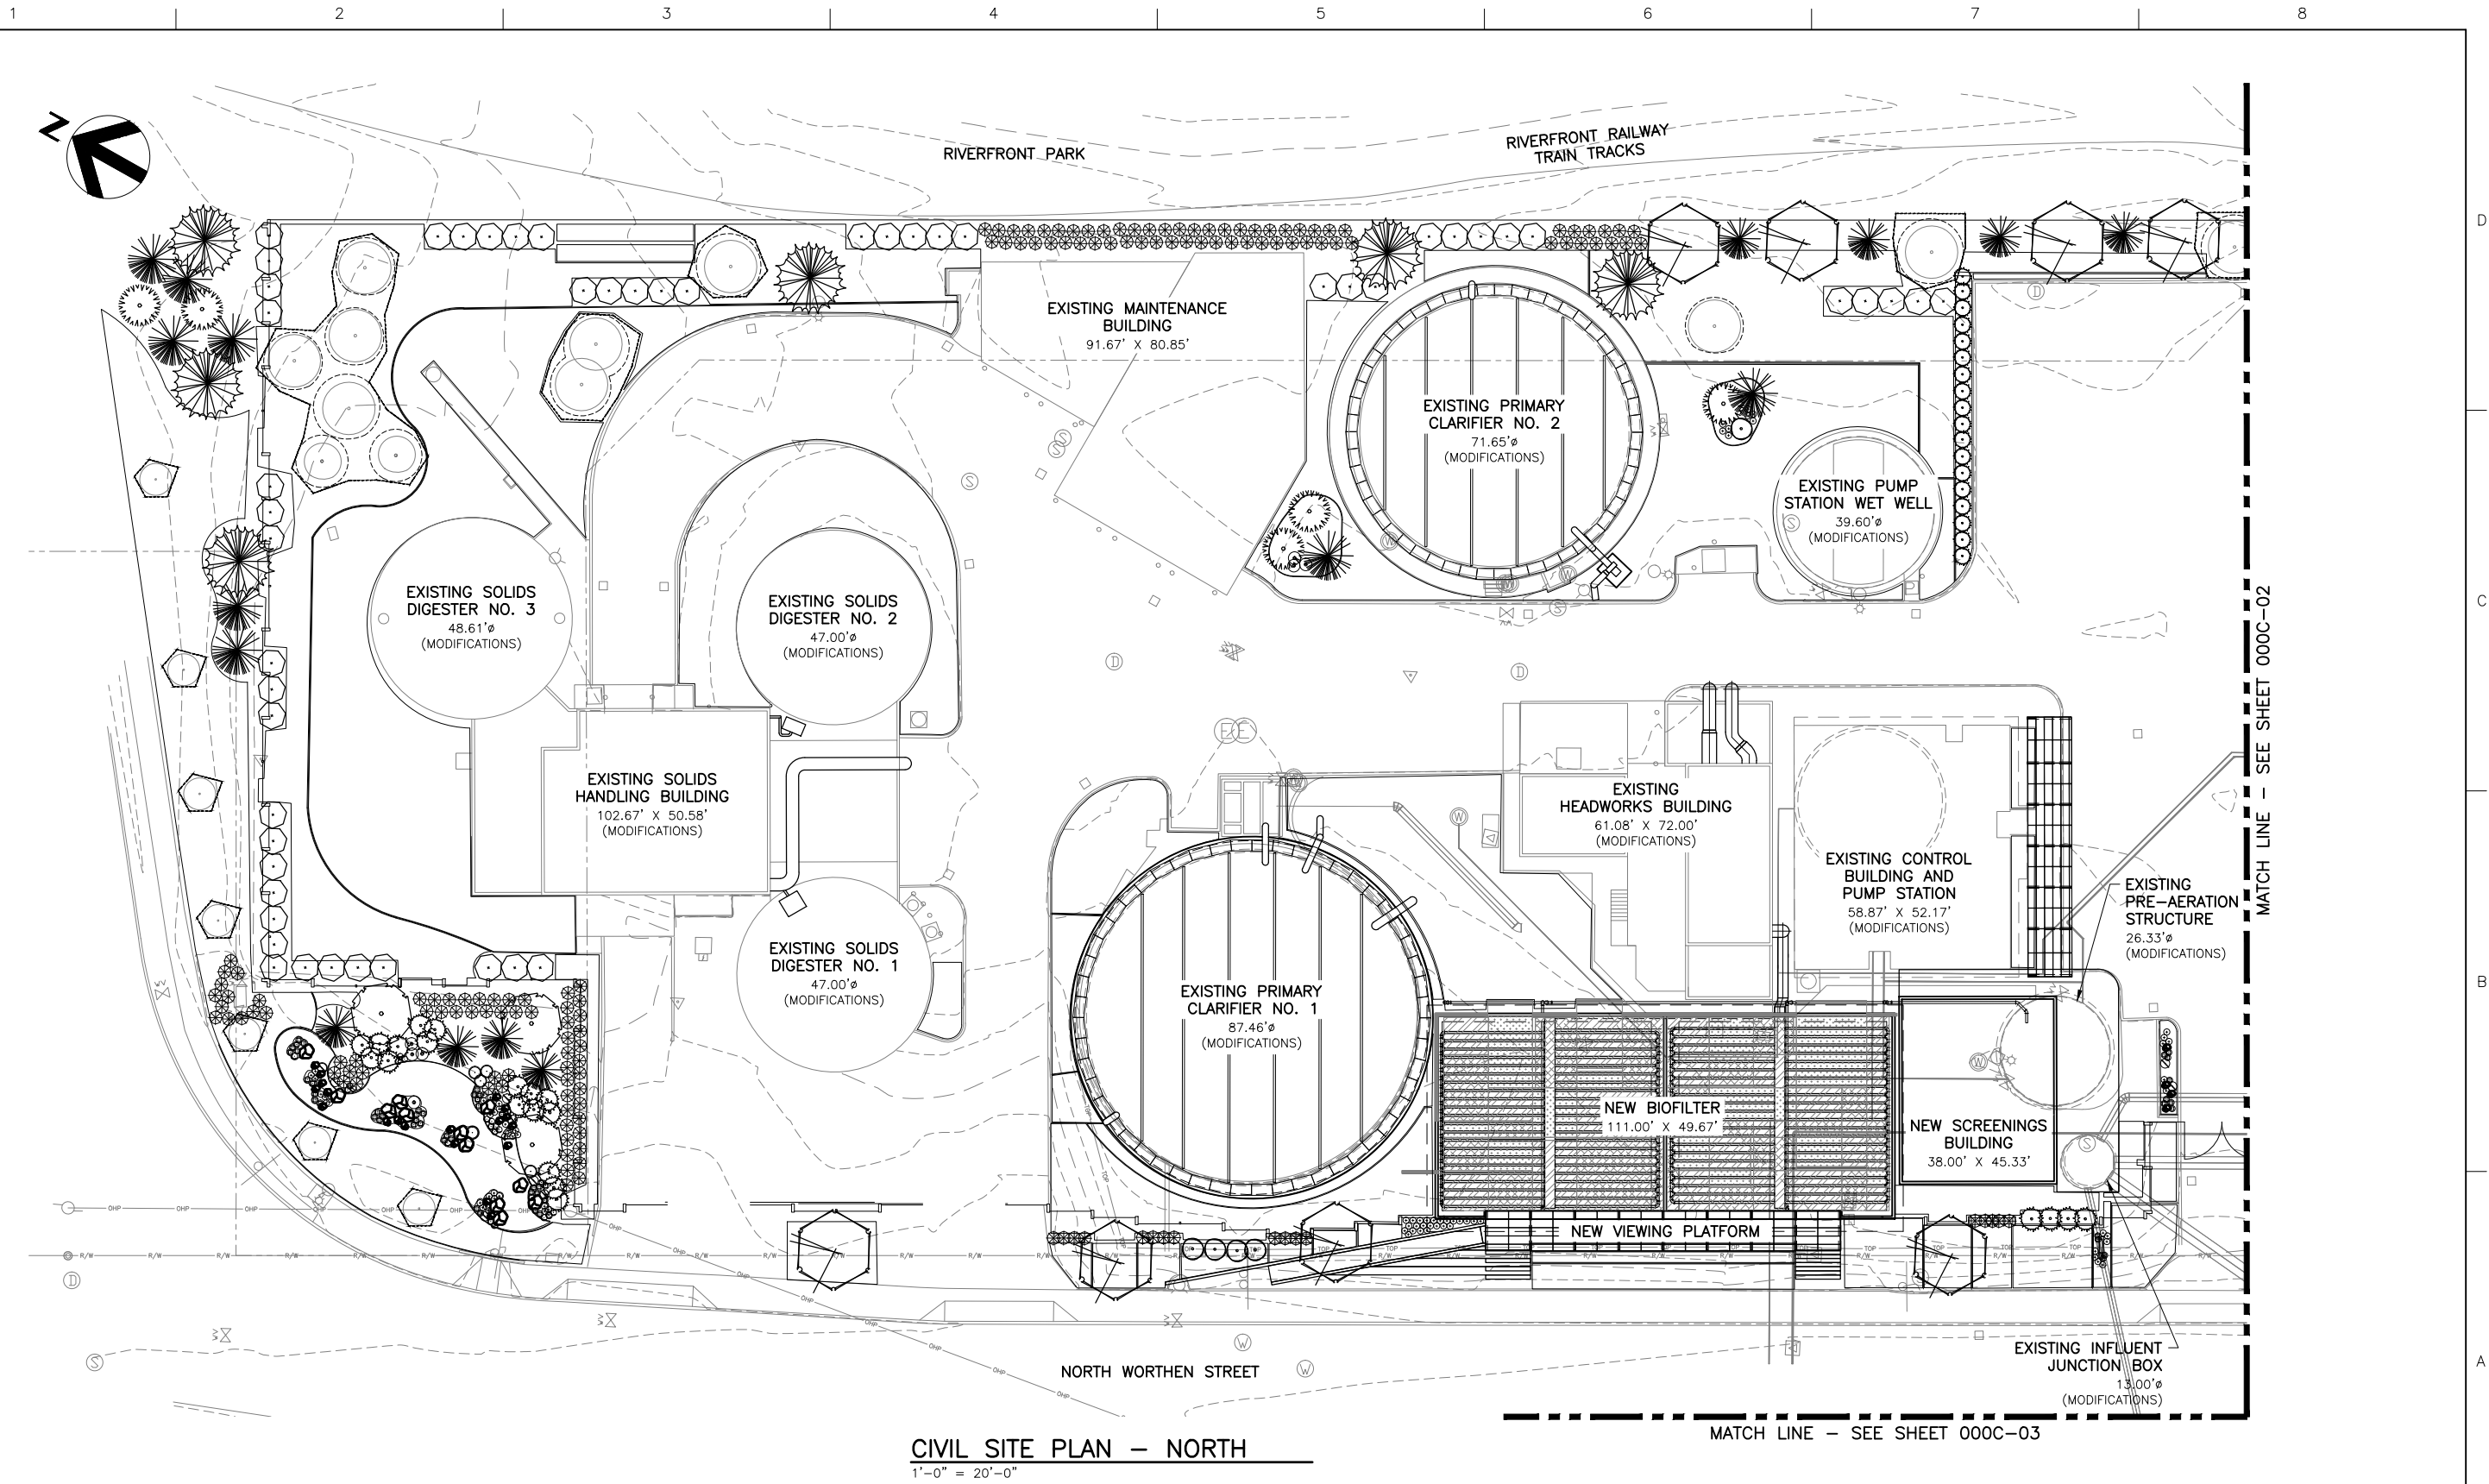

| | | |
|-------|----------|----------------------------------|
| | | |
| | | |
| | | |
| | | |
| 1 | APR 2014 | RECORD DRAWINGS |
| 0 | NOV 2011 | ISSUE FOR CONSTRUCTION SUBMITTAL |
| ISSUE | DATE | DESCRIPTION |

| | |
|-----------------|-------------|
| PROJECT MANAGER | A. MEILLEUR |
| DESIGNED | B. DUDZIK |
| DRAWN | B. LILLY |
| CHECKED | J. KOCH |
| PROJECT NUMBER | 171097 |

ELECTRONIC SEAL AND
SIGNATURE HAS BEEN
REMOVED. THIS MEDIA
SHOULD NOT BE CONSIDERED
A CERTIFIED DOCUMENT



GENERAL
CIVIL SITE PLAN
NORTHEAST SECTION



| | |
|----------|-------------|
| FILENAME | 000C-01.dwg |
| SCALE | AS NOTED |

SHEET
000C-01

ELECTRONIC MEDIA DISCLAIMER: THIS ELECTRONIC MEDIA PROVIDED BY HDR ENGINEERING, INC. IS SUBJECT TO AN ELECTRONIC MEDIA RELEASE. ALL USE AND RE-USE OF THIS MEDIA IS SUBJECT TO THE TERMS AND CONDITIONS OF THE RELEASE.

1

2

3


4

5

6

7

8

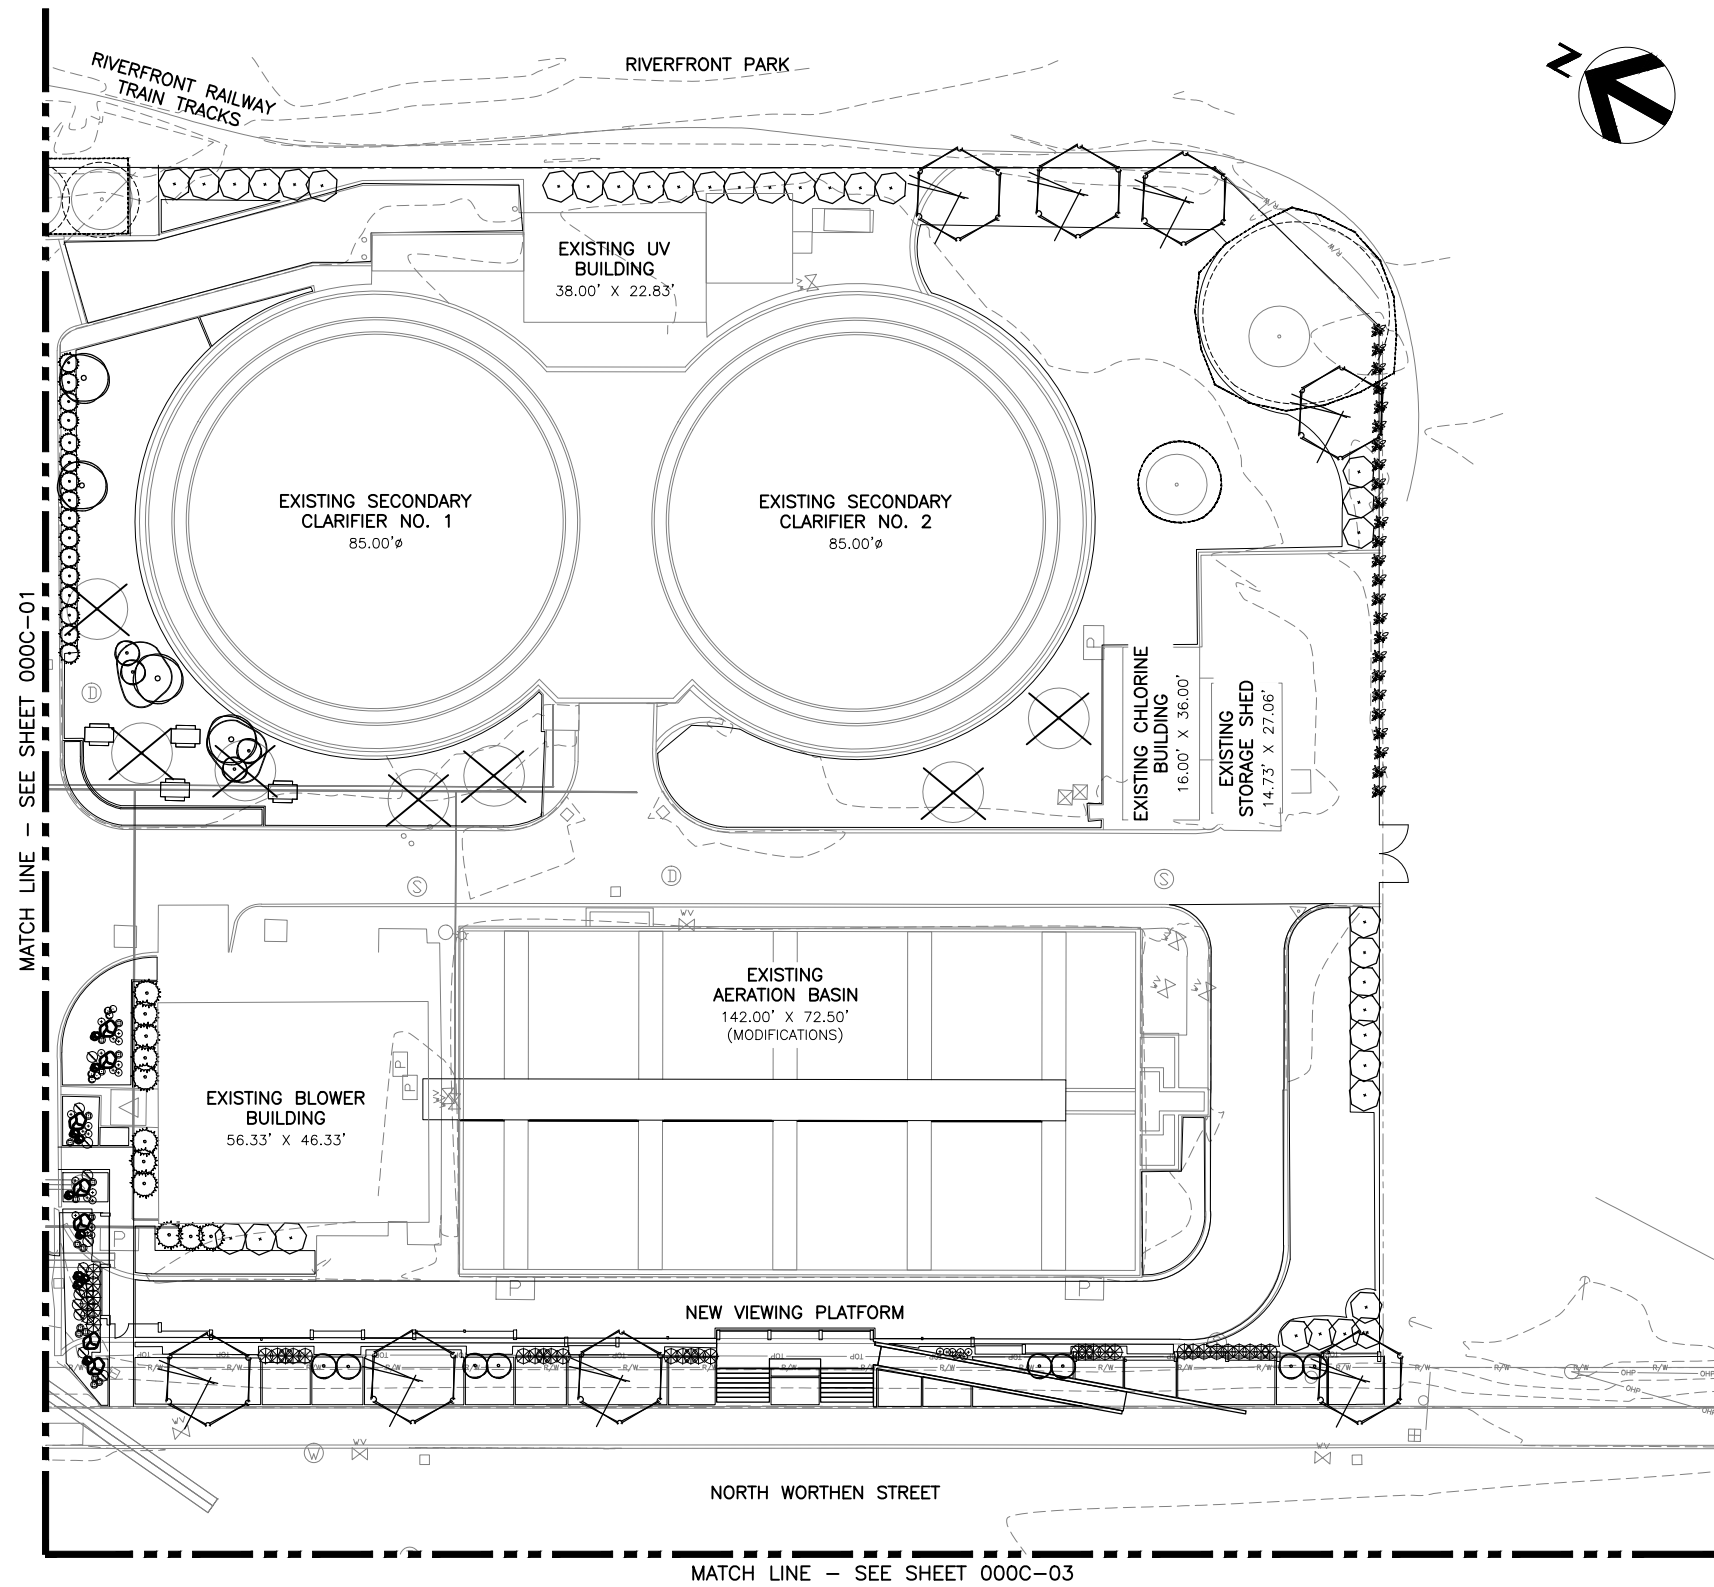

CIVIL SITE PLAN – SOUTH
1"=0" = 20'-0"




| | | |
|-------|----------|----------------------------------|
| | | |
| | | |
| | | |
| | | |
| 1 | APR 2014 | RECORD DRAWINGS |
| 0 | NOV 2011 | ISSUE FOR CONSTRUCTION SUBMITTAL |
| ISSUE | DATE | DESCRIPTION |

| | |
|-----------------|-------------|
| PROJECT MANAGER | A. MEILLEUR |
| DESIGNED | B. DUDZIK |
| DRAWN | B. LILLY |
| CHECKED | J. KOCH |
| PROJECT NUMBER | 171097 |

ELECTRONIC SEAL AND
SIGNATURE HAS BEEN
REMOVED. THIS MEDIA
SHOULD NOT BE CONSIDERED
A CERTIFIED DOCUMENT




GENERAL
CIVIL SITE PLAN
SOUTHEAST SECTION

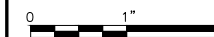

| | |
|----------|-------------|
| FILENAME | 000C-02.dwg |
| SCALE | AS NOTED |

SHEET
000C-02

ELECTRONIC MEDIA DISCLAIMER: THIS ELECTRONIC MEDIA PROVIDED BY HDR ENGINEERING, INC. IS SUBJECT TO AN ELECTRONIC MEDIA RELEASE. ALL USE AND RE-USE OF THIS MEDIA IS SUBJECT TO THE TERMS AND CONDITIONS OF THE RELEASE.

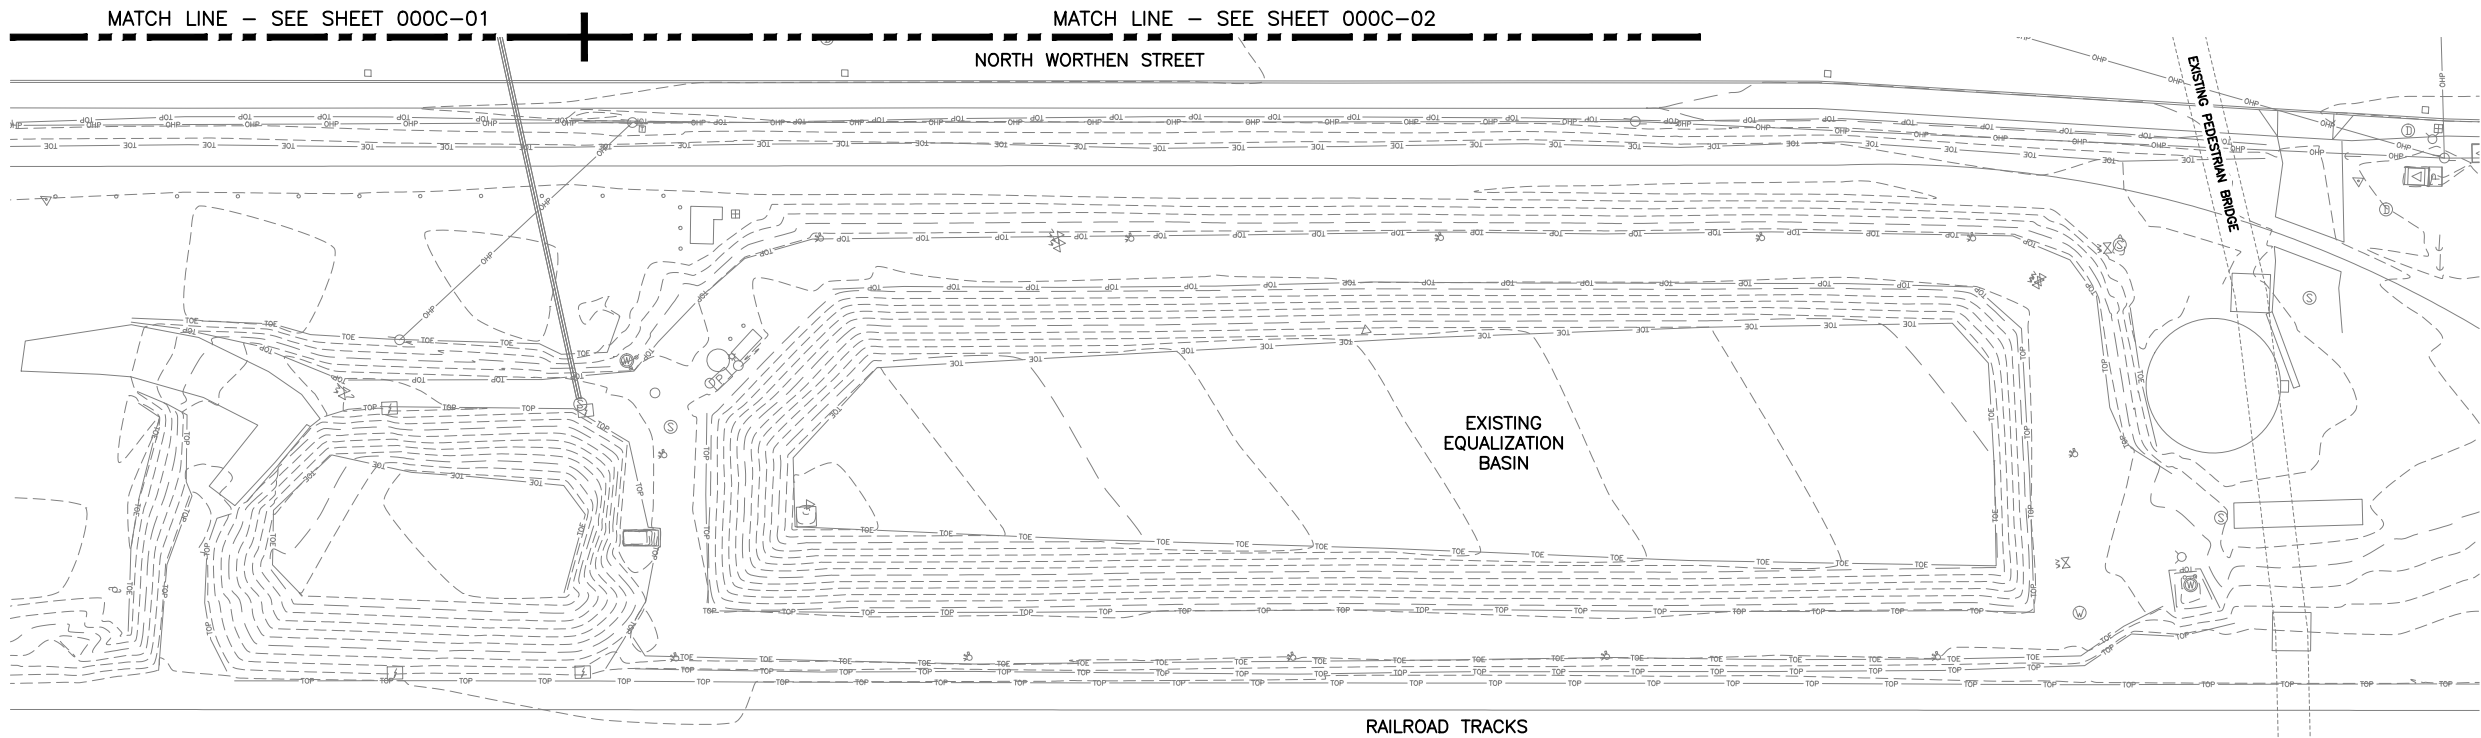

CIVIL SITE PLAN - WEST
1'-0" = 30'-0"



| | | |
|-------|----------|----------------------------------|
| | | |
| | | |
| | | |
| | | |
| 1 | APR 2014 | RECORD DRAWINGS |
| 0 | NOV 2011 | ISSUE FOR CONSTRUCTION SUBMITTAL |
| ISSUE | DATE | DESCRIPTION |

| | |
|-----------------|-------------|
| PROJECT MANAGER | A. MEILLEUR |
| DESIGNED | B. DUDZIK |
| DRAWN | B. LILLY |
| CHECKED | J. KOCH |
| PROJECT NUMBER | 171097 |

ELECTRONIC SEAL AND
SIGNATURE HAS BEEN
REMOVED. THIS MEDIA
SHOULD NOT BE CONSIDERED
A CERTIFIED DOCUMENT




GENERAL
CIVIL SITE PLAN
WEST SECTION

| | |
|----------|-------------|
| FILENAME | 000C-03.dwg |
| SCALE | AS NOTED |

SHEET
000C-03

ELECTRONIC MEDIA DISCLAIMER: THIS ELECTRONIC MEDIA PROVIDED BY HDR ENGINEERING, INC. IS SUBJECT TO AN ELECTRONIC MEDIA RELEASE. ALL USE AND RE-USE OF THIS MEDIA IS SUBJECT TO THE TERMS AND CONDITIONS OF THE RELEASE.

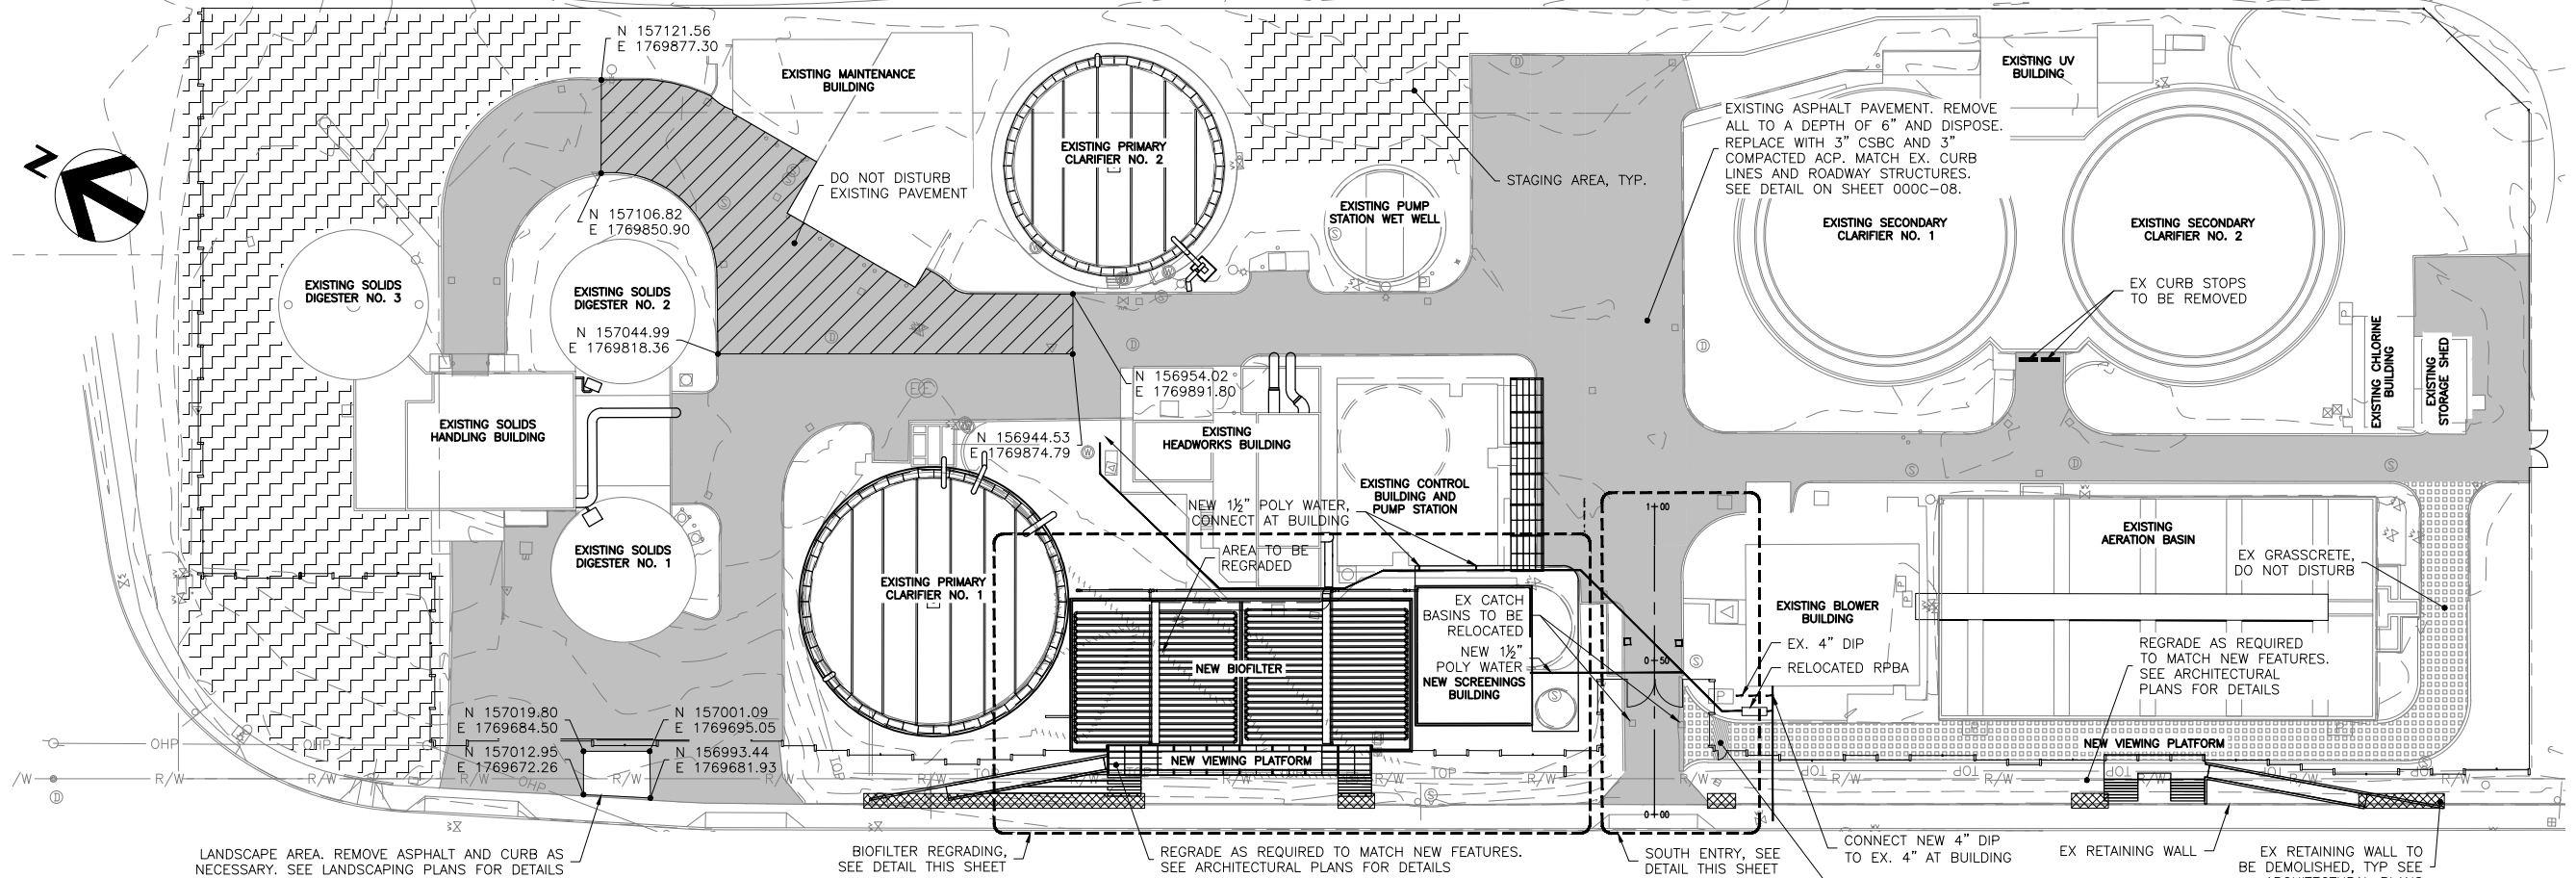


STAGING AND DEMO CIVIL SITE PLAN

1" = 30'-0"


STAGING AREA AND PARKING NOTES
SEE SPECIFICATIONS FOR DETAILS

LANDSCAPING AND TREE PROTECTION NOTES
LANDSCAPING NOT SHOWN THIS SHEET FOR CLARITY. SEE
LANDSCAPING PLANS FOR TREES TO BE PROTECTED AND REMOVED.

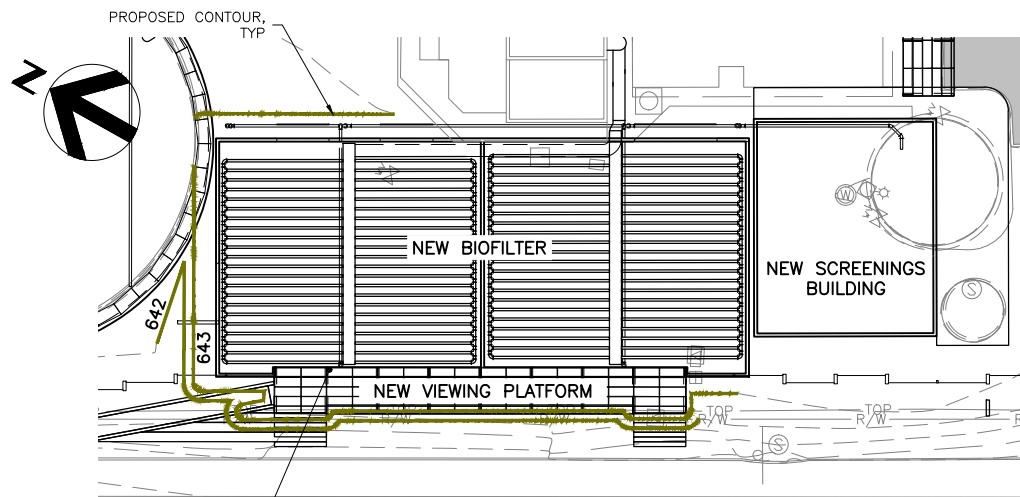


PROPOSED BIOFILTER REGRADING

1" = 20'-0"

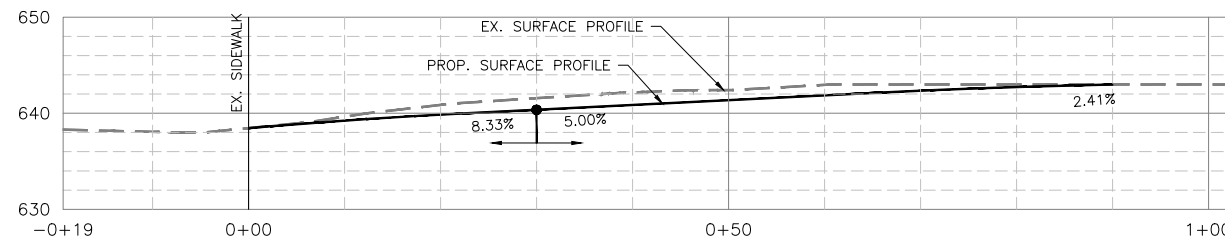

SOUTH ENTRY PROFILE

1" = 10'-0"

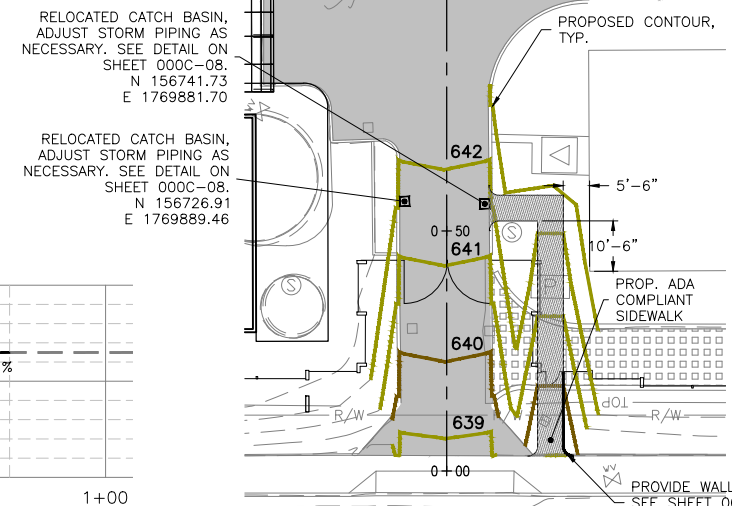

PROPOSED SOUTH ENTRY

1" = 20'-0"



HDR Engineering, Inc.

| ISSUE | DATE | DESCRIPTION |
|-------|----------|----------------------------------|
| 1 | APR 2014 | RECORD DRAWINGS |
| 0 | NOV 2011 | ISSUE FOR CONSTRUCTION SUBMITTAL |

| | |
|-----------------|-------------|
| PROJECT MANAGER | A. MEILLEUR |
| DESIGNED | K. KORNIHER |
| DRAWN | B. SANTIAGO |
| CHECKED | J. KOCH |
| PROJECT NUMBER | 171097 |

ELECTRONIC SEAL AND
SIGNATURE HAS BEEN
REMOVED. THIS MEDIA
SHOULD NOT BE CONSIDERED
A CERTIFIED DOCUMENT




GENERAL
OVERALL CIVIL PROPOSED SITE PLAN,
STAGING AND DEMO PLAN



| | |
|----------|-------------|
| FILENAME | 000C-04.dwg |
| SCALE | AS NOTED |

| | |
|-------|---------|
| SHEET | 000C-04 |
|-------|---------|

ELECTRONIC MEDIA DISCLAIMER: THIS ELECTRONIC MEDIA PROVIDED BY HDR ENGINEERING, INC. IS SUBJECT TO AN ELECTRONIC MEDIA RELEASE. ALL USE AND RE-USE OF THIS MEDIA IS SUBJECT TO THE TERMS AND CONDITIONS OF THE RELEASE.

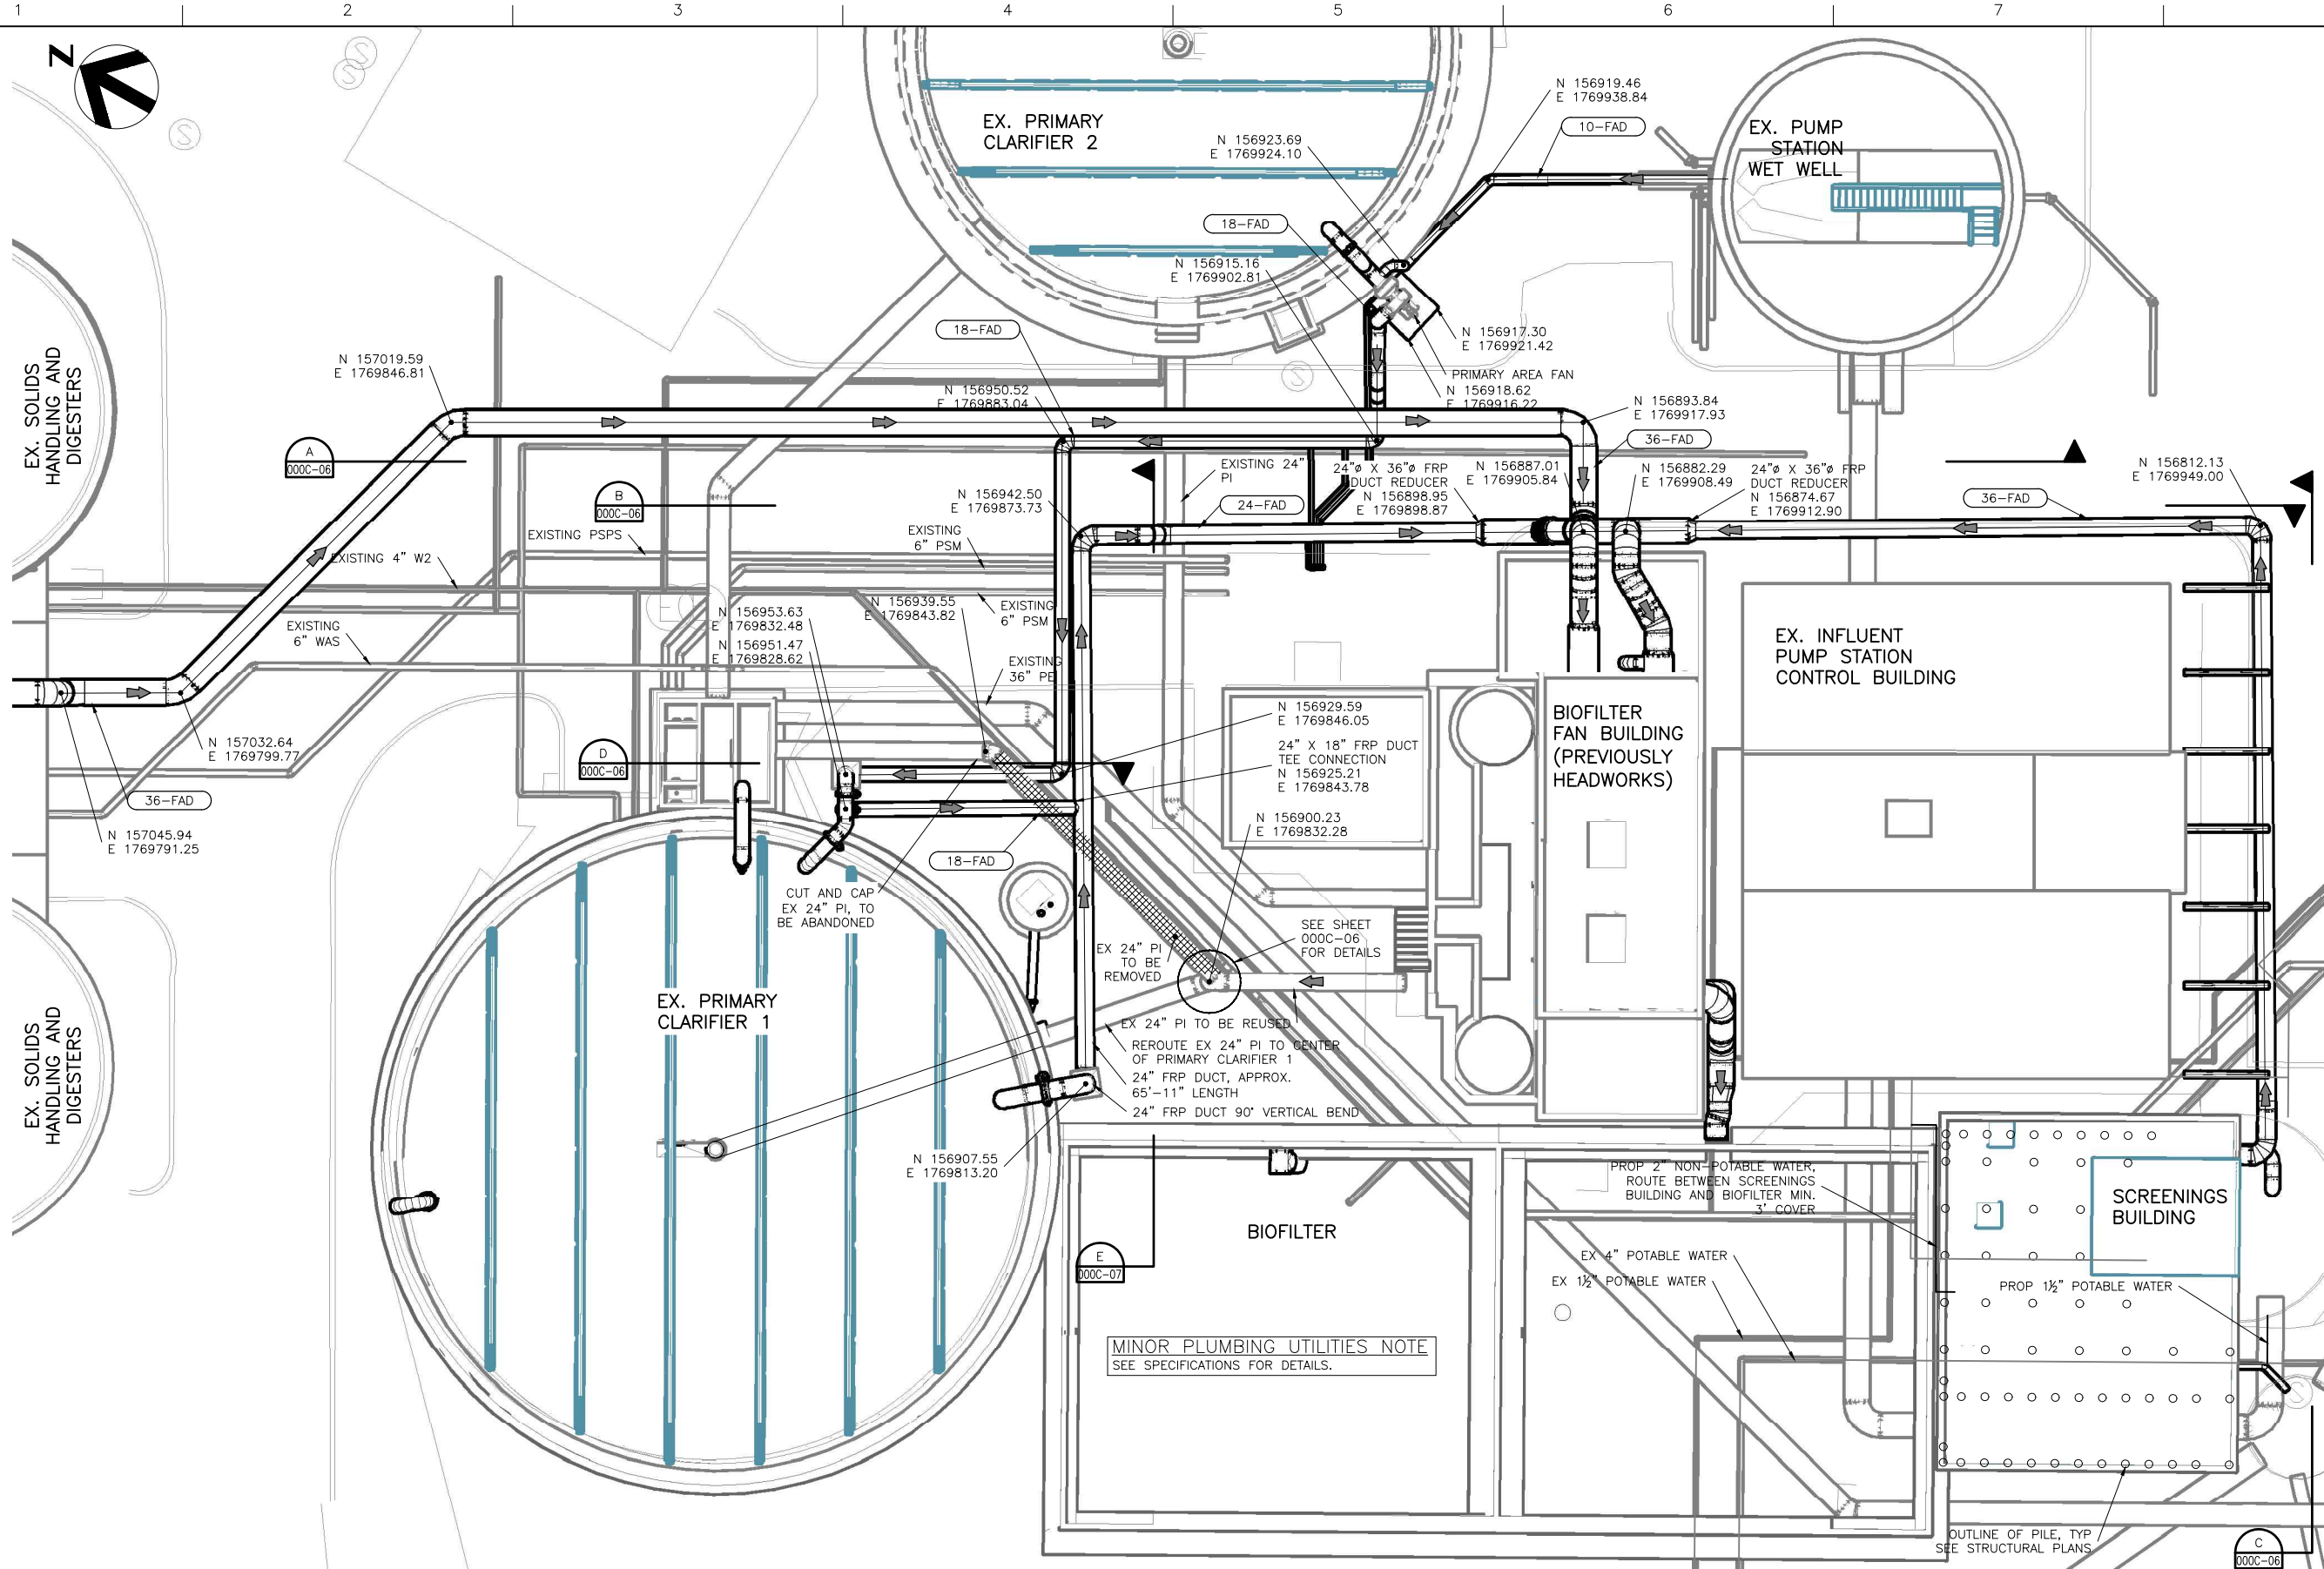

HDR Engineering, Inc.


| ISSUE | DATE | DESCRIPTION |
|-------|----------|----------------------------------|
| 1 | APR 2014 | RECORD DRAWINGS |
| 0 | NOV 2011 | ISSUE FOR CONSTRUCTION SUBMITTAL |

| | |
|-----------------|-------------|
| PROJECT MANAGER | A. MEILLEUR |
| DESIGNED | K. KORNER |
| DRAWN | B. SANTIAGO |
| CHECKED | J. KOCH |
| PROJECT NUMBER | 171097 |

ELECTRONIC SEAL AND
SIGNATURE HAS BEEN
REMOVED. THIS MEDIA
SHOULD NOT BE CONSIDERED
A CERTIFIED DOCUMENT







GENERAL
CIVIL SITE UTILITY PLAN
OVERALL FOUL AIR DUCTWORK
AND PROPOSED UTILITIES PLAN

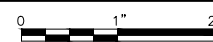

FILENAME 000C-05.dwg
SCALE 3/32" = 1'-0"

SHEET
000C-05

ELECTRONIC MEDIA DISCLAIMER: THIS ELECTRONIC MEDIA PROVIDED BY HDR ENGINEERING, INC. IS SUBJECT TO AN ELECTRONIC MEDIA RELEASE. ALL USE AND RE-USE OF THIS MEDIA IS SUBJECT TO THE TERMS AND CONDITIONS OF THE RELEASE.

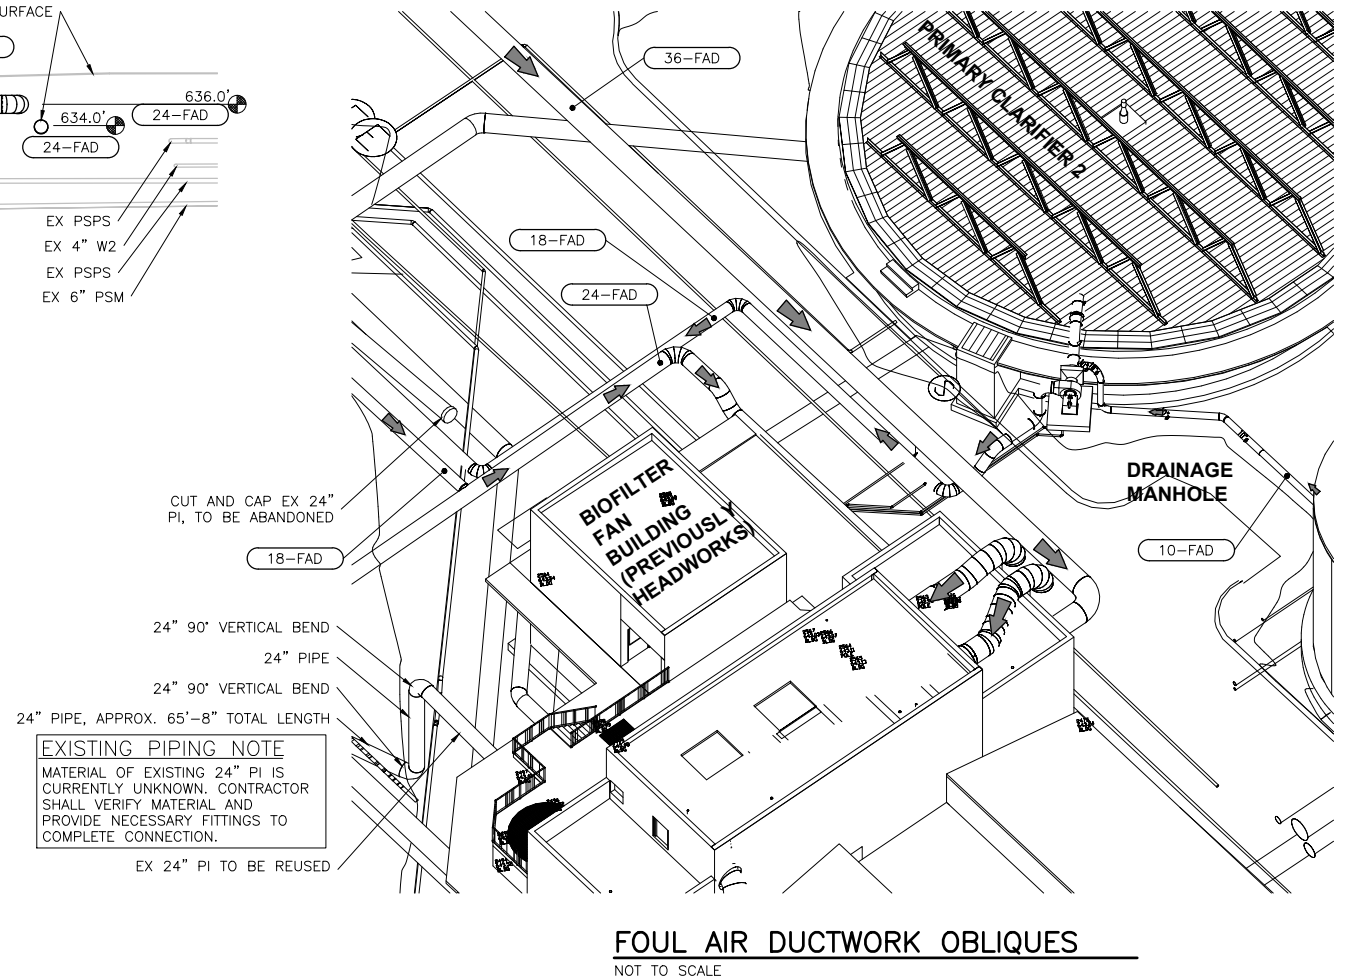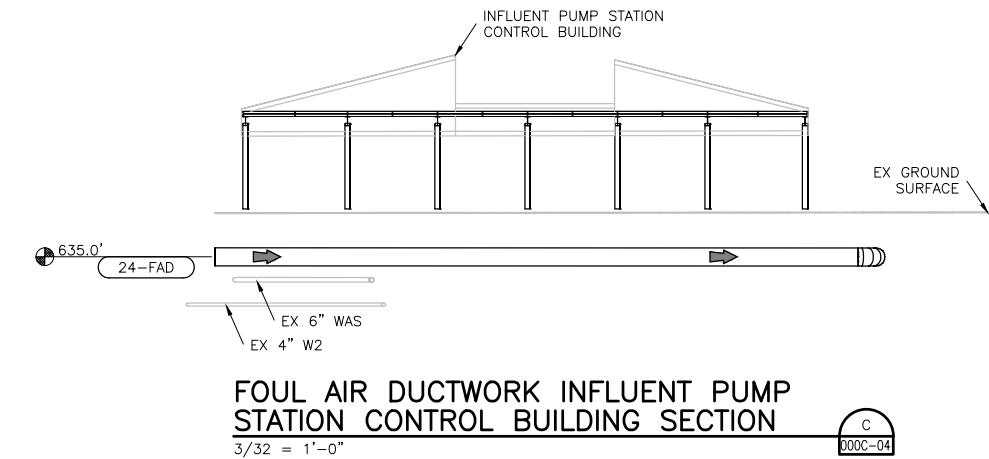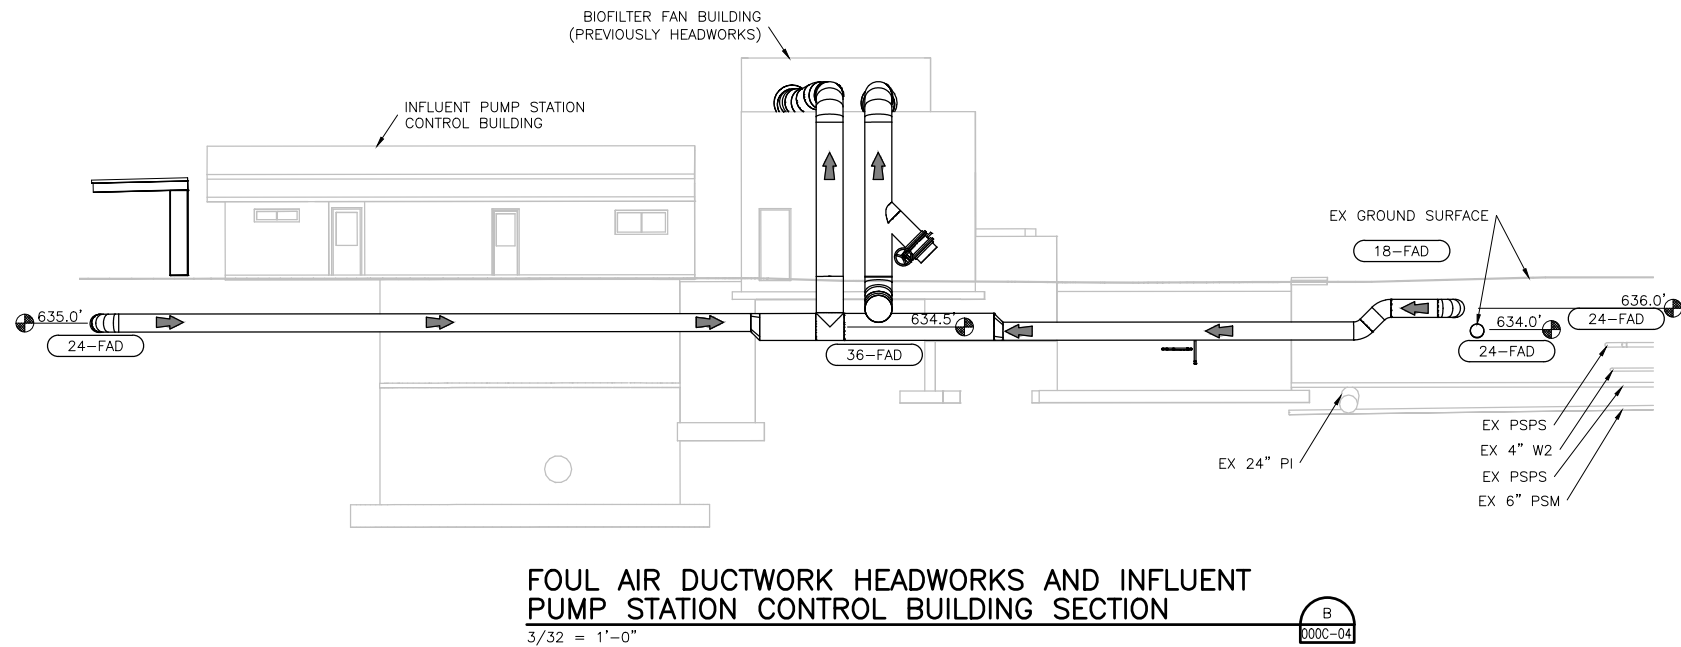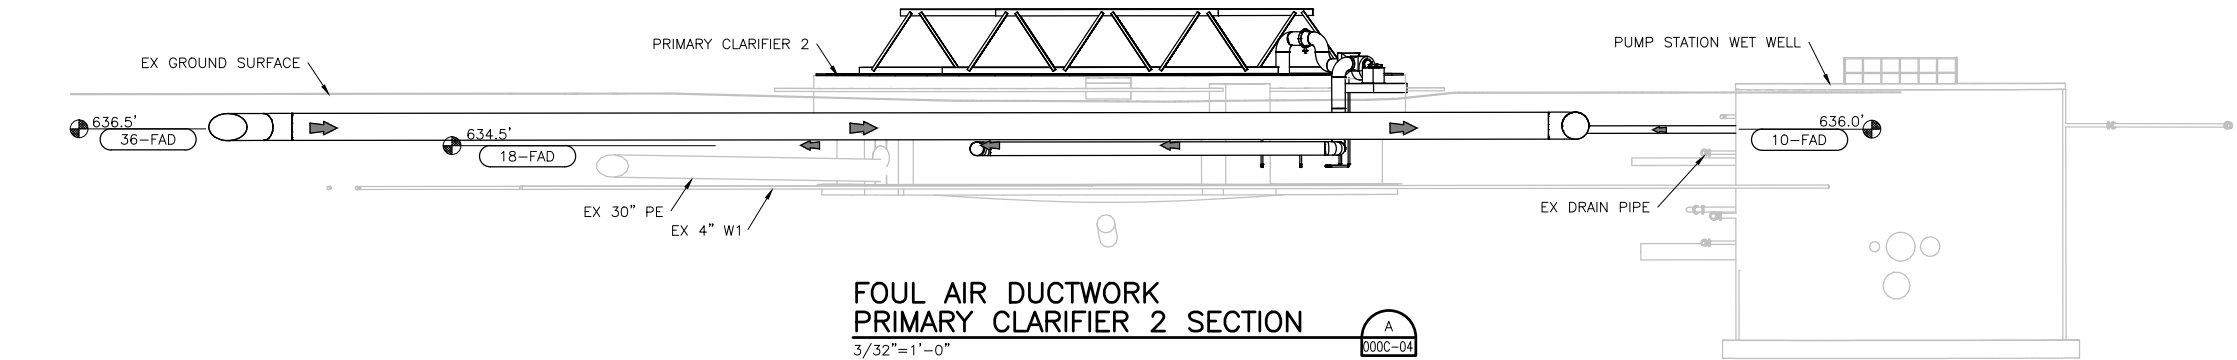

HDR Engineering, Inc.


| ISSUE | DATE | DESCRIPTION |
|-------|----------|----------------------------------|
| 1 | APR 2014 | RECORD DRAWINGS |
| 0 | NOV 2011 | ISSUE FOR CONSTRUCTION SUBMITTAL |

| | |
|-----------------|-------------|
| PROJECT MANAGER | A. MEILLEUR |
| DESIGNED | K. KORNIHER |
| DRAWN | B. SANTIAGO |
| CHECKED | J. KOCH |
| PROJECT NUMBER | 171097 |

ELECTRONIC SEAL AND SIGNATURE HAS BEEN REMOVED. THIS MEDIA SHOULD NOT BE CONSIDERED A CERTIFIED DOCUMENT




GENERAL
OVERALL FOUL AIR DUCTWORK
PROFILE AND OBLIQUES 1

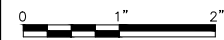


| | |
|----------|-------------|
| FILENAME | 000C-06.dwg |
| SCALE | AS NOTED |

SHEET
000C-06


ELECTRONIC MEDIA DISCLAIMER: THIS ELECTRONIC MEDIA PROVIDED BY HDR ENGINEERING, INC. IS SUBJECT TO AN ELECTRONIC MEDIA RELEASE. ALL USE AND RE-USE OF THIS MEDIA IS SUBJECT TO THE TERMS AND CONDITIONS OF THE RELEASE.

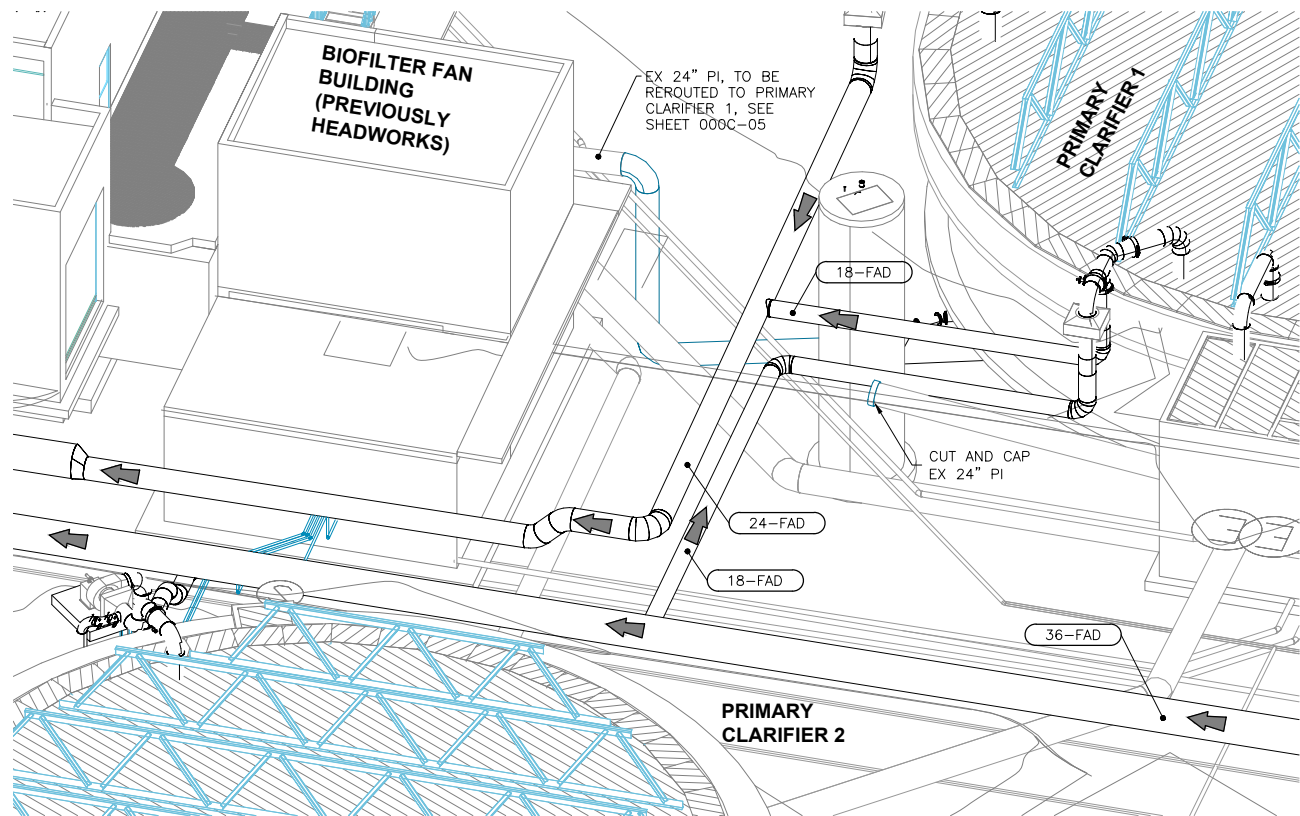


SOUTHWEST FOUL AIR DUCTING OBLIQUE
NOT TO SCALE

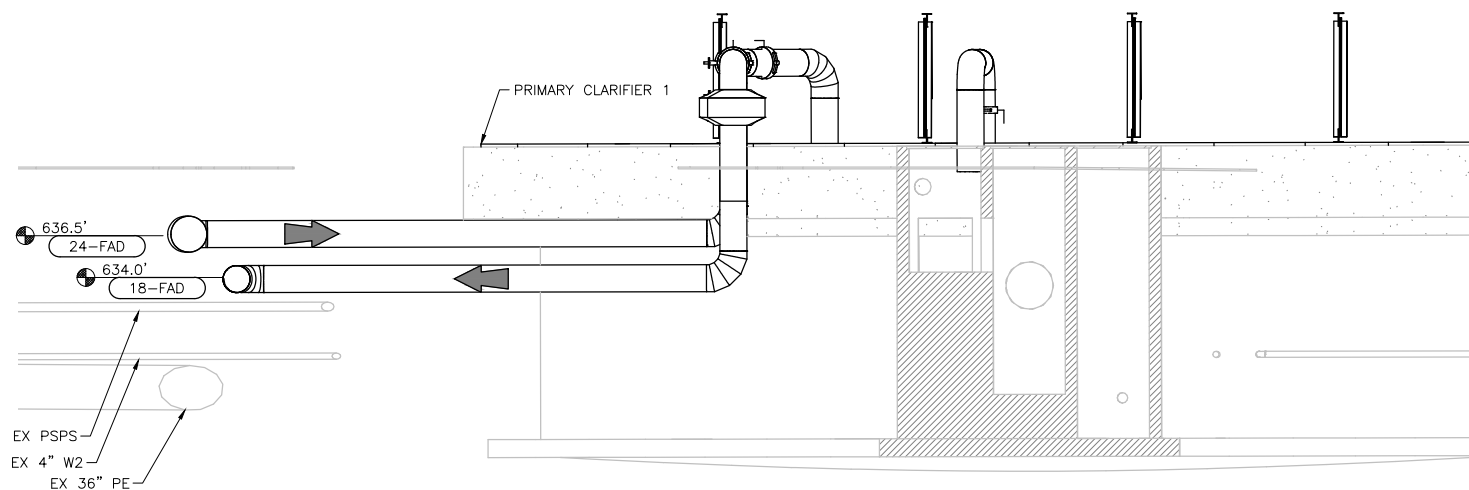

PRIMARY CLARIFIER 1 DUCTING SECTION 2
3/16" = 1'-0" E
000C-04

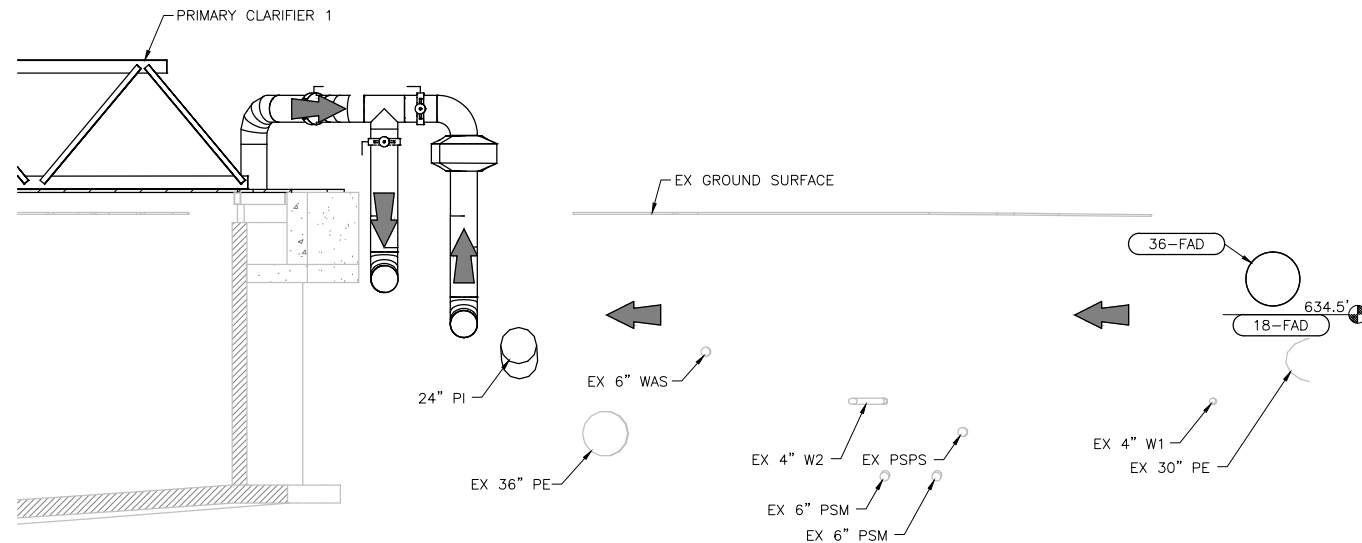

PRIMARY CLARIFIER 1 DUCTING SECTION 1
3/16" = 1'-0" D
000C-04

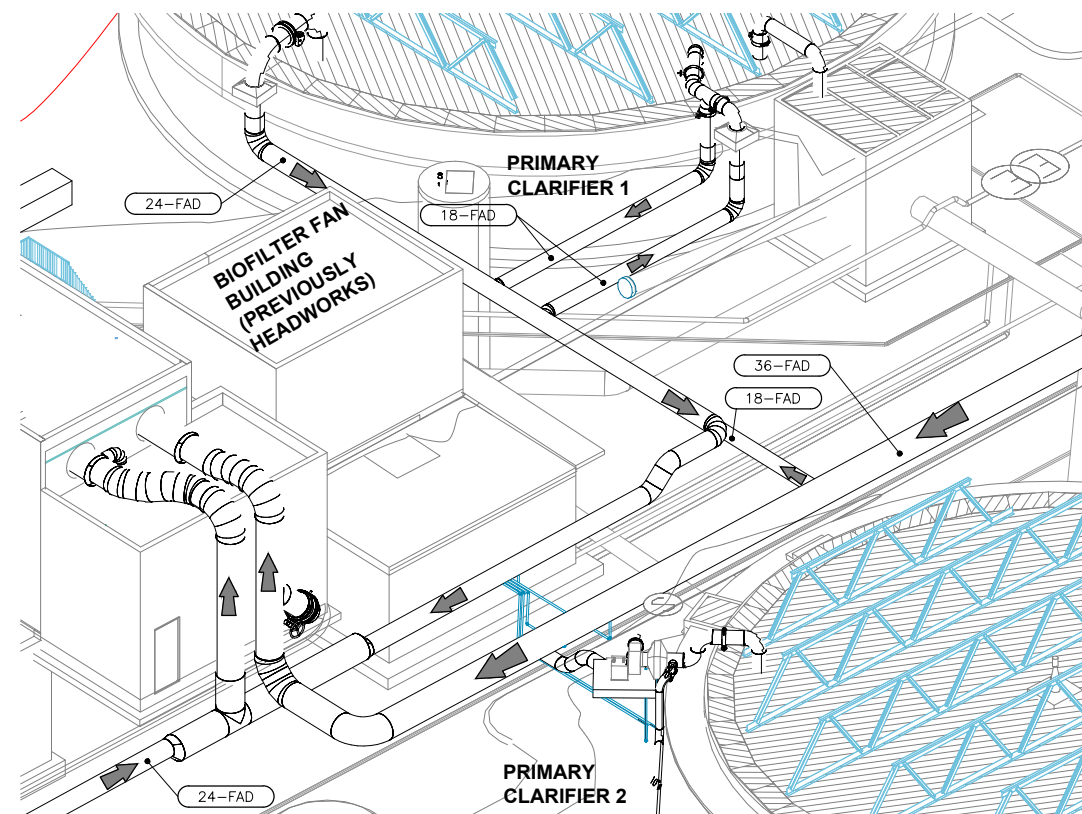

WEST FOUL AIR DUCTING OBLIQUE
NOT TO SCALE



HDR Engineering, Inc.

| | | |
|-------|----------|----------------------------------|
| | | |
| | | |
| | | |
| 1 | APR 2014 | RECORD DRAWINGS |
| 0 | NOV 2011 | ISSUE FOR CONSTRUCTION SUBMITTAL |
| ISSUE | DATE | DESCRIPTION |

| | |
|-----------------|-------------|
| PROJECT MANAGER | A. MEILLEUR |
| DESIGNED | K. KORNER |
| DRAWN | B. SANTIAGO |
| CHECKED | J. KOCH |
| PROJECT NUMBER | 171097 |

ELECTRONIC SEAL AND
SIGNATURE HAS BEEN
REMOVED. THIS MEDIA
SHOULD NOT BE CONSIDERED
A CERTIFIED DOCUMENT




**GENERAL
OVERALL FOUL AIR DUCTWORK
PROFILE AND OBLIQUES 2**




| | |
|----------|-------------|
| FILENAME | 000C-07.dwg |
| SCALE | AS NOTED |

| |
|----------------|
| SHEET |
| 000C-07 |


ELECTRONIC MEDIA DISCLAIMER: THIS ELECTRONIC MEDIA PROVIDED BY HDR ENGINEERING, INC. IS SUBJECT TO AN ELECTRONIC MEDIA RELEASE. ALL USE AND RE-USE OF THIS MEDIA IS SUBJECT TO THE TERMS AND CONDITIONS OF THE RELEASE.

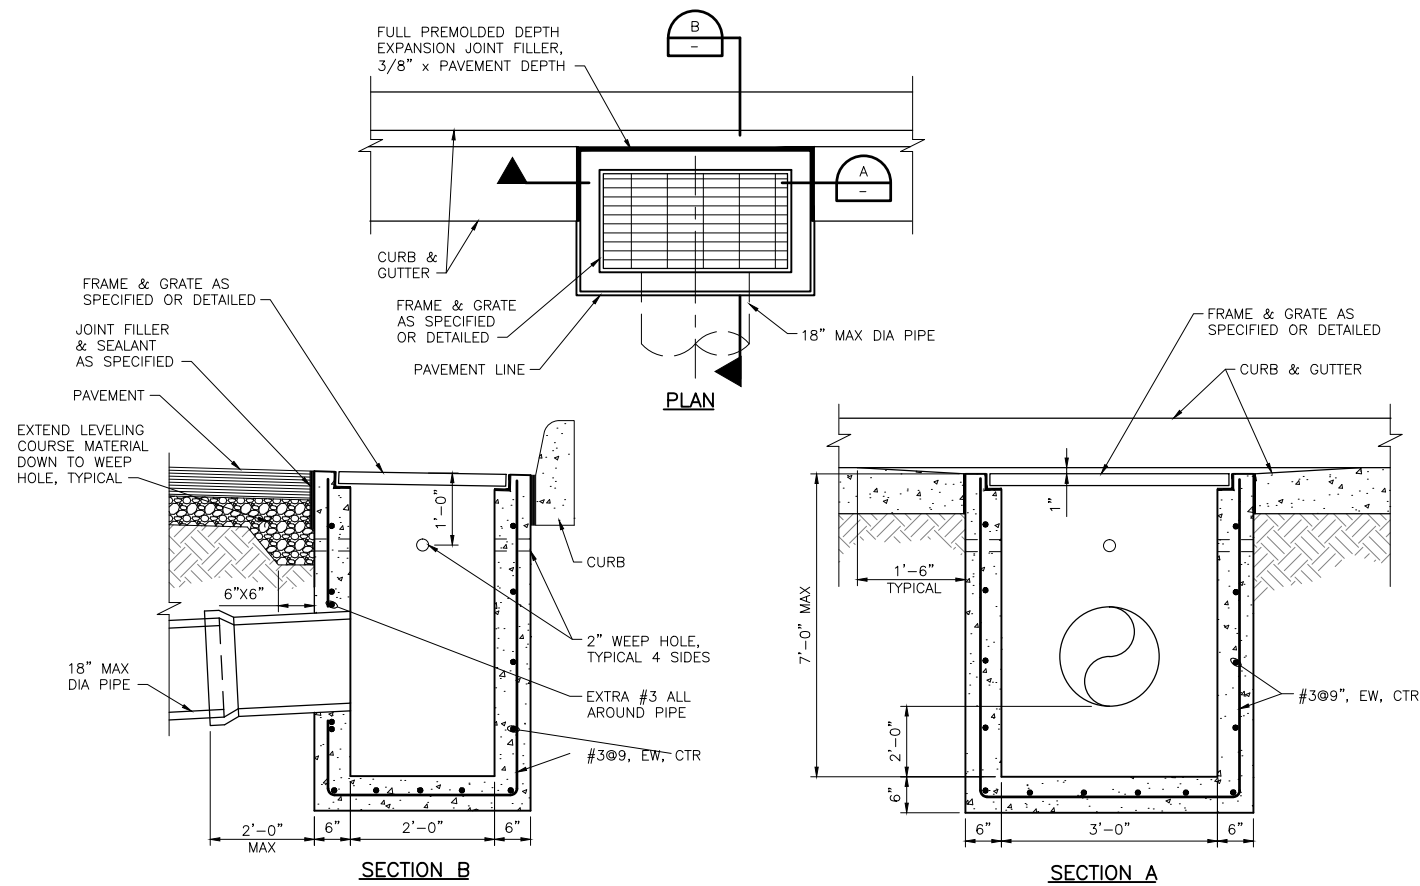

CATCH BASIN
NOT TO SCALE

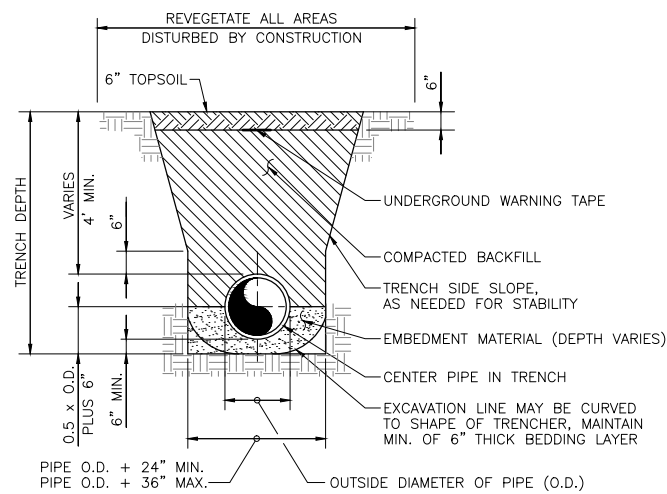

TYPICAL PIPE EMBEDMENT
DIMENSIONS DETAIL
NOT TO SCALE

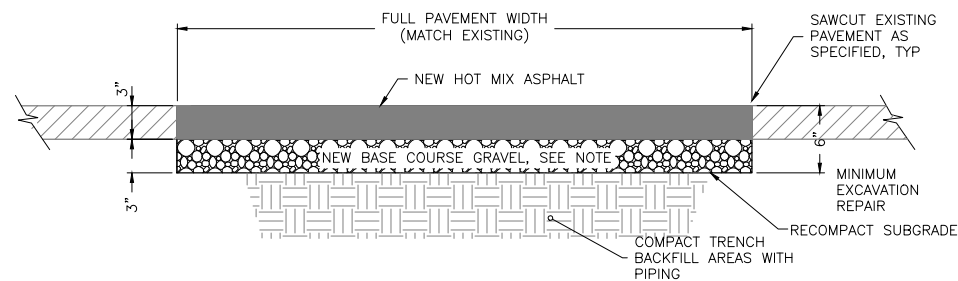

NOTE:
BASE COURSE GRAVEL SHALL CONSIST OF A MINIMUM OF 3 INCHES OF CRUSHED SURFACE BASE COURSE.

PAVEMENT SURFACE REPAIR
NOT TO SCALE



HDR Engineering, Inc.


| | | |
|-------|----------|----------------------------------|
| | | |
| | | |
| | | |
| | | |
| 1 | APR 2014 | RECORD DRAWINGS |
| 0 | NOV 2011 | ISSUE FOR CONSTRUCTION SUBMITTAL |
| ISSUE | DATE | DESCRIPTION |

| | |
|-----------------|-------------|
| PROJECT MANAGER | A. MEILLEUR |
| DESIGNED | K. KORNIHER |
| DRAWN | B. SANTIAGO |
| CHECKED | J. KOCH |
| PROJECT NUMBER | 171097 |

ELECTRONIC SEAL AND
SIGNATURE HAS BEEN
REMOVED. THIS MEDIA
SHOULD NOT BE CONSIDERED
A CERTIFIED DOCUMENT




GENERAL
CIVIL SITE DETAILS

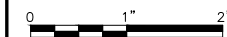

| | |
|----------|--------------|
| FILENAME | 000C-08.dwg |
| SCALE | NOT TO SCALE |

| |
|---------|
| SHEET |
| 000C-08 |


ELECTRONIC MEDIA DISCLAIMER: THIS ELECTRONIC MEDIA PROVIDED BY HDR ENGINEERING, INC. IS SUBJECT TO AN ELECTRONIC MEDIA RELEASE. ALL USE AND RE-USE OF THIS MEDIA IS SUBJECT TO THE TERMS AND CONDITIONS OF THE RELEASE.

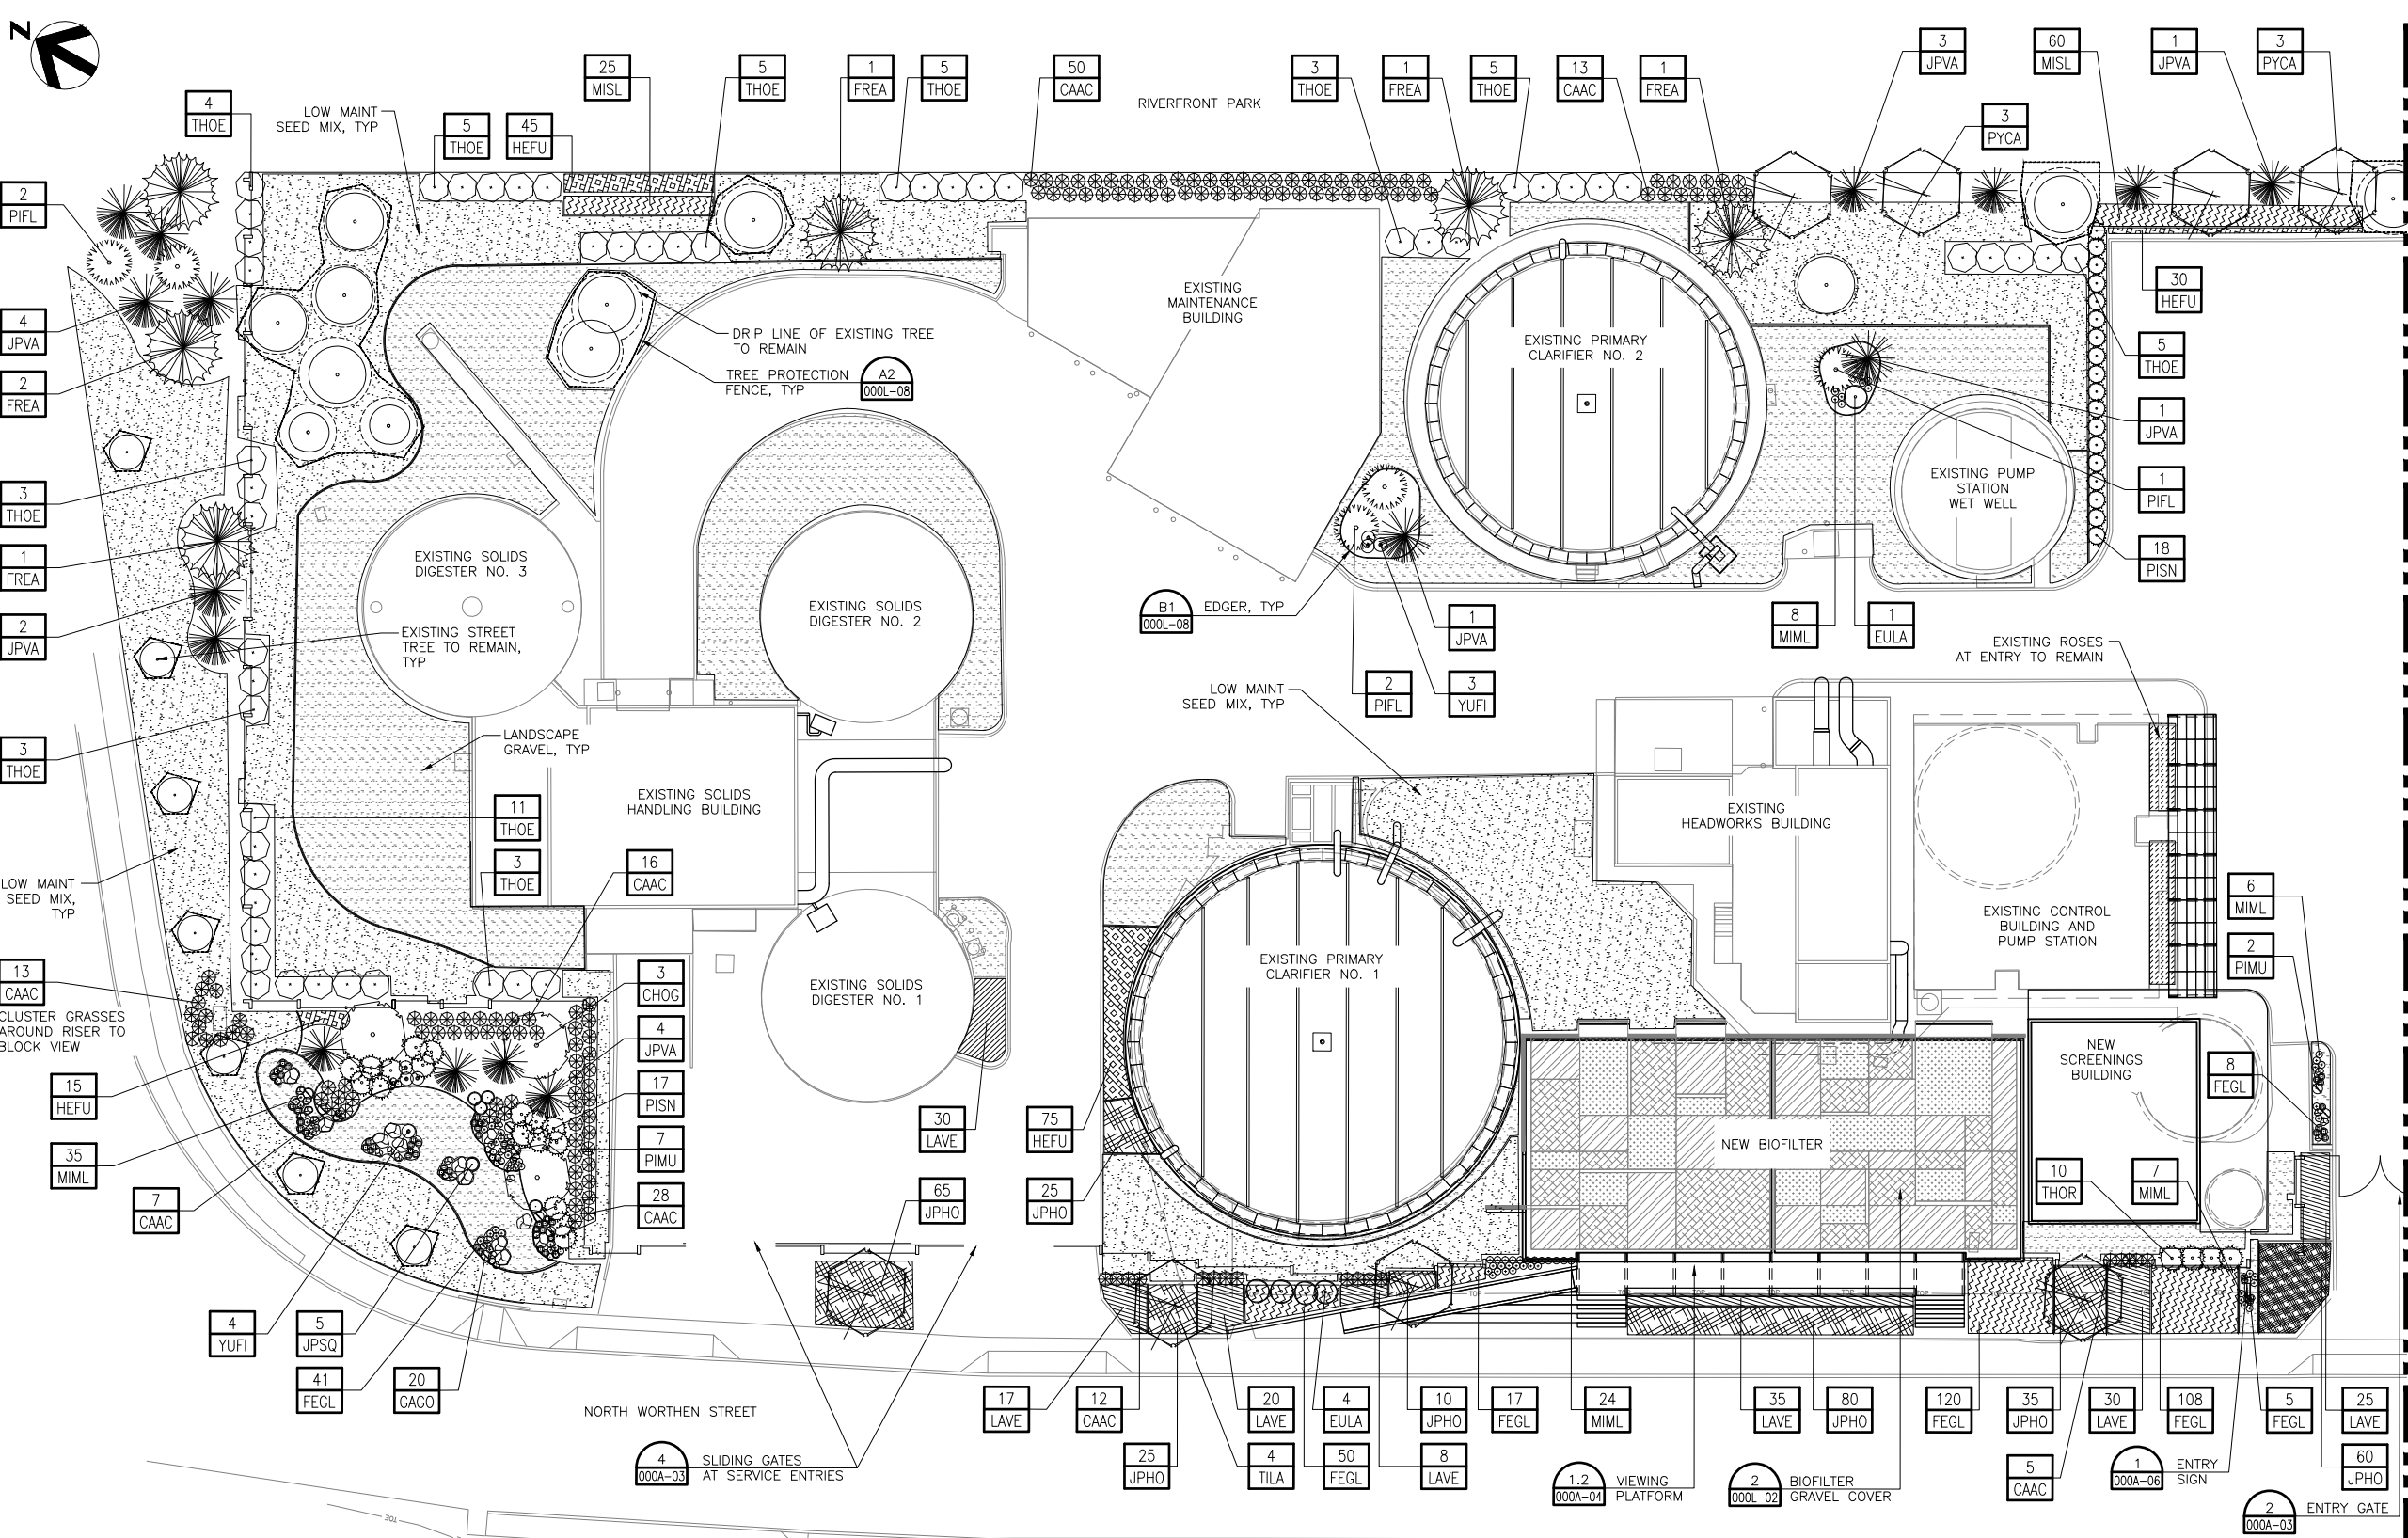

LANDSCAPE PLAN - NORTH
1'-0" = 20'-0"

- GENERAL NOTES
- SEE SHEET 000L-07 FOR PLANT MATERIAL SCHEDULE, QUANTITIES, SPECIES AND SIZES
 - SEE SHEET 000C-01 FOR SITE PLAN
 - ALL PLANT MATERIAL TO BE IRRIGATED; SEE SHEET 000-L04 AND 000-L06 FOR IRRIGATION PLANS
 - CALL BEFORE DIGGING: DIAL 811 MIN 2 DAYS IN ADVANCE

- LEGEND
- EXISTING TREE TO REMAIN
 - EXISTING TREE TO BE REMOVED
 - EXISTING TREE DRIPLINE
 - EVERGREEN TREE
 - DECIDUOUS TREE
 - SHRUBS/UNDERSTORY
 - SMALL SHRUBS / GROUNDCOVERS
 - LANDSCAPE BOULDERS
 - PLANT MATERIAL TAG
 - GROUND COVERS
 - ORNAMENTAL GRASSES
 - LOW MAINTENANCE SEEDED LAWN
 - EXISTING REINFORCED LAWN RESEED WITH LOW MAINT SEED AS NECESSARY
 - LANDSCAPE GRAVEL
 - B1- LAVA ROCK - COLOR RED
 - B2- GRAVEL - CONTRASTING COLOR
 - B3- LAVA ROCK - COLOR BROWN
 - R1- LAVA ROCK - COLOR RED
 - R2- GRAVEL - CONTRASTING COLOR
 - R3- LAVA ROCK - COLOR BROWN

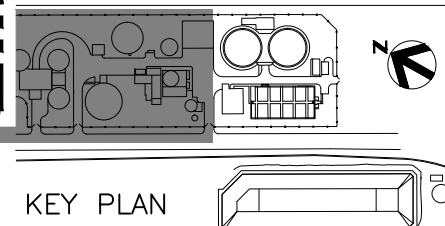

| ISSUE | DATE | DESCRIPTION |
|-------|----------|----------------------------------|
| 1 | APR 2014 | RECORD DRAWINGS |
| 0 | NOV 2011 | ISSUE FOR CONSTRUCTION SUBMITTAL |

| | |
|-----------------|-------------------------|
| PROJECT MANAGER | A. MEILLEUR |
| DESIGNED | B. POWERS/ S. HOEBER |
| DRAWN | S. HOEBER |
| CHECKED | G. LAI |
| PROJECT NUMBER | 171097 |

ELECTRONIC SEAL AND
SIGNATURE HAS BEEN
REMOVED. THIS MEDIA
SHOULD NOT BE CONSIDERED
A CERTIFIED DOCUMENT




LANDSCAPE PLAN
NORTH



| | | | |
|----------|-------------|-------|---------|
| FILENAME | 000L-01.dwg | SHEET | 000L-01 |
| SCALE | AS NOTED | | |


ELECTRONIC MEDIA DISCLAIMER: THIS ELECTRONIC MEDIA PROVIDED BY HDR ENGINEERING, INC. IS SUBJECT TO AN ELECTRONIC MEDIA RELEASE. ALL USE AND RE-USE OF THIS MEDIA IS SUBJECT TO THE TERMS AND CONDITIONS OF THE RELEASE.

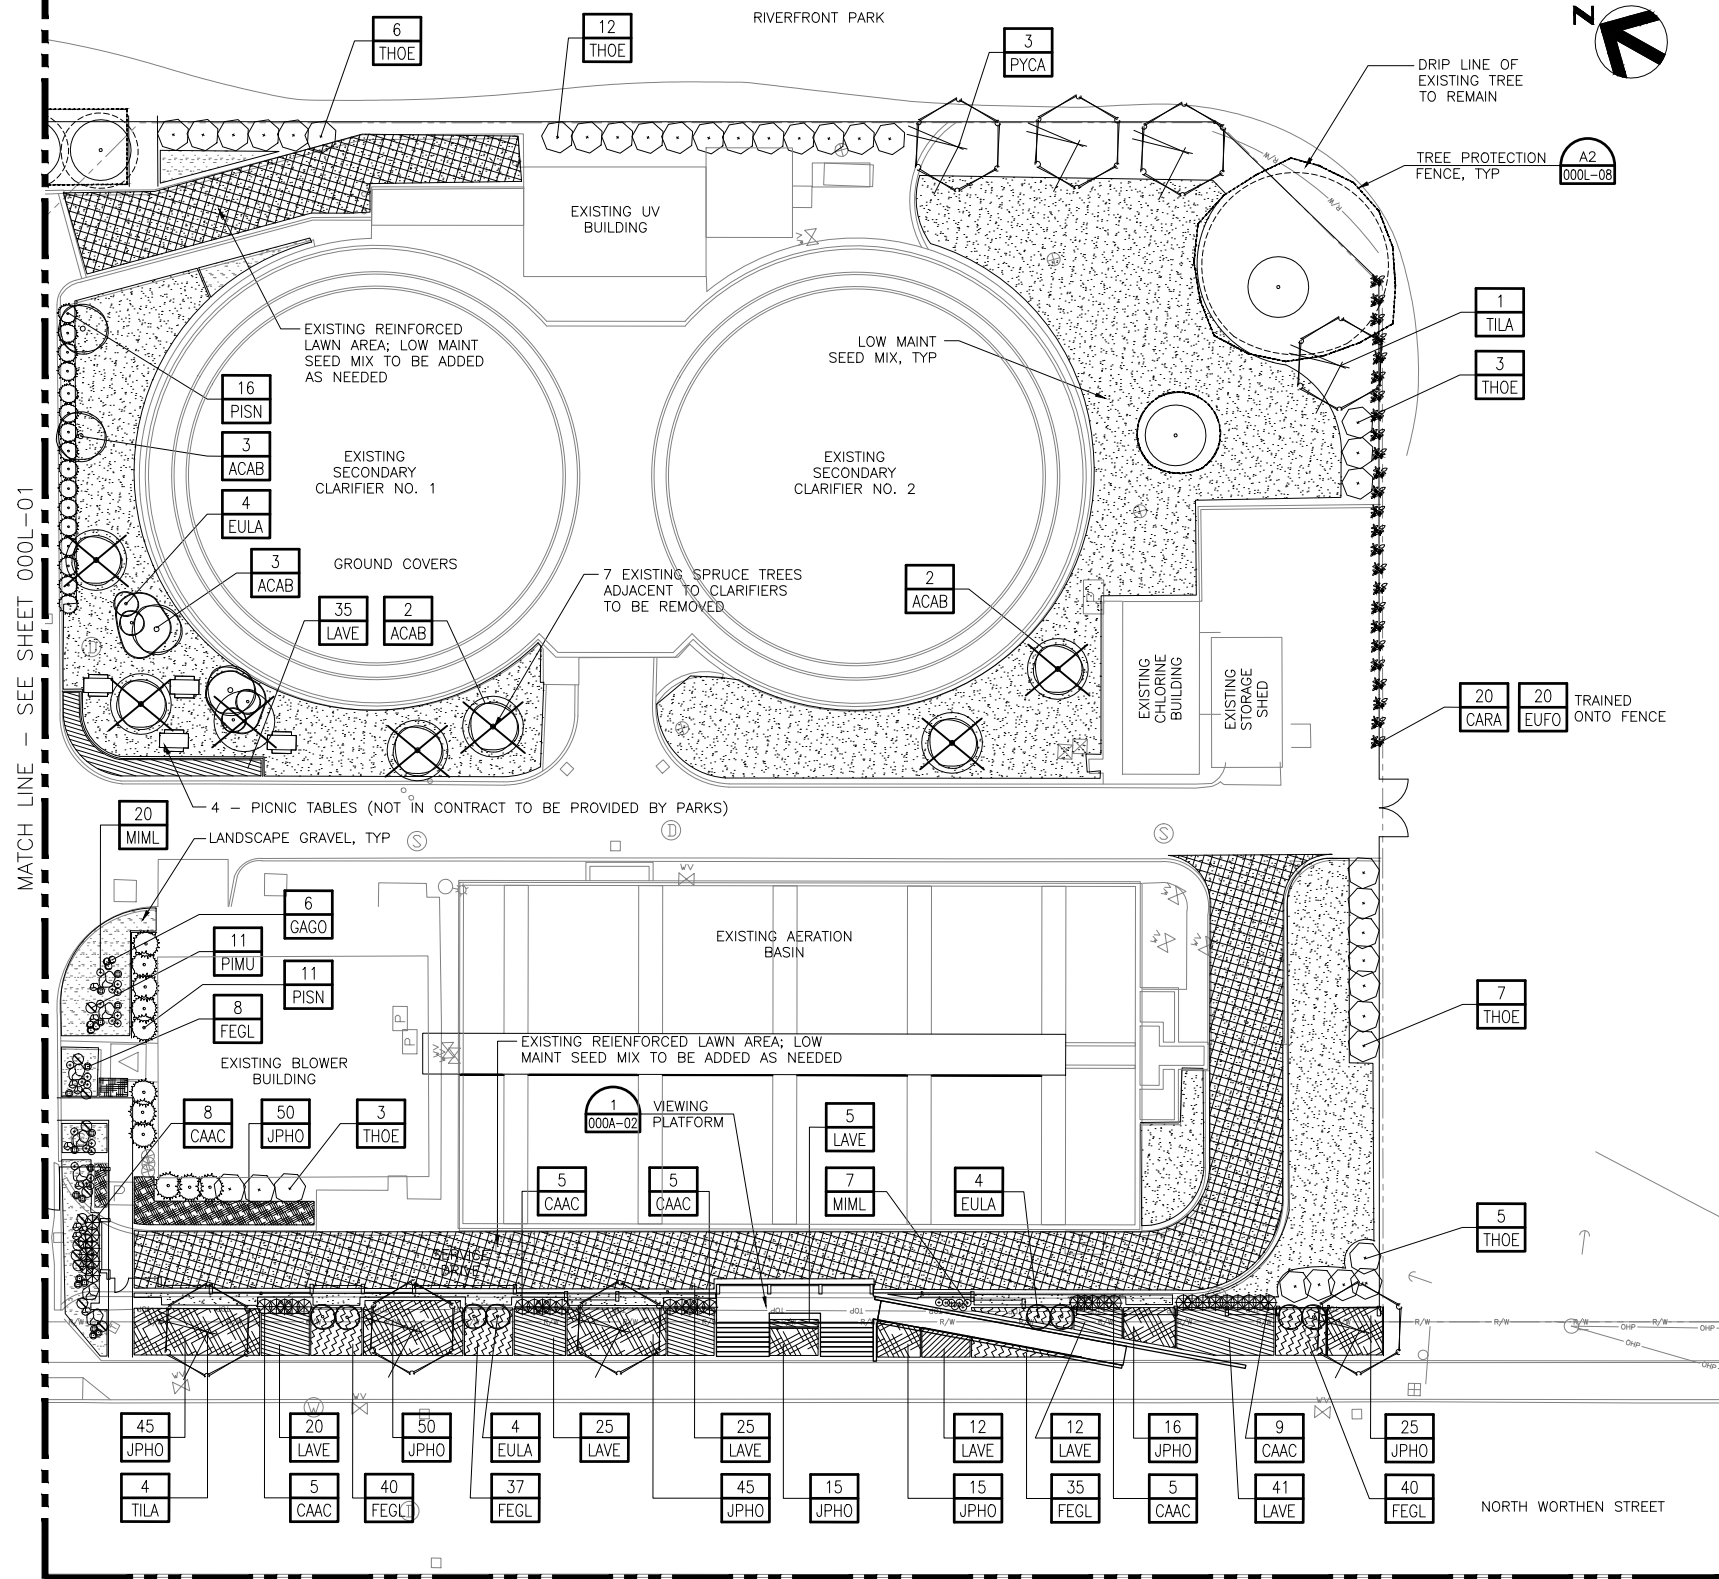

MATCH LINE - SEE SHEET 000L-03

LANDSCAPE PLAN - SOUTH


1'-0" = 20'-0"

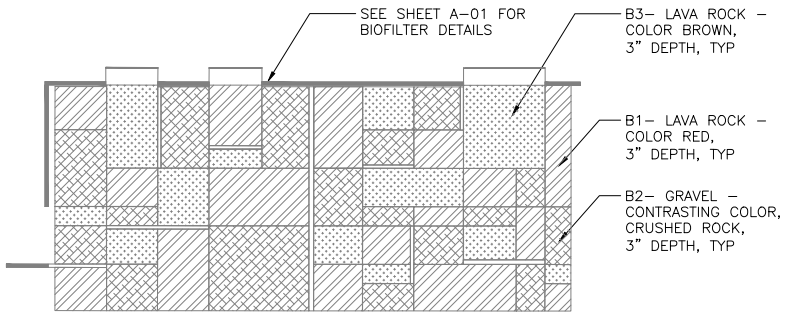

BIOFILTER GRAVEL PLAN

1'-0" = 20'-0"

2
000L-01

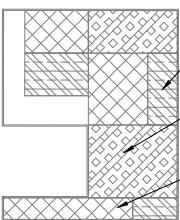

NEW SCREENINGS BUILDING
ROOF GRAVEL PLAN

1'-0" = 20'-0"


3
000L-01

GENERAL NOTES

- SEE SHEET 000L-07 FOR PLANT MATERIAL SCHEDULE, QUANTITIES, SPECIES AND SIZES
- SEE SHEET 000C-01 FOR SITE PLAN
- ALL PLANT MATERIAL TO BE IRRIGATED; SEE SHEET 000-L04 AND 000-L06 FOR IRRIGATION PLANS
- CALL BEFORE DIGGING: DIAL 811 MIN 2 DAYS IN ADVANCE

LEGEND

- EXISTING TREE TO REMAIN
- EXISTING TREE TO BE REMOVED
- EXISTING TREE DRIPLINE
- EVERGREEN TREE
- DECIDUOUS TREE
- SHRUBS/UNDERSTORY
- SMALL SHRUBS / GROUNDCOVERS
- LANDSCAPE BOULDERS
- PLANT MATERIAL TAG
- GROUND COVERS
- ORNAMENTAL GRASSES
- LOW MAINTENANCE SEEDED LAWN
- EXISTING REINFORCED LAWN RESEED WITH LOW MAINT SEED AS NECESSARY
- LANDSCAPE GRAVEL
- B1- LAVA ROCK - COLOR RED
- B2- GRAVEL - CONTRASTING COLOR
- B3- LAVA ROCK - COLOR BROWN
- R1- LAVA ROCK - COLOR RED
- R2- GRAVEL - CONTRASTING COLOR
- R3- LAVA ROCK - COLOR BROWN

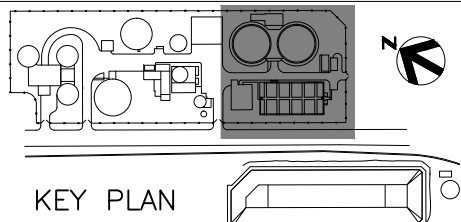

KEY PLAN



| ISSUE | DATE | DESCRIPTION |
|-------|----------|----------------------------------|
| 1 | APR 2014 | RECORD DRAWINGS |
| 0 | NOV 2011 | ISSUE FOR CONSTRUCTION SUBMITTAL |

| | |
|-----------------|-------------------------|
| PROJECT MANAGER | A. MEILLEUR |
| DESIGNED | B. POWERS/ S. HOEBER |
| DRAWN | S. HOEBER |
| CHECKED | G. LAI |
| PROJECT NUMBER | 171097 |

ELECTRONIC SEAL AND
SIGNATURE HAS BEEN
REMOVED. THIS MEDIA
SHOULD NOT BE CONSIDERED
A CERTIFIED DOCUMENT




LANDSCAPE PLAN
SOUTH



| | | |
|----------|-------------|---------|
| FILENAME | 000L-02.dwg | SHEET |
| SCALE | AS NOTED | 000L-02 |


ELECTRONIC MEDIA DISCLAIMER: THIS ELECTRONIC MEDIA PROVIDED BY HDR ENGINEERING, INC. IS SUBJECT TO AN ELECTRONIC MEDIA RELEASE. ALL USE AND RE-USE OF THIS MEDIA IS SUBJECT TO THE TERMS AND CONDITIONS OF THE RELEASE.

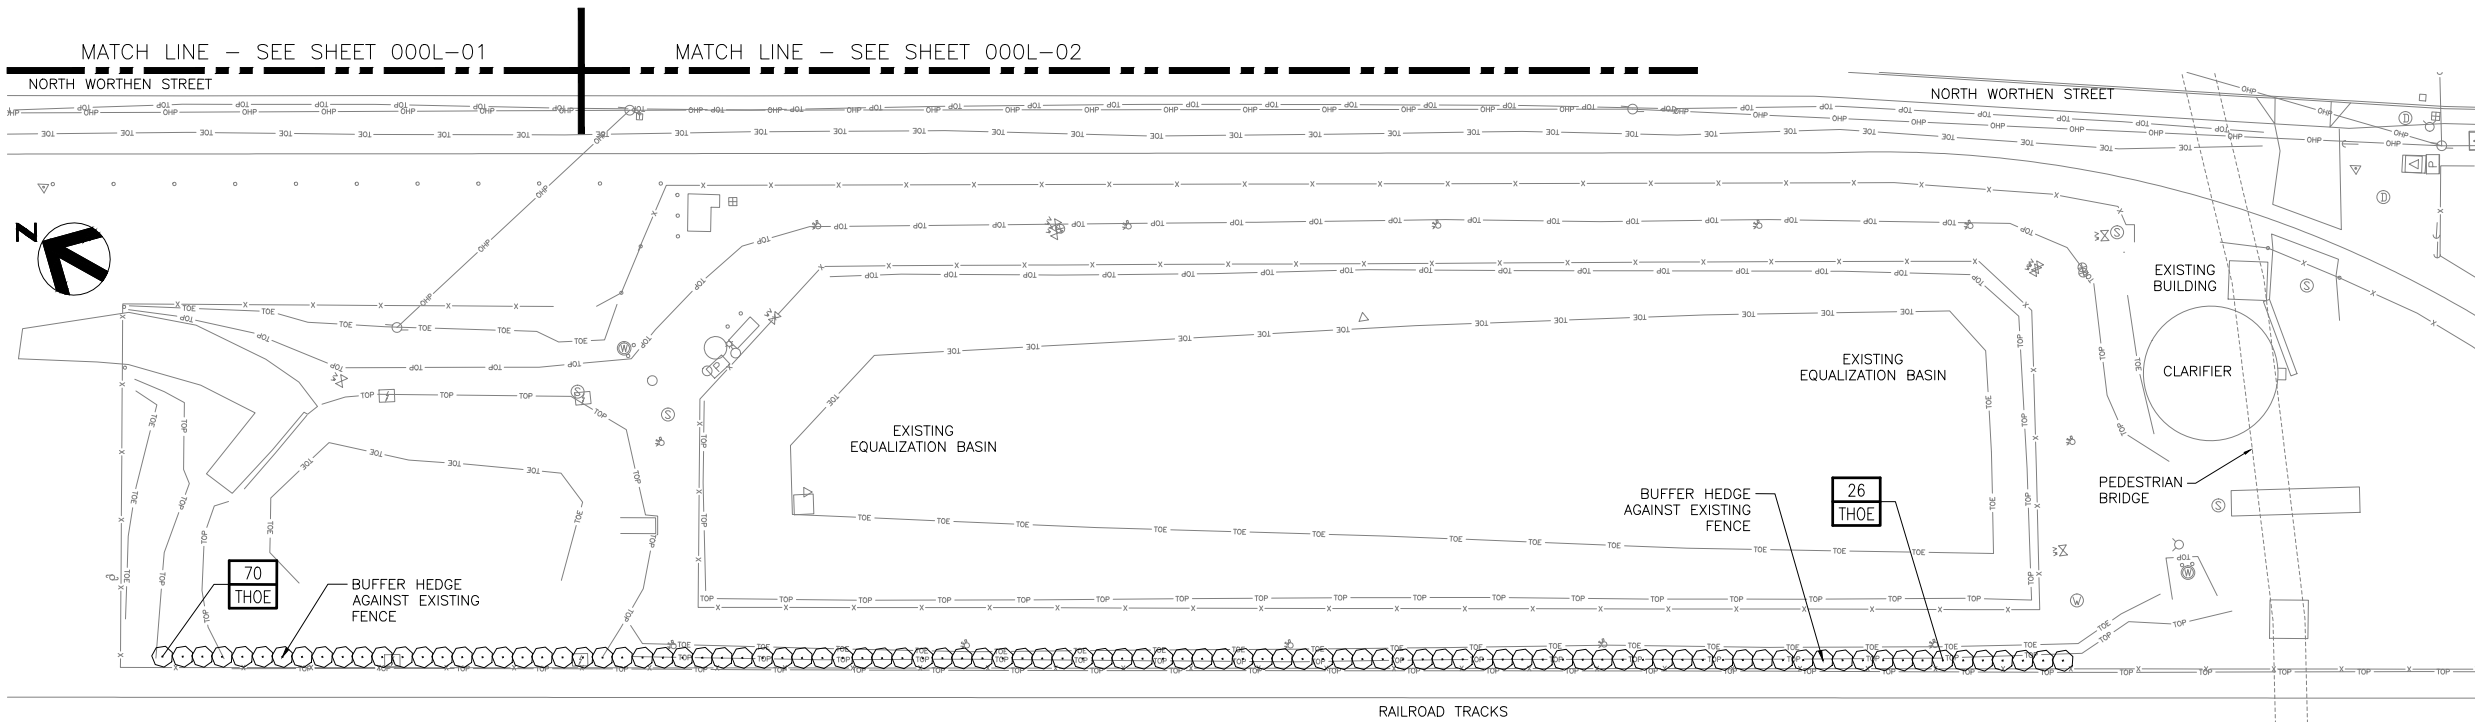

LANDSCAPE PLAN – EQUALIZATION BASIN NORTH
1"=0" = 30'-0"

- GENERAL NOTES
- SEE SHEET 000L-07 FOR PLANT MATERIAL SCHEDULE, QUANTITIES, SPECIES AND SIZES
 - SEE SHEET 000C-01 FOR SITE PLAN
 - ALL PLANT MATERIAL TO BE IRRIGATED; SEE SHEET 000-L04 AND 000-L06 FOR IRRIGATION PLANS
 - CALL BEFORE DIGGING: DIAL 811 MIN 2 DAYS IN ADVANCE

- LEGEND
- EXISTING TREE TO REMAIN
 - EXISTING TREE TO BE REMOVED
 - EXISTING TREE DRIPLINE
 - EVERGREEN TREE
 - DECIDUOUS TREE
 - SHRUBS/UNDERSTORY
 - SMALL SHRUBS / GROUNDCOVERS
 - LANDSCAPE BOULDERS
 - PLANT MATERIAL TAG
 - GROUND COVERS
 - ORNAMENTAL GRASSES
 - LOW MAINTENANCE SEEDED LAWN
 - EXISTING REINFORCED LAWN RESEED WITH LOW MAINT SEED AS NECESSARY
 - LANDSCAPE GRAVEL
 - B1- LAVA ROCK – COLOR RED
 - B2- GRAVEL – CONTRASTING COLOR
 - B3- LAVA ROCK – COLOR BROWN
 - R1- LAVA ROCK – COLOR RED
 - R2- GRAVEL – CONTRASTING COLOR
 - R3- LAVA ROCK – COLOR BROWN

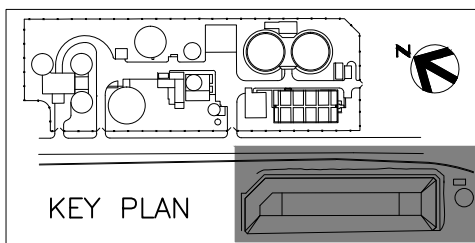

| | | |
|-------|----------|----------------------------------|
| | | |
| | | |
| | | |
| | | |
| 1 | APR 2014 | RECORD DRAWINGS |
| 0 | NOV 2011 | ISSUE FOR CONSTRUCTION SUBMITTAL |
| ISSUE | DATE | DESCRIPTION |

| | |
|-----------------|-------------------------|
| PROJECT MANAGER | A. MEILLEUR |
| DESIGNED | B. POWERS/ S. HOEBER |
| DRAWN | S. HOEBER |
| CHECKED | G. LAI |
| PROJECT NUMBER | 171097 |

ELECTRONIC SEAL AND
SIGNATURE HAS BEEN
REMOVED. THIS MEDIA
SHOULD NOT BE CONSIDERED
A CERTIFIED DOCUMENT




LANDSCAPE PLAN
EQUALIZATION BASIN

0 1" 2"

| | | |
|----------|-------------|---------|
| FILENAME | 000L-03.dwg | SHEET |
| SCALE | AS NOTED | 000L-03 |

ELECTRONIC MEDIA DISCLAIMER: THIS ELECTRONIC MEDIA PROVIDED BY HDR ENGINEERING, INC. IS SUBJECT TO AN ELECTRONIC MEDIA RELEASE. ALL USE AND RE-USE OF THIS MEDIA IS SUBJECT TO THE TERMS AND CONDITIONS OF THE RELEASE.

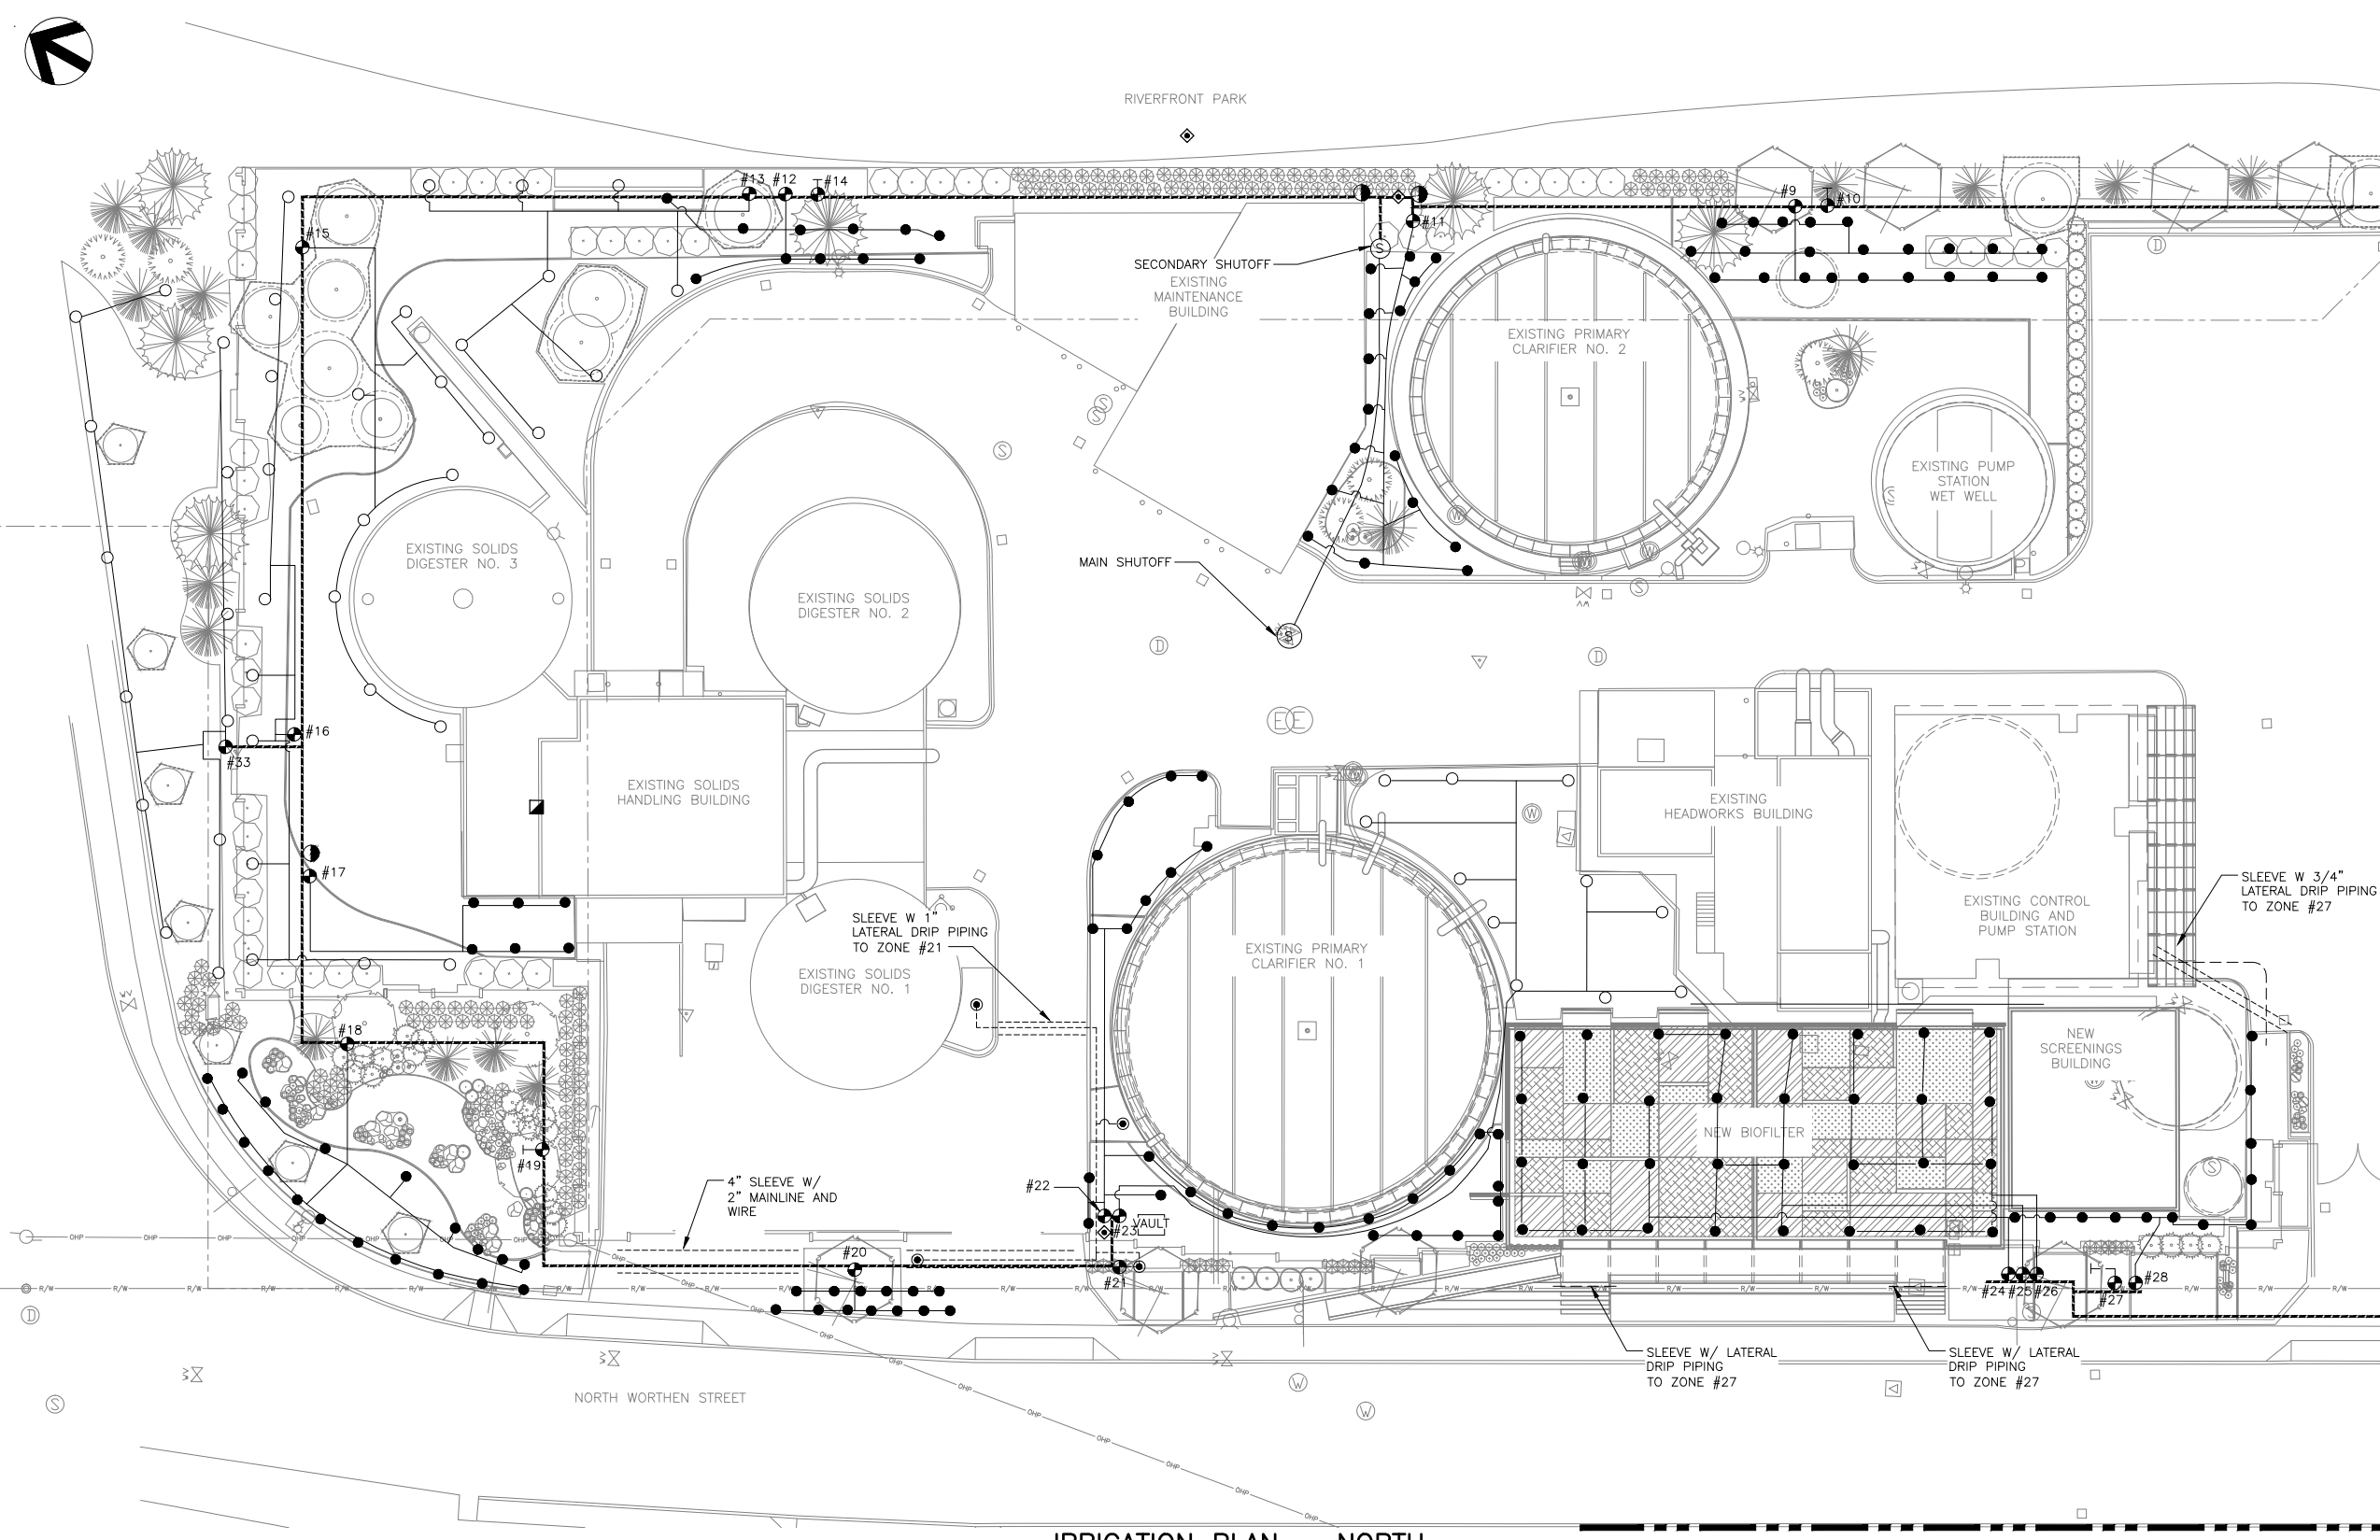


- GENERAL NOTES
1. ALL TREES TO BE ON A SEPARATE ZONE WITH DRIP TUBES
 2. VALVE BOXES TO BE LOCATED IN LANDSCAPE BEDS
 3. ALL RAINBIRD HEADS TO BE INSTALLED WITH MATCHED PRECIPITATION RATE (MPR) NOZZLES
 4. SPRAY ZONES TO BE OPERATED AT 30 PSI FOR OPTIMAL HEAD PERFORMANCE
 5. CALL BEFORE DIGGING: DIAL 811 MIN 2 DAYS IN ADVANCE

- LEGEND
- IRRIGATION SOURCE
 - IRRIGATION CONTROLLER
 - QUICK COUPLING VALVE
 - REMOTE CONTROL VALVE RAINBIRD PEB SERIES (1" & 1.5")
 - BACKFLOW PREVENTER FEBCO SERIES 825Y (1")
 - MASTER CONTROL VALVE RAINBIRD EFB-CP SERIES (1")
 - PRESSURE REGULATOR
 - WYE FILTER WILKINS S SERIES (1")
 - ISOLATION BALL VALVE DTL/L16
 - 2" MAINLINE
 - SLEEVING 4" PVC CLASS 200
 - PVC LATERAL LINE
 - PVC TO POLYETHYLENE CONNECTION
 - ROTOR HEAD
 - SPRAY HEAD
 - SPRAY HEAD FOR GRASS PAVE AREAS

MATCH LINE - SEE SHEET 000L-05

IRRIGATION PLAN - NORTH
1'-0" = 20'-0"

MATCH LINE - SEE SHEET 000L-06

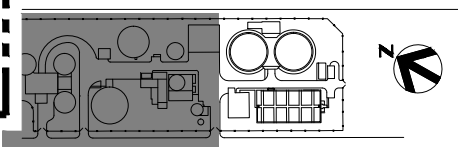

KEY PLAN

UNDERGROUND SERVICE ALERT
ONE-CALL NUMBER
1-800-424-5555
CALL TWO BUSINESS DAYS BEFORE YOU DIG


HDR
HDR Engineering, Inc.

| | | |
|-------|----------|----------------------------------|
| | | |
| | | |
| | | |
| | | |
| 1 | APR 2014 | RECORD DRAWINGS |
| 0 | NOV 2011 | ISSUE FOR CONSTRUCTION SUBMITTAL |
| ISSUE | DATE | DESCRIPTION |

| | |
|-----------------|-------------------------|
| PROJECT MANAGER | A. MEILLEUR |
| DESIGNED | B. POWERS/ S. HOEBER |
| DRAWN | S. HOEBER |
| CHECKED | G. LAI |
| PROJECT NUMBER | 171097 |

ELECTRONIC SEAL AND SIGNATURE HAS BEEN REMOVED. THIS MEDIA SHOULD NOT BE CONSIDERED A CERTIFIED DOCUMENT

City of Wenatchee
WASTE WATER TREATMENT PLANT IMPROVEMENTS

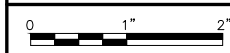

| | | | | | |
|-----------------------|----------|----------|-------------|-------|---------|
| IRRIGATION PLAN NORTH | | FILENAME | 000L-04.dwg | SHEET | 000L-04 |
| SCALE | AS NOTED | | | | |

ELECTRONIC MEDIA DISCLAIMER: THIS ELECTRONIC MEDIA PROVIDED BY HDR ENGINEERING, INC. IS SUBJECT TO AN ELECTRONIC MEDIA RELEASE. ALL USE AND RE-USE OF THIS MEDIA IS SUBJECT TO THE TERMS AND CONDITIONS OF THE RELEASE.

1

2

3


4

5

6

7

8

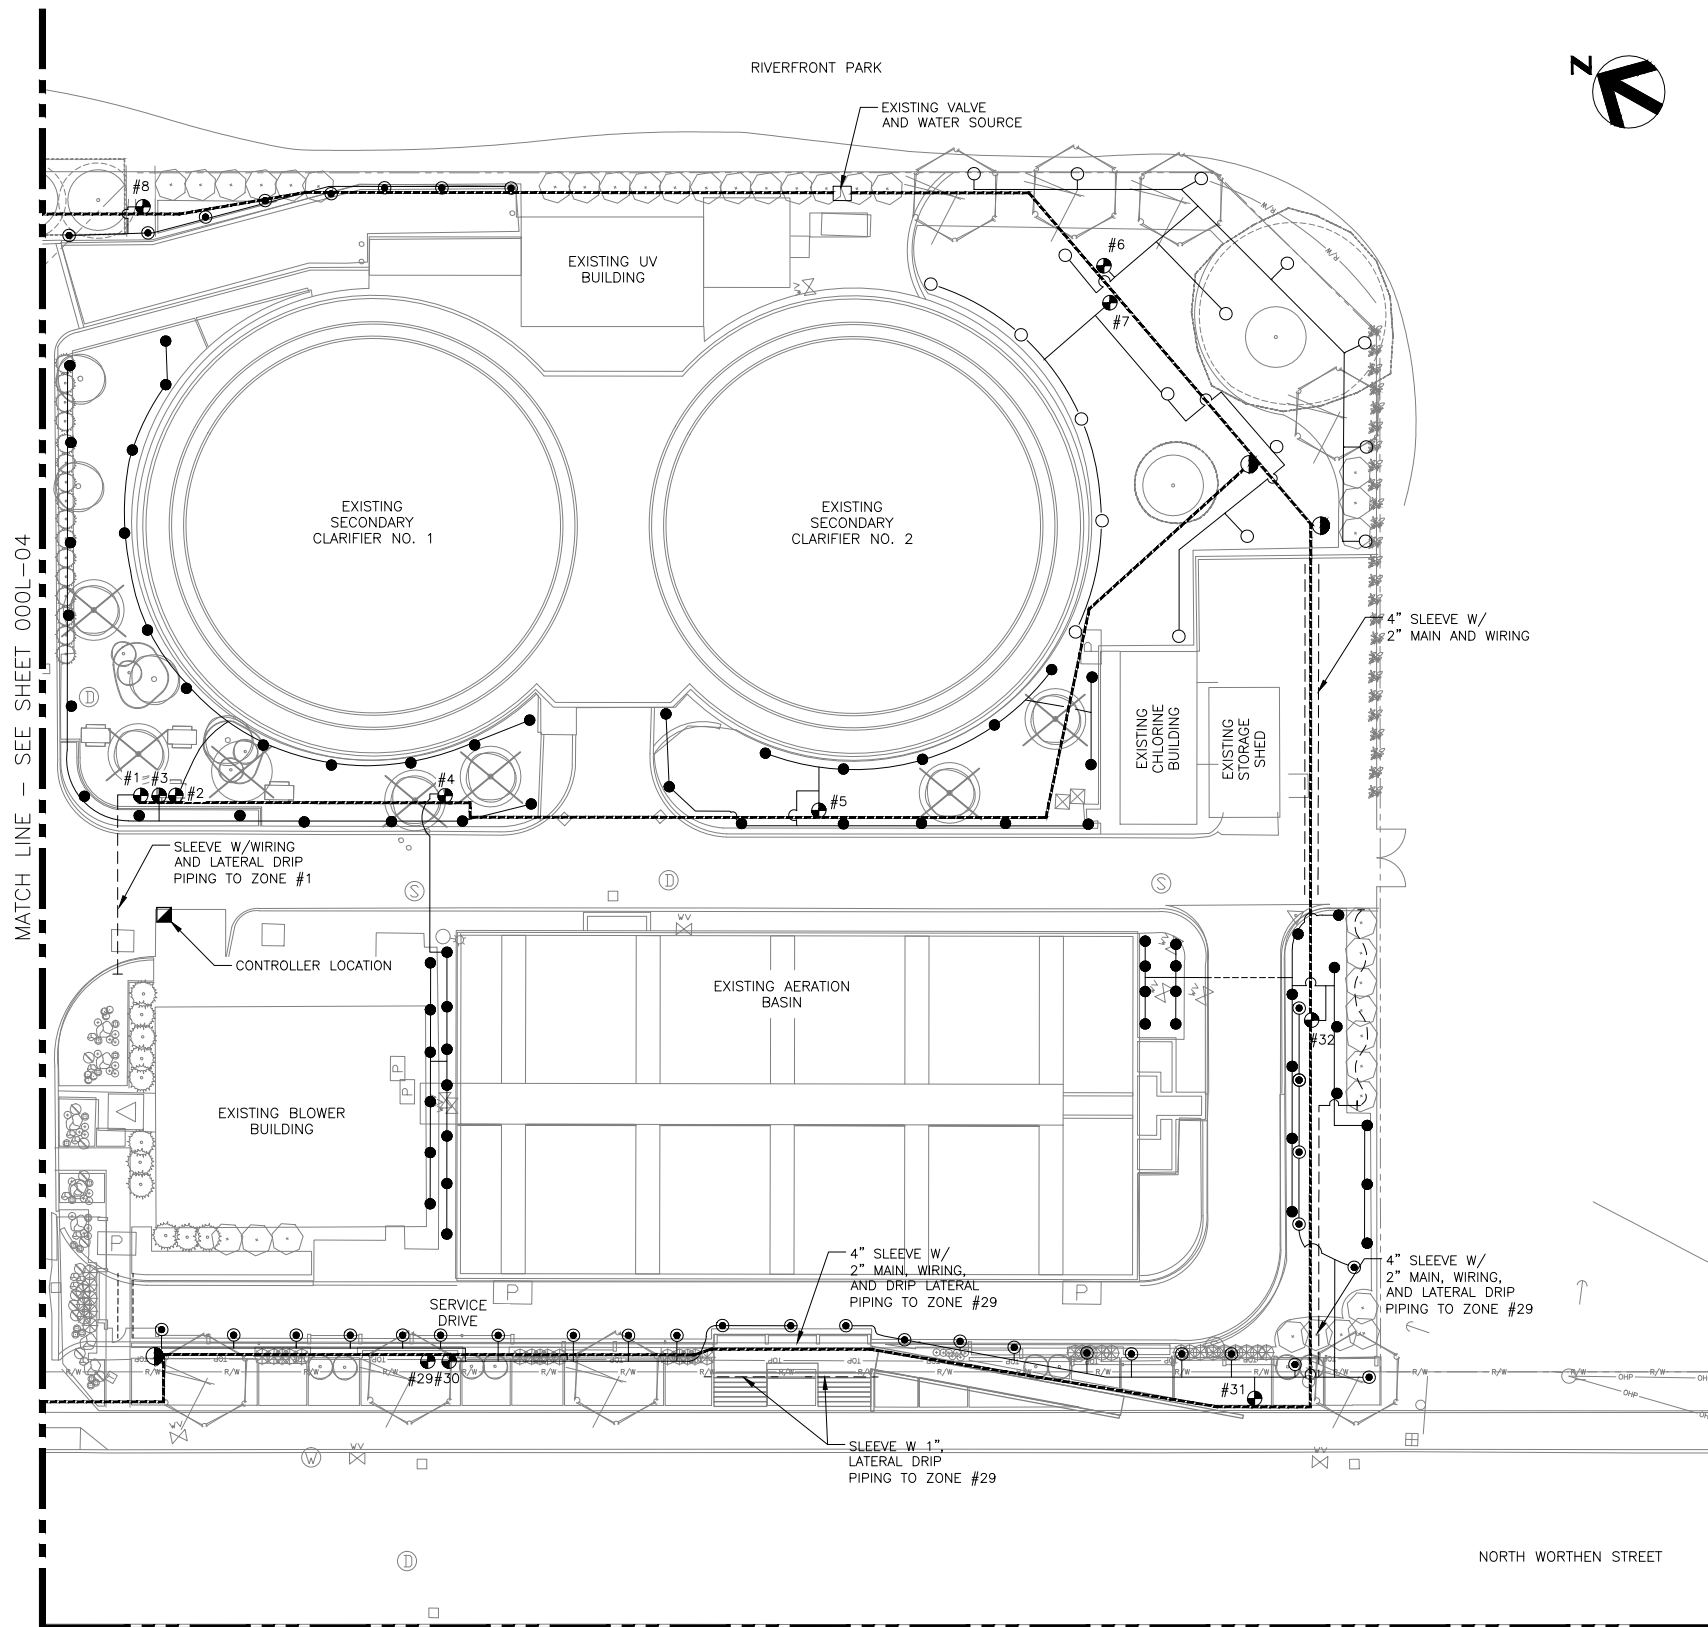


GENERAL NOTES

1. ALL TREES TO BE ON A SEPARATE ZONE WITH DRIP TUBES
2. VALVE BOXES TO BE LOCATED IN LANDSCAPE BEDS
3. ALL RAINBIRD HEADS TO BE INSTALLED WITH MATCHED PRECIPITATION RATE (MPR) NOZZLES
4. SPRAY ZONES TO BE OPERATED AT 30 PSI FOR OPTIMAL HEAD PERFORMANCE
5. CALL BEFORE DIGGING: DIAL 811 MIN 2 DAYS IN ADVANCE

LEGEND

- IRRIGATION SOURCE
- IRRIGATION CONTROLLER
- QUICK COUPLING VALVE
- REMOTE CONTROL VALVE RAINBIRD PEB SERIES (1" & 1.5")
- BACKFLOW PREVENTER FEBCO SERIES 825Y (1")
- MASTER CONTROL VALVE RAINBIRD EFB-CP SERIES (1")
- PRESSURE REGULATOR
- WYE FILTER WILKINS S SERIES (1")
- ISOLATION BALL VALVE DTL/L16
- 2" MAINLINE
- SLEEVING 4" PVC CLASS 200
- PVC LATERAL LINE
- PVC TO POLYETHYLENE CONNECTION
- ROTOR HEAD
- SPRAY HEAD
- SPRAY HEAD FOR GRASS PAVE AREAS

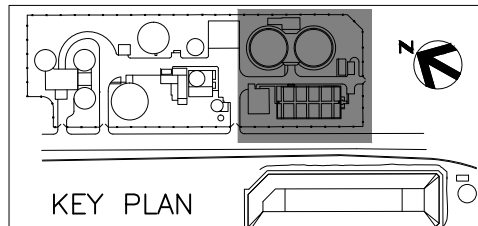

MATCH LINE - SEE SHEET 000L-06

IRRIGATION PLAN - SOUTH

1'-0" = 20'-0"



| | | |
|-------|----------|----------------------------------|
| | | |
| | | |
| | | |
| | | |
| 1 | APR 2014 | RECORD DRAWINGS |
| 0 | NOV 2011 | ISSUE FOR CONSTRUCTION SUBMITTAL |
| ISSUE | DATE | DESCRIPTION |

| | |
|-----------------|-------------------------|
| PROJECT MANAGER | A. MEILLEUR |
| DESIGNED | B. POWERS/ S. HOEBER |
| DRAWN | S. HOEBER |
| CHECKED | G. LAI |
| PROJECT NUMBER | 171097 |

ELECTRONIC SEAL AND
SIGNATURE HAS BEEN
REMOVED. THIS MEDIA
SHOULD NOT BE CONSIDERED
A CERTIFIED DOCUMENT




IRRIGATION PLAN
SOUTH



| | |
|----------|-------------|
| FILENAME | 000L-05.dwg |
| SCALE | AS NOTED |

| |
|---------|
| SHEET |
| 000L-05 |

ELECTRONIC MEDIA DISCLAIMER: THIS ELECTRONIC MEDIA PROVIDED BY HDR ENGINEERING, INC. IS SUBJECT TO AN ELECTRONIC MEDIA RELEASE. ALL USE AND RE-USE OF THIS MEDIA IS SUBJECT TO THE TERMS AND CONDITIONS OF THE RELEASE.

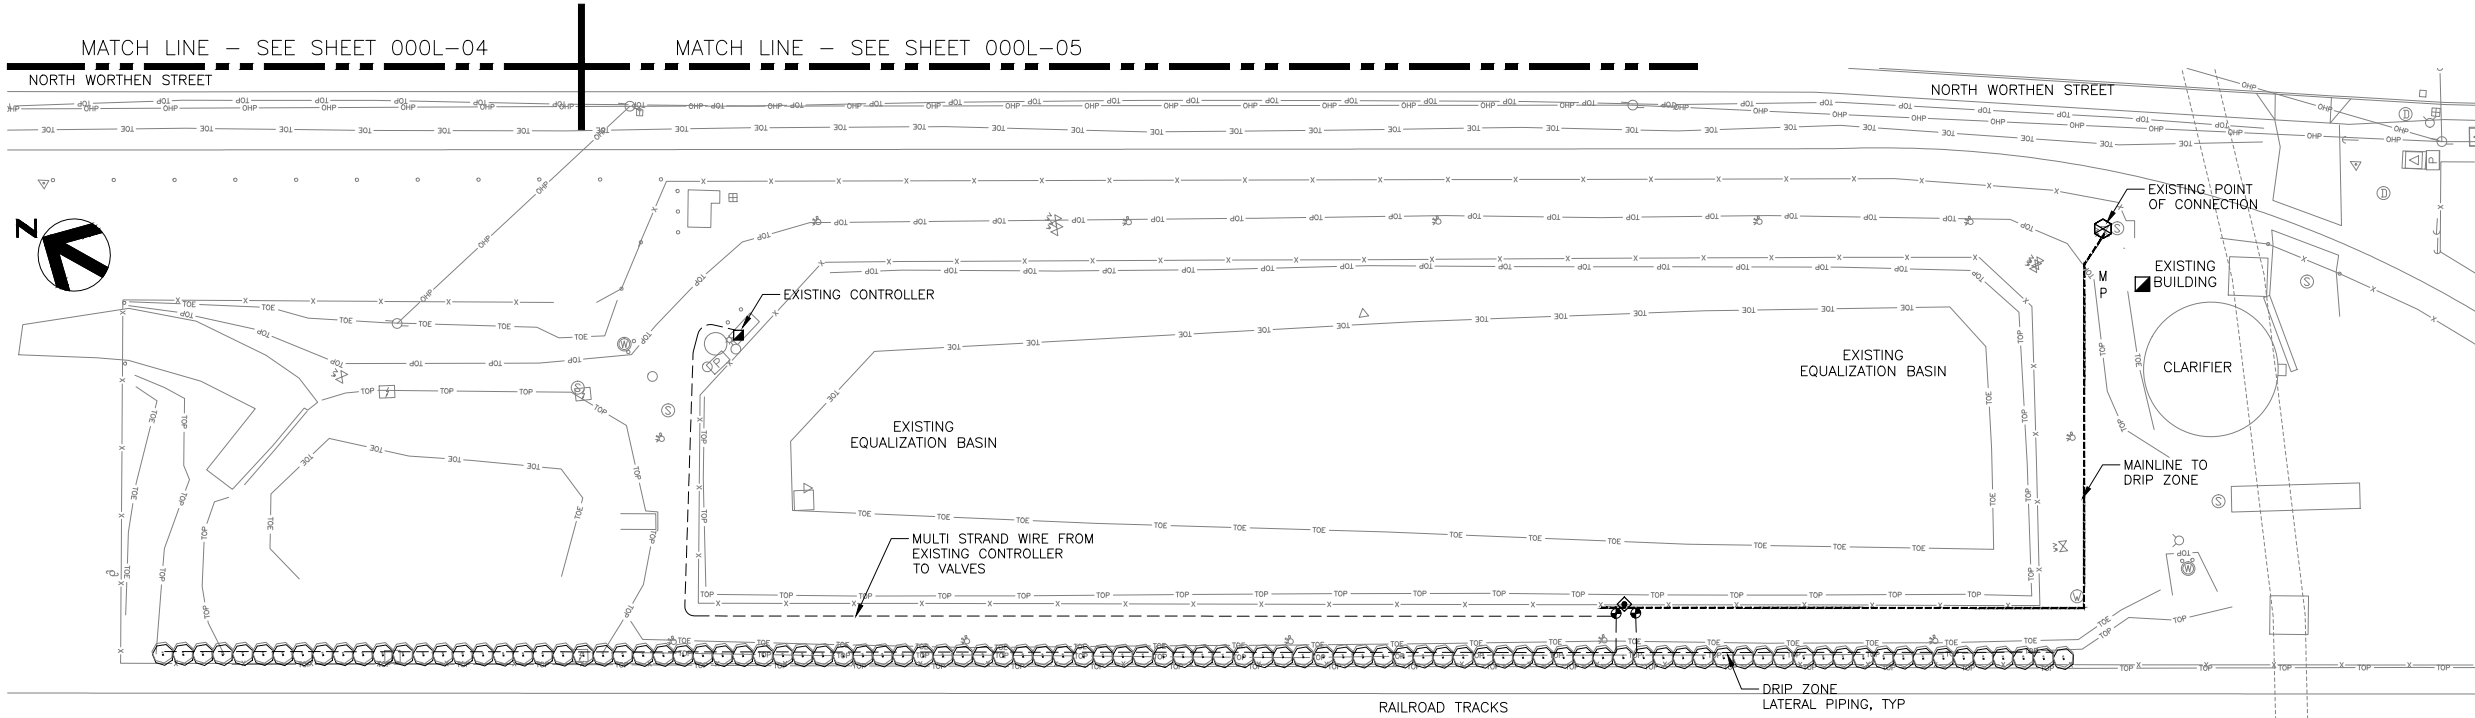

IRRIGATION PLAN – EQUALIZATION BASIN NORTH
1"=0" = 30'-0"


#31

GENERAL NOTES

1. ALL TREES TO BE ON A SEPARATE ZONE WITH DRIP TUBES
2. VALVE BOXES TO BE LOCATED IN LANDSCAPE BEDS
3. ALL RAINBIRD HEADS TO BE INSTALLED WITH MATCHED PRECIPITATION RATE (MPR) NOZZLES
4. SPRAY ZONES TO BE OPERATED AT 30 PSI FOR OPTIMAL HEAD PERFORMANCE
5. CALL BEFORE DIGGING: DIAL 811 MIN 2 DAYS IN ADVANCE

LEGEND

- IRRIGATION SOURCE
- IRRIGATION CONTROLLER
- QUICK COUPLING VALVE
- REMOTE CONTROL VALVE RAINBIRD PEB SERIES (1" & 1.5")
- BACKFLOW PREVENTER FEBCO SERIES 825Y (1")
- MASTER CONTROL VALVE RAINBIRD EFB-CP SERIES (1")
- PRESSURE REGULATOR
- WYE FILTER WILKINS S SERIES (1")
- ISOLATION BALL VALVE DTL/L16
- 2" MAINLINE
- SLEEVING 4" PVC CLASS 200
- PVC LATERAL LINE
- PVC TO POLYETHYLENE CONNECTION
- ROTOR HEAD
- SPRAY HEAD
- SPRAY HEAD FOR GRASS PAVE AREAS

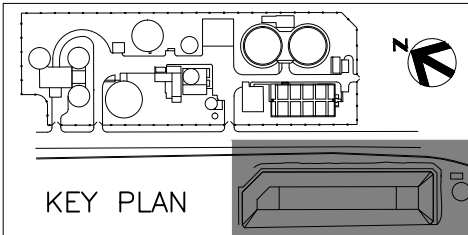

KEY PLAN



| ISSUE | DATE | DESCRIPTION |
|-------|----------|----------------------------------|
| 1 | APR 2014 | RECORD DRAWINGS |
| 0 | NOV 2011 | ISSUE FOR CONSTRUCTION SUBMITTAL |

| | |
|-----------------|-------------------------|
| PROJECT MANAGER | A. MEILLEUR |
| DESIGNED | B. POWERS/ S. HOEBER |
| DRAWN | S. HOEBER |
| CHECKED | G. LAI |
| PROJECT NUMBER | 171097 |

ELECTRONIC SEAL AND
SIGNATURE HAS BEEN
REMOVED. THIS MEDIA
SHOULD NOT BE CONSIDERED
A CERTIFIED DOCUMENT




IRRIGATION PLAN
EQUALIZATION BASIN



| | |
|----------|-------------|
| FILENAME | 000L-06.dwg |
| SCALE | AS NOTED |

| | |
|-------|---------|
| SHEET | 000L-06 |
|-------|---------|


ELECTRONIC MEDIA DISCLAIMER: THIS ELECTRONIC MEDIA PROVIDED BY HDR ENGINEERING, INC. IS SUBJECT TO AN ELECTRONIC MEDIA RELEASE. ALL USE AND RE-USE OF THIS MEDIA IS SUBJECT TO THE TERMS AND CONDITIONS OF THE RELEASE.

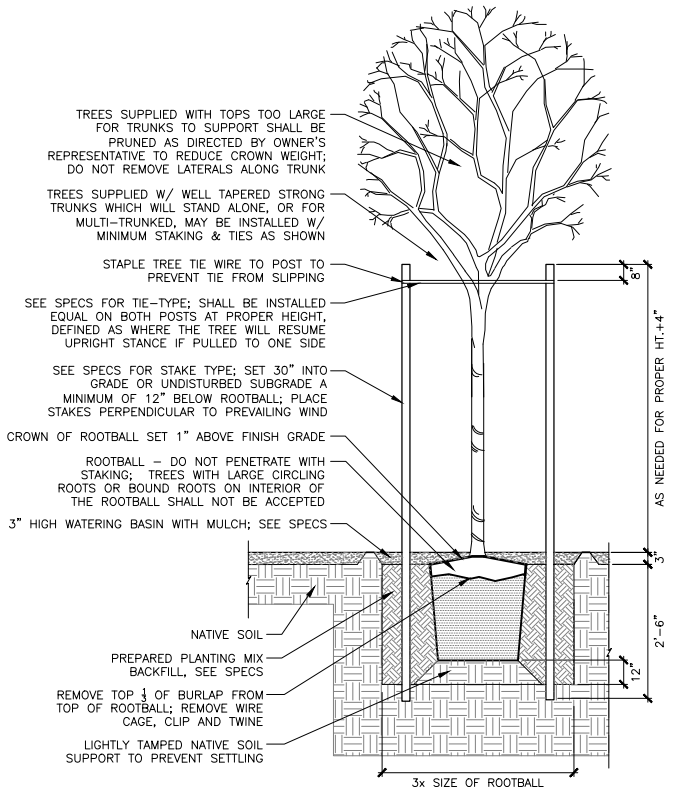

DECIDUOUS TREE PLANTING

NOT TO SCALE


A1
000L-07

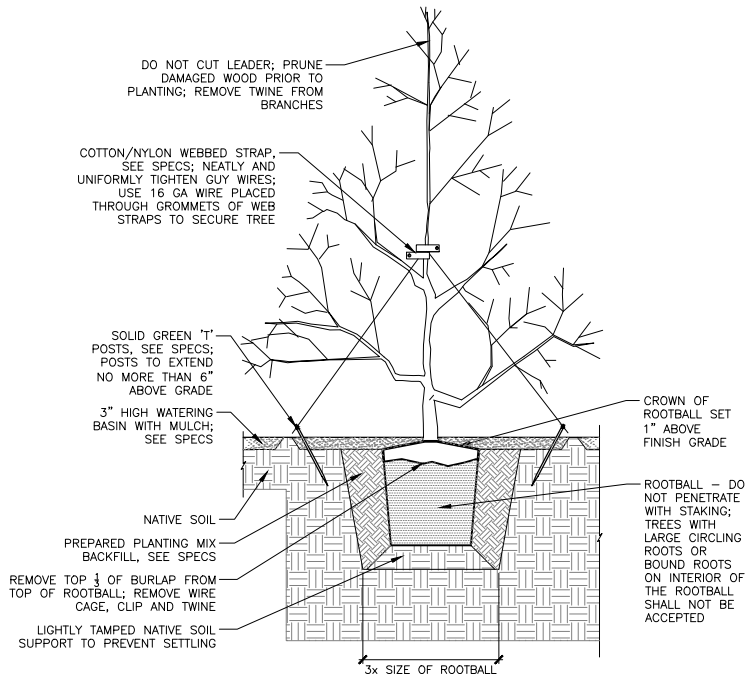

EVERGREEN TREE PLANTING

NOT TO SCALE


A2
000L-07

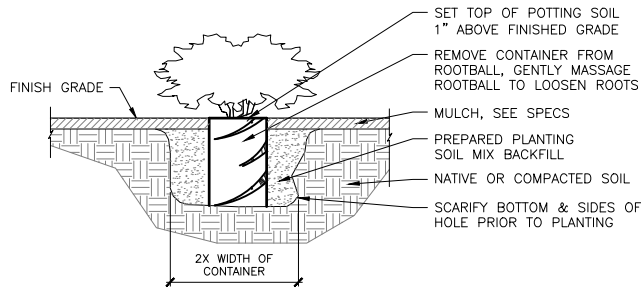


SHRUBS PLANTING

NOT TO SCALE

B1
000L-07

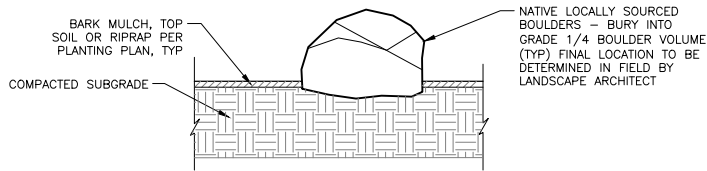

HORIZONTAL INSTALL

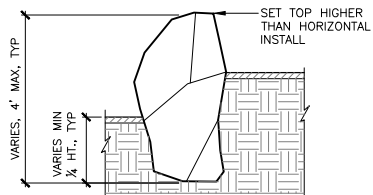

VERTICAL INSTALL

- NOTES:
- REGIONAL NATURAL BOULDERS COMMON TO LOCAL AREA
 - BOULDERS SHOULD BE PLACED W/APPROVAL FROM ENGINEER
 - ABOVE GRADE HT. WILL VARY AS BOULDERS MUST BE PLACED IN GROUND 1/4 THEIR TOTAL DIMENSION
 - SEE PLAN FOR LAYOUT ARRANGEMENT AND SIZE


LARGE
2-3 MAN BOULDER - 4'-5' DIAMETER

SMALL
2 MAN BOULDER - 2'-3' DIAMETER

LANDSCAPE BOULDERS

NOT TO SCALE

B2
000L-07

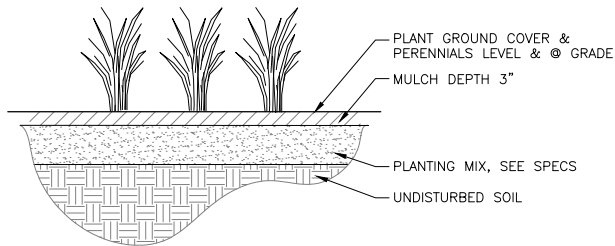

PERENNIAL & GROUND COVER

NOT TO SCALE

B3
000L-07

PLANTING SCHEDULE

| TREES | | | | |
|-----------------------|------|--|--------------------------------------|---|
| QUANTITY | KEY | BOTANICAL NAME | COMMON NAME | NOTES |
| 4 | ACAB | ACER RUBRUM 'KARPICK' | KARPICK RED MAPLE | B&B, 2" CAL |
| 3 | CHOG | CUPRESSOCYPARIS LEYLANDII | LEYLAND CYPRESS | 15 GALLON CONT. |
| 6 | FREA | FRAXINUS PENNSYLVANICA 'SUMMIT' | 'SUMMIT' GREEN ASH | 2" CAL |
| 16 | JPVA | CUPRESSOCYPARIS LEYLANDII | LEYLAND CYPRESS | 5 GALLON CONT |
| 6 | PIFL | PINUS FLEXILIS 'VANDERWOLF'S PYRAMID' | VANDERWOLF'S PYRAMID PINE | 4'-5' HT |
| 9 | PYCA | PYRUS CALLERYANA 'CAPITAL' | CAPITAL PEAR | 2" CAL BALL & BURLAP |
| 9 | TIJA | ACER RUBRUM 'FAIRVIEW FLAME' | FAIRVIEW FLAME RED MAPLE | |
| 184 | THOE | THUJA OCCIDENTALIS 'EMERALD' | EMERALD AMERICAN ARBORVITAE | 3'-5' HT, FULL |
| 10 | THOR | THUJA OCCIDENTALIS 'RHEINGOLD' | RHEINGOLD AMERICAN ARBORVITAE | 5 GALLON CONT |
| 247 | | TOTAL | | |
| SHRUBS & GROUNDCOVERS | | | | |
| QUANTITY | KEY | BOTANICAL NAME | COMMON NAME | SIZE & CONDITION |
| 17 | EULA | EUONYMUS ALATA | BURNING BUSH | 2 GALLON CONT |
| 26 | GAGO | GAILLARDIA GRANDIFLORA 'GOBLIN' | GOBLIN BLANKET FLOWER | 6" POT, FULL |
| 165 | HEFU | HEMEROCALLIS 'STELLA DE ORO' | DWARF DAYLILY | 1 GALLON CONT, FULL |
| 561 | JPHO | DIANTHUS CARYOPHYLLUS | PINK AND RED DIANTHUS | 1 GALLON CONT, FULL |
| 5 | JPSQ | JUNIPERUS SQUAMATA 'BLUE STAR' | BLUE STAR JUNIPER | 1 GALLON CONT, FULL |
| 340 | LAVE | LAVANDULA ANGUSTIFOLIA 'MUNSTEAD' | MUNSTEAD LAVENDER | 1 GALLON CONT, FULL |
| 20 | PIMU | PINUS MUGO 'COMPACTA' | COMPACT MUGO PINE | 1 GALLON CONT, FULL |
| 56 | PISN | PINUS STROBUS 'BLUE SHAG' | EASTERN WHITE PINE | 2 GALLON CONT |
| 7 | YUFI | YUCCA FILAMENTOSA | ADAM'S NEEDLE | 1 GALLON CONT, FULL |
| 1197 | | TOTAL | | |
| GRASSES | | | | |
| QUANTITY | | BOTANICAL NAME | COMMON NAME | SIZE & CONDITION |
| 181 | CAAC | CALAMAGROSTIS ACUTIFLORA 'KARL FOERS.' | KARL FOERSTER FEATHER REED GRASS | 1 GALLON CONT, FULL |
| 85 | MISL | MISCANTHUS SINENSIS 'SILBERFEDER' | SILVER FEATHER GRASS | 1 GAL, FULL |
| 107 | MIML | MISCANTHUS SINENSIS 'MORNING LIGHT' | MORNING LIGHT MISCANTHUS | 1 GAL, FULL |
| 517 | FEGF | FESTUCA GLAUCA 'SEA URCHIN' | SEA URCHIN BLUE FESCUE | 1 GALLON CONT, FULL |
| 890 | | TOTAL | | |
| VINES | | | | |
| QUANTITY | | BOTANICAL NAME | COMMON NAME | SIZE & CONDITION |
| 20 | CARA | CAMPESIS RADICANS | TRUMPET VINE | 1 GALLON CONT, 18" OC, TRAINED ON FENCE |
| 20 | EUFO | EUONYMUS FORTUNEI | WINTERCREEPER | 1 GALLON CONT, 18" OC, TRAINED ON FENCE |
| 40 | | TOTAL | | |
| SEED MIXES | | | | |
| QUANTITY | | TYPE | SEED MIX | NOTES |
| 2,564 | SF | SEED TYPE A - 'LAWN' | MOUNTAIN VIEW MIX | OR APPROVED EQUAL, SEE SPECIFICATIONS |
| 2,564 | SF | TOTAL | | |
| | CY | BARK DUST | 3" DEPTH - IN ALL LANDSCAPE BEDS | SEE SPECIFICATIONS, ENGINEER APPROVED |
| 15 | CY | LANDSCAPE GRAVEL | LOCAL ROUND RIVER ROCK - 3" DEPTH | SEE SPECIFICATIONS, ENGINEER APPROVED |
| 18 | CY | B1 GRAVEL - BIOFILTER COVER | LAVA ROCK - COLOR RED | SEE SPECIFICATIONS, ENGINEER APPROVED |
| 17 | CY | B2 GRAVEL - BIOFILTER COVER | CONTRASTING COLOR CRUSHED ROCK | SEE SPECIFICATIONS, ENGINEER APPROVED |
| 11 | CY | B3 GRAVEL - BIOFILTER COVER | LAVA ROCK - COLOR BROWN | SEE SPECIFICATIONS, ENGINEER APPROVED |
| | CY | R1 GRAVEL - ROOF COVER | LAVA ROCK - COLOR RED | SEE SPECIFICATIONS, ENGINEER APPROVED |
| | CY | R2 GRAVEL - ROOF COVER | CONTRASTING COLOR CRUSHED GRAVEL | SEE SPECIFICATIONS, ENGINEER APPROVED |
| | CY | R3 GRAVEL - ROOF COVER | LAVA ROCK - COLOR BROWN | SEE SPECIFICATIONS, ENGINEER APPROVED |
| 61 | CY | TOTAL | | |
| 52 | EA | LANDSCAPE BOULDERS | LOCAL REGIONAL STONE (2-3 MAN SIZED) | SEE SPECIFICATIONS, ENGINEER APPROVED |

- NOTE:
- PLANTINGS AT NORTH GATE ENTRY - COLUMNAR HORNBEAM, BURNING BUSH, DIANTHUS
 - DIANTHUS TYPES: "FIVE STAR", "SHOOTING STAR", "RASPBERRY SURPRISE"




| ISSUE | DATE | DESCRIPTION |
|-------|----------|----------------------------------|
| 1 | APR 2014 | RECORD DRAWINGS |
| 0 | NOV 2011 | ISSUE FOR CONSTRUCTION SUBMITTAL |

| | |
|-----------------|-------------------------|
| PROJECT MANAGER | A. MEILLEUR |
| DESIGNED | B. POWERS/ S. HOEBER |
| DRAWN | S. HOEBER |
| CHECKED | G. LAI |
| PROJECT NUMBER | 171097 |

ELECTRONIC SEAL AND SIGNATURE HAS BEEN REMOVED. THIS MEDIA SHOULD NOT BE CONSIDERED A CERTIFIED DOCUMENT




PLANTING DETAILS

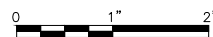

FILENAME 000L-07.dwg
SCALE AS NOTED


SHEET
000L-07

ELECTRONIC MEDIA DISCLAIMER: THIS ELECTRONIC MEDIA PROVIDED BY HDR ENGINEERING, INC. IS SUBJECT TO AN ELECTRONIC MEDIA RELEASE. ALL USE AND RE-USE OF THIS MEDIA IS SUBJECT TO THE TERMS AND CONDITIONS OF THE RELEASE.

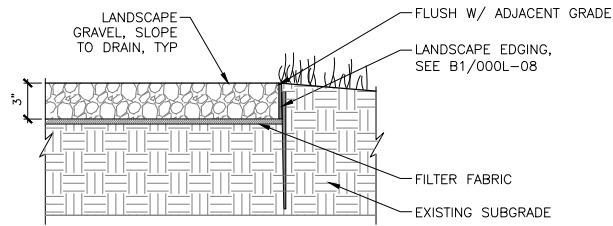


LANDSCAPE GRAVEL
NOT TO SCALE

A1
000L-08

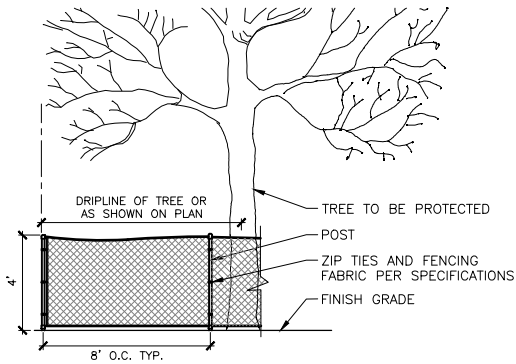


TREE PROTECTION FENCING
NOT TO SCALE

A2
000L-08

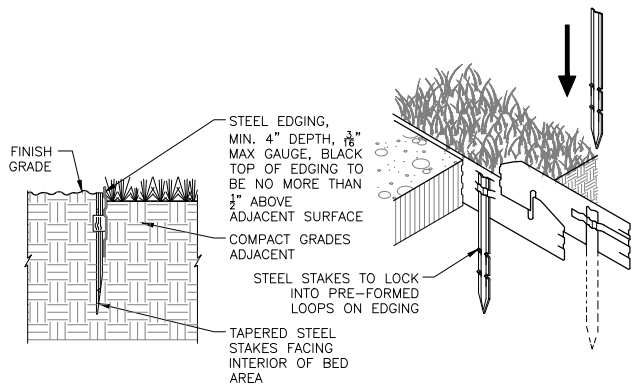

LANDSCAPE EDGING
NOT TO SCALE


B1
000L-08

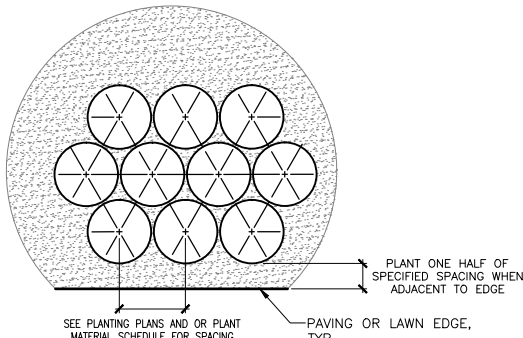

- NOTES:
1. ALL GROUNDCOVER SHALL BE PLANTED @ EQ TRIANGULAR SPACING OR OC SPACING AS SPECIFIED ON THE PLANTING PLAN AND OR PLANT MATERIAL SCHEDULE
 2. LOCATE GROUNDCOVER ONE HALF OF SPECIFIED SPACING DISTANCE FROM ANY CURB, SIDEWALK, OR OTHER HARD SURFACE, UNLESS OTHERWISE SPECIFIED

GROUNDCOVER PLANTING
NOT TO SCALE

B2
000L-08

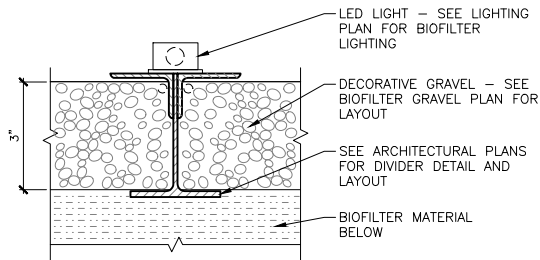

BIOFILTER PLANTING
NOT TO SCALE

B3
000L-08



| | | |
|-------|----------|----------------------------------|
| | | |
| | | |
| | | |
| | | |
| 1 | APR 2014 | RECORD DRAWINGS |
| 0 | NOV 2011 | ISSUE FOR CONSTRUCTION SUBMITTAL |
| ISSUE | DATE | DESCRIPTION |

| | |
|-----------------|-------------------------|
| PROJECT MANAGER | A. MEILLEUR |
| DESIGNED | B. POWERS/ S. HOEBER |
| DRAWN | S. HOEBER |
| CHECKED | G. LAI |
| PROJECT NUMBER | 171097 |

ELECTRONIC SEAL AND
SIGNATURE HAS BEEN
REMOVED. THIS MEDIA
SHOULD NOT BE CONSIDERED
A CERTIFIED DOCUMENT



**LANDSCAPE
DETAILS**

| | |
|----------|-------------|
| FILENAME | 000L-08.dwg |
| SCALE | AS NOTED |

SHEET
000L-08

A1
000L-09

A2
000L-09

A3
000L-0

A4
000L-0

B1
000L-09

B2
000L-0

B3
000L-0

B4
000L-



ELECTRONIC MEDIA DISCLAIMER: THIS ELECTRONIC MEDIA PROVIDED BY HDR ENGINEERING, INC. IS SUBJECT TO AN ELECTRONIC MEDIA RELEASE. ALL USE AND RE-USE OF THIS MEDIA IS SUBJECT TO THE TERMS AND CONDITIONS OF THE RELEASE.

GENERAL

- G1 CODE REQUIREMENTS: ALL DESIGN AND CONSTRUCTION SHALL CONFORM TO THE REQUIREMENTS OF THE IBC 2009 EDITION, ACI 318-08 AND CMACN DESIGN OF MASONRY STRUCTURES. THESE CODES WILL GOVERN EXCEPT WHERE OTHER APPLICABLE CODES OR THE FOLLOWING NOTES ARE MORE RESTRICTIVE.
- G2 DESIGN LOADS: IN ADDITION TO THE DEAD LOADS, THE FOLLOWING WERE USED FOR DESIGN:
- | | |
|--|--------------------------|
| ROOF DL | 20 PSF |
| OPERATING FLOORS (FLOORS ON WHICH MACHINERY MAY BE DISASSEMBLED) | 250 PSF MIN |
| SIDEWALKS | 250 PSF |
| GRATING | |
| TYPE 1 | 150 PSF |
| OTHER AREAS | 100 PSF |
| SNOW LOAD | 45 PSF BASIC GROUND LOAD |
| WIND SPEED | 85 MPH EXP. B, IW=1.15 |
- EARTHQUAKE DESIGN IS BASED UPON THE FOLLOWING:
BUILDING: IBC SITE CLASS D
SEISMIC DESIGN CATEGORY D
OCCUPANCY CATEGORY III
S_s = 50.5%g
S₁ = 17.2%g
S_{as} = 47.0%g
S_{a1} = 24.2%g
I = 1.25
- G3 DIMENSIONS: VERIFY ALL DIMENSIONS AND ALL CONDITIONS AT JOB SITE INCLUDING BUILDING AND SITE CONDITIONS BEFORE COMMENCING WORK. COMMENCEMENT OF WORK INDICATES ACCEPTANCE OF FIELD CONDITIONS. STRUCTURAL DIMENSIONS CONTROLLED BY OR RELATED TO MECHANICAL OR ELECTRICAL EQUIPMENT SHALL BE VERIFIED PRIOR TO CONSTRUCTION. DO NOT SCALE DRAWINGS. USE ONLY WRITTEN DIMENSIONS.
- G4 PROVISIONS FOR EQUIPMENT: VERIFY AND COORDINATE ALL REQUIRED OPENINGS IN FLOORS, WALLS, AND ROOF WITH ALL DISCIPLINES. MECHANICAL AND ELECTRICAL EQUIPMENT SUPPORTS, ANCHORAGES, OPENINGS AND RECESSES NOT SHOWN ON THE STRUCTURAL DRAWINGS BUT REQUIRED BY OTHER CONTRACT DRAWINGS SHALL BE PROVIDED.
- G5 ALTERNATIVE DESIGNS: THE STRUCTURAL SYSTEMS AND DETAILS ON THESE PLANS ARE THE PRIORITY DESIGN. VARIATIONS AND MODIFICATIONS TO WORK SHOWN ON THESE DRAWINGS SHALL NOT BE CARRIED OUT WITHOUT WRITTEN PERMISSION FROM THE PROJECT REPRESENTATIVE.
- G6 FLOOR AND ROOF DRAINS: SEE ARCHITECTURAL AND MECHANICAL DRAWINGS FOR LOCATION AND SIZES OF FLOOR AND ROOF DRAINS, SLOPE DRAINAGE SURFACES UNIFORMLY TO DRAIN. SLOPE SHALL BE AS SHOWN ON DRAWINGS. MINIMUM SLOPE 1/8-INCH PER FOOT FLOOR, 1/4-INCH PER FOOT ROOF.
- G7 SEE SPECIFICATIONS FOR GEOTECHNICAL INFORMATION PERTAINING TO SITE CONDITIONS.
- G8 BACKFILL: NO EARTH SHALL BE BACKFILLED AGAINST THE CONCRETE STRUCTURE UNTIL THE COMPLETED CONCRETE STRUCTURE HAS REACHED ITS DESIGN STRENGTH.
- G9 CONTRACTOR IS REQUIRED TO PROVIDE AND ENFORCE THE USE OF ALL SAFETY DEVICES IN ACCORDANCE WITH CURRENT OSHA & WISHA REGULATIONS.
- G10 SEE CIVIL DRAWINGS FOR BUILDING LOCATION AND ORIENTATION ON THE SITE.
- G11 SPECIAL INSPECTIONS: SPECIAL INSPECTIONS ARE REQUIRED IN ACCORDANCE WITH IBC SECTION 109 AND CHAPTER 17 ON THE FOLLOWING PORTIONS OF WORK:
- STRUCTURAL CONCRETE PLACEMENT
 - REINFORCING STEEL PLACEMENT
 - STRUCTURAL WELDING AND FIELD WELDING
 - ANCHORS, EMBEDS, AND BOLTS IN CONCRETE
 - HIGH STRENGTH BOLTS – TIGHTENING WHERE SPECIFIED AS SLIP CRITICAL
 - SPECIAL GRADING, EXCAVATION, FILL AND SHORING
 - MASONRY CONSTRUCTION (LEVEL 2)
 - HELICAL PIERS

CONCRETE

- C1 CODE: THE IBC 2009, ACI 318-08, ACI 350-06. CONCRETE STRENGTHS SHALL BE VERIFIED BY STANDARD 28-DAY CYLINDER TESTS UNLESS OTHERWISE APPROVED.
- C2 CONCRETE AND GROUT STRENGTH:
- | | |
|-----------------------------|----------|
| USE: | STRENGTH |
| NORMAL WEIGHT CONCRETE | 4000 PSI |
| NON-SHRINK GROUT | 5000 PSI |
| NORMAL WEIGHT LEAN CONCRETE | 3000 PSI |
- C3 MINIMUM REINFORCEMENT: WALL REINFORCING: (UNLESS NOTED OTHERWISE)
- | THICKNESS | HORIZONTAL | VERTICAL |
|-----------------|-------------|-------------|
| 8" WALL & UNDER | #4 @ 12" | #4 @ 12" |
| 10" WALL | #5 @ 12" EF | #5 @ 12" EF |
| 12" WALL | #5 @ 12" EF | #5 @ 12" EF |
- C4 REINFORCING STEEL: ALL REINFORCING STEEL SHALL BE IN ACCORDANCE WITH ASTM A-615, GRADE 60, FOR DEFORMED BARS AND ASTM A-185 (FY – 65,000 PSI) FOR SMOOTH WELDED WIRE FABRIC (WWF), UNLESS OTHERWISE NOTED.
- C5 REINFORCING STEEL SHALL HAVE PROTECTION AS FOLLOWS:
- | USE | COVER |
|---|---|
| SLAB BARS | 1-1/2" |
| WALL BARS: INTERIOR FACES | 1-1/2" |
| EXPOSED TO WEATHER OR EARTH | 1-1/2" (#5 OR SMALLER) 2" (#6 OR LARGER) |
| FOOTING AND SLAB BARS CAST ON GROUND | 3" |
| CONCRETE IN CONTACT WITH LIQUID | 2" |
| WHEN WATER STOP ADJACENT TO OUTSIDE FACE OF REINFORCING | 3" |
- C6 EXTRA ACCESSORY BARS: IN ADDITION TO NORMAL ACCESSORIES USED TO HOLD REINFORCING STEEL FIRMLY IN POSITION, EXTRA ACCESSORY BARS SHALL BE USED AS FOLLOWS:
IN SLABS #5 RAISER BARS AT 36" OC MAX
IN WALLS PROVIDE #3 U OR Z SHAPE SPACERS AT 6'-0" OC EW.
- C7 BAR LAP SPLICES: DOWELS SHALL BE SAME SPACING AS BARS WITH WHICH THEY ARE LAPPED. THE DOWEL EMBODIMENT SHALL PROVIDED FULL TENSION EMBEDMENT. VERTICAL REINFORCING BAR SPLICES IN COLUMNS SHALL HAVE AT LEAST 30 BAR DIAMETER LAP, UNO OR SHOWN ON DWG. ALL OTHER BAR SPLICES SHALL BE LAPPED IN ACCORDANCE TO THE REINFORCING DEVELOPMENT TABLES ON SHEET S2.
- C8 USE SPlice LENGTH CLASS B UNLESS NOTED OTHERWISE. THE SPLICES SHALL BE STAGGERED AT LEAST THE LENGTH OF THE LAP SPLICES FROM FACE TO FACE. TOP BARS ARE HORIZONTAL BARS WITH MORE THAN 12" DEPTH OF FRESH CONCRETE CAST BELOW THE REINFORCEMENT.
- C9 RESTRICTED BAR ANCHORAGE: IN CASES WHERE REINFORCING BARS CANNOT BE EXTENDED AS FAR AS REQUIRED DUE TO THE UNITED EXTENT OF THE ADJACENT CONCRETE STRUCTURE, THE BARS SHALL EXTEND AS FAR AS POSSIBLE AND END IN STANDARD HOOKS.
- C10 CHAMFERS: EXCEPT AS OTHERWISE REQUIRED, EXPOSED CONCRETE CORNERS AND EDGES SHALL HAVE 3/4" CHAMFERS. RE-ENTRANT CORNERS SHALL NOT HAVE FILLETS UNLESS OTHERWISE SHOWN.
- C11 ANCHOR BOLTS: INSTALLATION AND CAPACITY OF ANCHOR BOLTS SHALL BE IN ACCORDANCE WITH IBC TABLE 1912.2. ALL BOLTS SHALL BE 316 STAINLESS STEEL UNLESS OTHERWISE NOTED. ADDITIONAL EMBEDMENT LENGTH REQUIRED FOR EQUIPMENT ANCHOR BOLTS SHALL BE DETERMINED BY THE EQUIPMENT SUPPLIER.
- C12 ALL RE-ENTRANT CORNERS SHALL BE REINFORCED WITH 4#4@6 INSTALLED AT A 45° ANGLE TO THE CORNER WITH 48" LONG CENTERED ANCHOR.

STEEL

- S1 STEEL SPECIFICATIONS: DESIGN, FABRICATION AND ERECTION SHALL BE IN ACCORDANCE WITH THE FOLLOWING SPECIFICATIONS:
- STRUCTURAL STEEL – AISC MANUAL OF STEEL CONSTRUCTION ALLOWABLE STRESS DESIGN NINTH EDITION.
- STRUCTURAL STEEL – AISC MANUAL OF STEEL CONSTRUCTION LOAD RESISTANCE FACTOR DESIGN SECOND EDITION.
- WELDING – AWS D1.1
AWS PRE QUALIFIED JOINT DETAILS USE 16" MIN. WELDS (UNLESS OTHERWISE NOTED)
- WELDER CERTIFICATION – WASHINGTON ASSOCIATION OF BUILDING OFFICIALS (W.A.B.O)
- S2 FABRICATION AND ERECTION: BE RESPONSIBLE FOR ALL ERECTION AIDS AND JOINT PREPARATION THAT INCLUDE BUT ARE NOT LIMITED TO: ERECTION ANGLES; LIFT HOLES; WELDING PROCEDURES; GROOVE ANGLES; BACKING BARS, COPES; SURFACE ROUGHNESS VALUES; AND TAPERS OF UNEQUAL PARTS.
- S3 STEEL MATERIALS:
STRUCTURAL STEEL.....ASTM A 992 GRADE 50
CONNECTION MATERIAL, EMBEDDED ITEMS, CHANNELS, ANGLES, BASE PLATES, AND MISC. STEELASTM A 36
STEEL TUBE.....ASTM A 500 GRADE B
STEEL PIPE.....ASTM A 500 GRADE B
STRUCTURAL BOLTS.....ASTM A 325 N
ANCHOR BOLTS.....ASTM A 193
THREADED RODS.....ASTM A 36
WELDING ELECTRODES.....E70XX
SHEET STEEL.....ASTM A611
GALVANIZED SHEET STEEL.....ASTM 653
- S4 ENCASED STEEL: STEEL COMPLETELY ENCASED IN CONCRETE SHALL NOT BE GALVANIZED OR PAINTED AND SHALL HAVE A CLEAN SURFACE FOR BONDING TO CONCRETE.
- S5 ALL PAINT AND COATINGS SHALL BE IN ACCORDANCE WITH SPEC SECTION 09900.

FIBERGLASS

- F1 ALL GRATING SHALL BE FIBERGLASS-(FRP) EXCEPT WHERE OTHERWISE NOTED.
- F2 ALL FRP GRATING SHALL BE 2" DEPTH W/ 2X2 MESH EXCEPT WHERE OTHERWISE NOTED
- F3 GRATING SUPPORTS IN THE SCREENING AREA SHALL BE FIBERGLASS.
- F4 ALL FRP MEMBERS & GRATING SHALL HAVE A UV PROTECTIVE COATING


STAINLESS STEEL

- ST1 MATERIALS: STAINLESS BARS AND SHAPES – ASTM A 484, FY = 30 KSI
STAINLESS STEEL PLATE SHEET AND STRIP – ASTM A 666 TYPE 316, FY = 30 KSI
- ST2 FASTENERS: STAINLESS STEEL BOLTS – ASTM A193, TYPE 316
STAINLESS STEEL NUTS – ASTM A194, TYPE 316
- ST3 WELDING MATERIALS AND PROCEDURES FOR WELDING STAINLESS STEEL SHALL BE IN ACCORDANCE WITH AWS D1.6.
- MASONRY
- M1 APPLICABLE CODE
MASONRY INSTALLATION AND REINFORCING SHALL CONFORM TO ALL THE REQUIREMENTS OF ACI530-02/ASCE 5-02/TMS 402-02 AND ACI 530.1-02/ASCE 6-02/TMS 602/02.
- M2 MINIMUM COMPRESSIVE STRENGTH OF MASONRY
f'm.....1,500 PSI MIN
- M3 MINIMUM REINFORCEMENT (UNLESS NOTED OTHERWISE)
VERTICAL #5@24"
HORIZONTAL #5@24"
EXTRA REINFORCING IS REQUIRED AT OPENINGS, SEE TYP DETAILS.
- M4 REINFORCING STEEL
ALL REINFORCING STEEL SHALL BE IN ACCORDANCE WITH ASTM A615 GRADE 60, DEFORMED BARS.
- M5 MINIMUM COVER
ALL REINFORCING STEEL SHALL HAVE MINIMUM OF 2" COVER INCLUDING THE MASONRY UNIT.
- M6 LAP SPLICES
LAP SPLICES SHALL BE 48 BAR DIAMETERS OR 24" MINIMUM WHICHEVER IS GREATER.
- M7 RESTRICTED BAR ANCHORAGE
IN CASES WHERE REINFORCING BARS CANNOT BE EXTENDED AS FAR AS REQUIRED, THE BARS SHALL EXTEND AS FAR AS POSSIBLE AND END IN STANDARD HOOK.
- M8 ANCHOR BOLTS
INSTALLATION AND CAPACITY OF ANCHOR BOLTS SHALL BE IN ACCORDANCE WITH IBC 2009 TABLE 1912.2
ADHESIVE ANCHORS SHALL BE IN ACCORDANCE WITH THE SPECIFICATIONS AND STANDARD DETAILS.
- M9 SOLID GROUT
SOLID GROUT ALL CELLS UNO.

DEFERRED SUBMITTALS

- METAL STAIRS, HANDRAIL AND LADDERS.
- ALUMINUM HANDRAIL.
- GRATING AND GRATING SUPPORT STRUCTURES.
- ACCESS HATCHES.

SYMBOLS

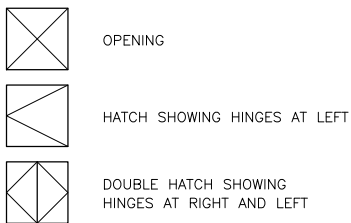

TYPICAL DETAILS: THE DETAILS SHOWN ARE TYPICAL AND SHALL BE USED FOR LIKE OR SIMILAR CONDITIONS NOT SHOWN.



HDR Engineering, Inc.

| | | |
|-------|----------|----------------------------------|
| | | |
| | | |
| 1 | APR 2014 | RECORD DRAWINGS |
| 0 | NOV 2011 | ISSUE FOR CONSTRUCTION SUBMITTAL |
| ISSUE | DATE | DESCRIPTION |


| | |
|-----------------|-------------|
| PROJECT MANAGER | A. MEILLEUR |
| DESIGNED | K. KORNHER |
| DRAWN | J. CONNER |
| CHECKED | M. HIJAZI |
| PROJECT NUMBER | 171097 |

ELECTRONIC SEAL AND SIGNATURE HAS BEEN REMOVED. THIS MEDIA SHOULD NOT BE CONSIDERED A CERTIFIED DOCUMENT



WASTE WATER TREATMENT PLANT IMPROVEMENTS












GENERAL STRUCTURAL GENERAL NOTES

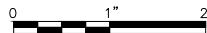

| | |
|----------|--------------|
| FILENAME | 000S-01.dwg |
| SCALE | NOT TO SCALE |

| |
|---------|
| SHEET |
| 000S-01 |

ELECTRONIC MEDIA DISCLAIMER: THIS ELECTRONIC MEDIA PROVIDED BY HDR ENGINEERING, INC. IS SUBJECT TO AN ELECTRONIC MEDIA RELEASE. ALL USE AND RE-USE OF THIS MEDIA IS SUBJECT TO THE TERMS AND CONDITIONS OF THE RELEASE.

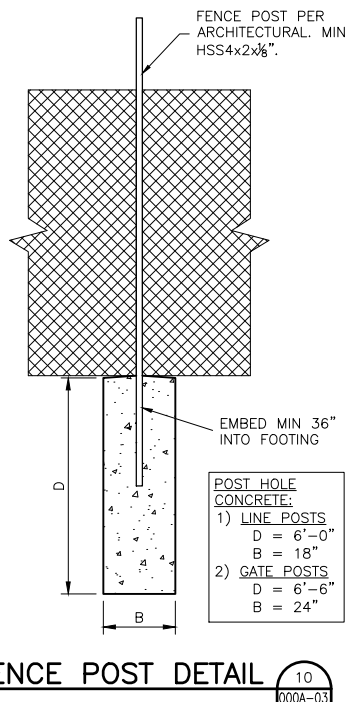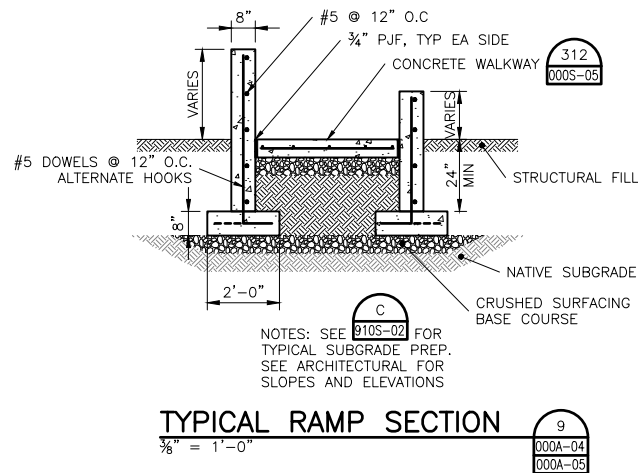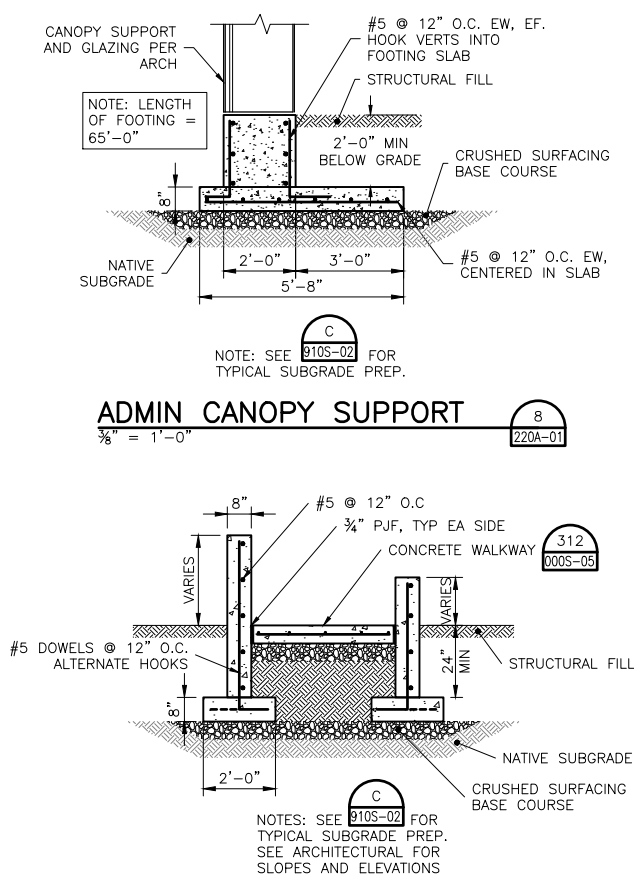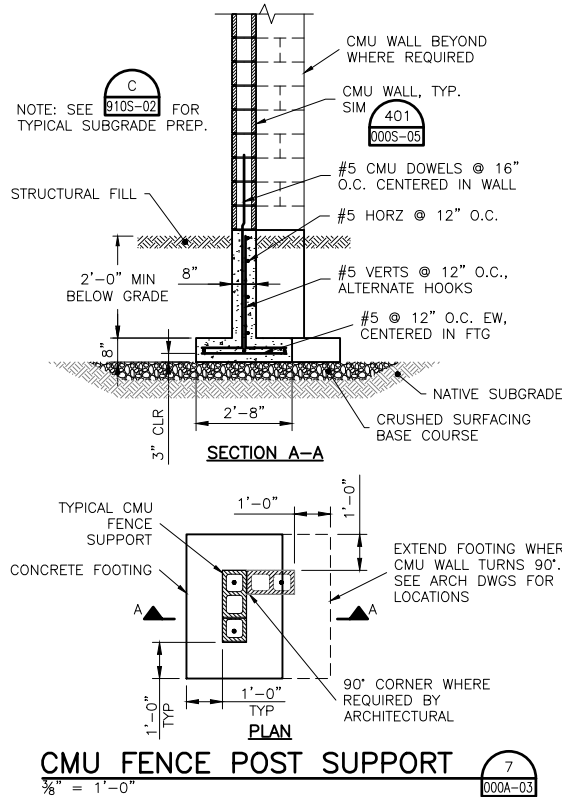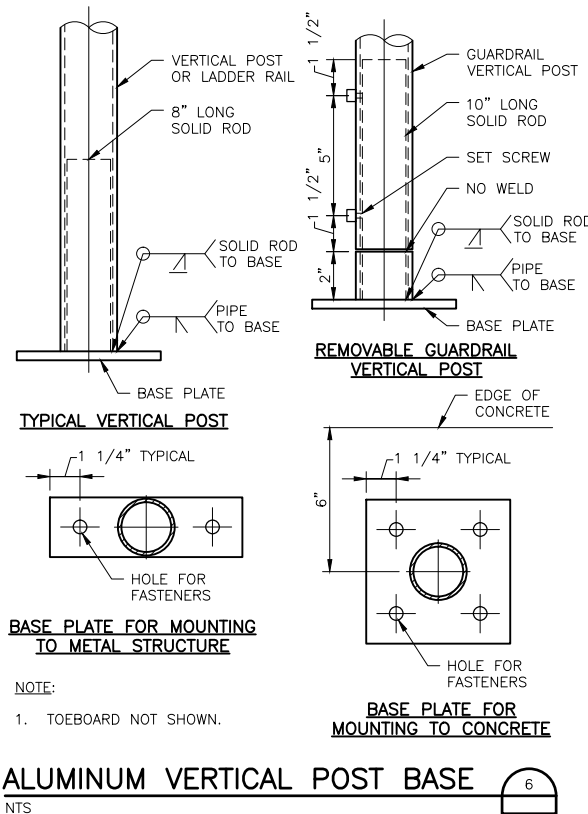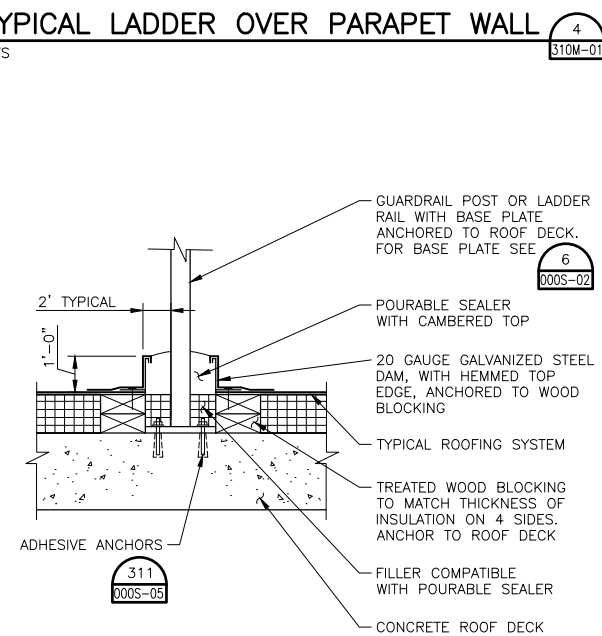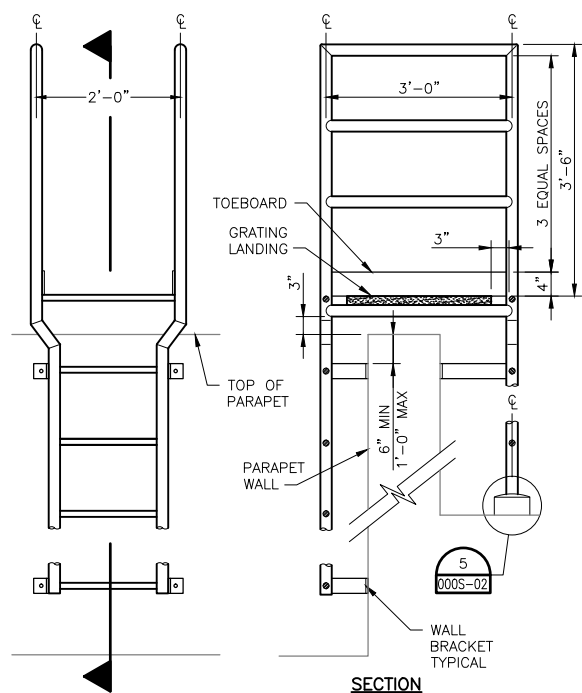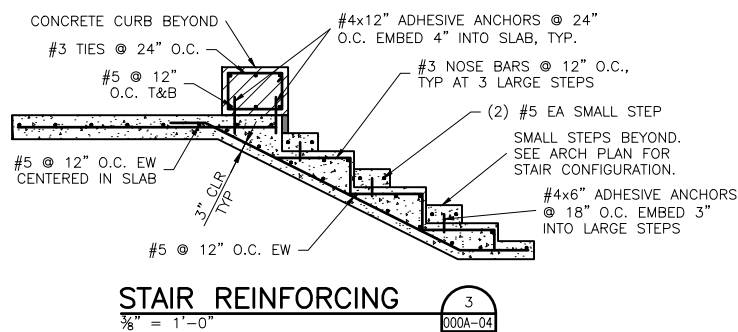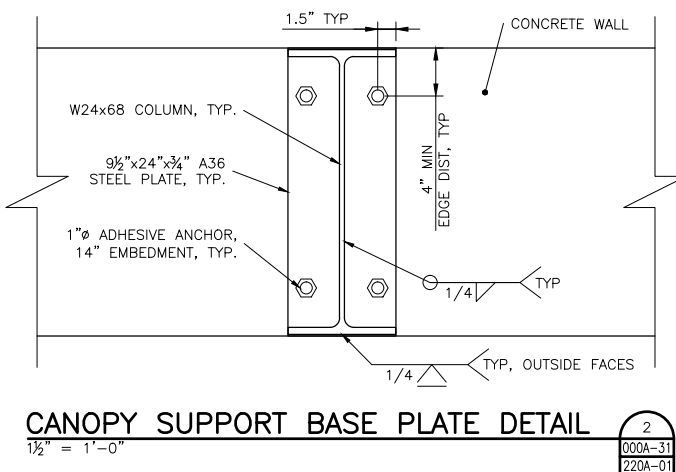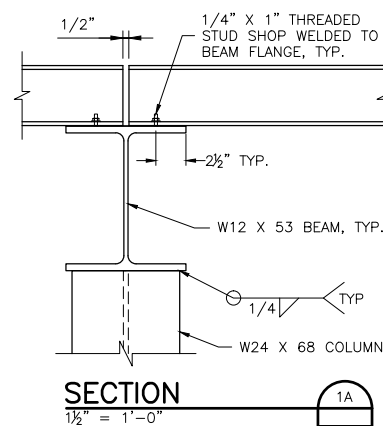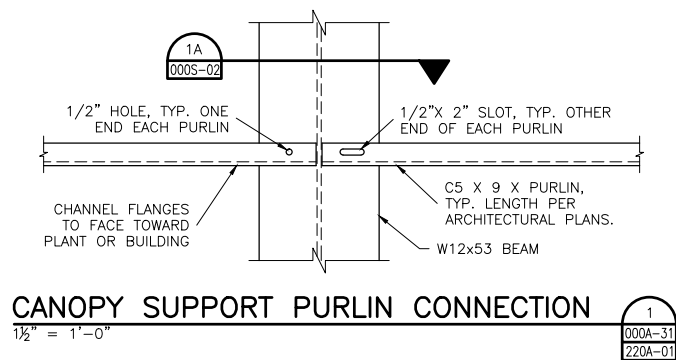

HDR Engineering, Inc.

| ISSUE | DATE | DESCRIPTION |
|-------|----------|----------------------------------|
| 1 | APR 2014 | RECORD DRAWINGS |
| 0 | NOV 2011 | ISSUE FOR CONSTRUCTION SUBMITTAL |

| | |
|-----------------|-------------|
| PROJECT MANAGER | A. MEILLEUR |
| DESIGNED | K. KORNIHER |
| DRAWN | J. CONNER |
| CHECKED | M. HIJAZI |
| PROJECT NUMBER | 171097 |

ELECTRONIC SEAL AND
SIGNATURE HAS BEEN
REMOVED. THIS MEDIA
SHOULD NOT BE CONSIDERED
A CERTIFIED DOCUMENT

**City of
Wenatchee**
WASTE WATER TREATMENT
PLANT IMPROVEMENTS


GENERAL
STRUCTURAL
SITE DETAILS I



FILENAME: 000S-02.dwg
SCALE: AS NOTED

SHEET
000S-02

ELECTRONIC MEDIA DISCLAIMER: THIS ELECTRONIC MEDIA PROVIDED BY HDR ENGINEERING, INC. IS SUBJECT TO AN ELECTRONIC MEDIA RELEASE. ALL USE AND RE-USE OF THIS MEDIA IS SUBJECT TO THE TERMS AND CONDITIONS OF THE RELEASE.

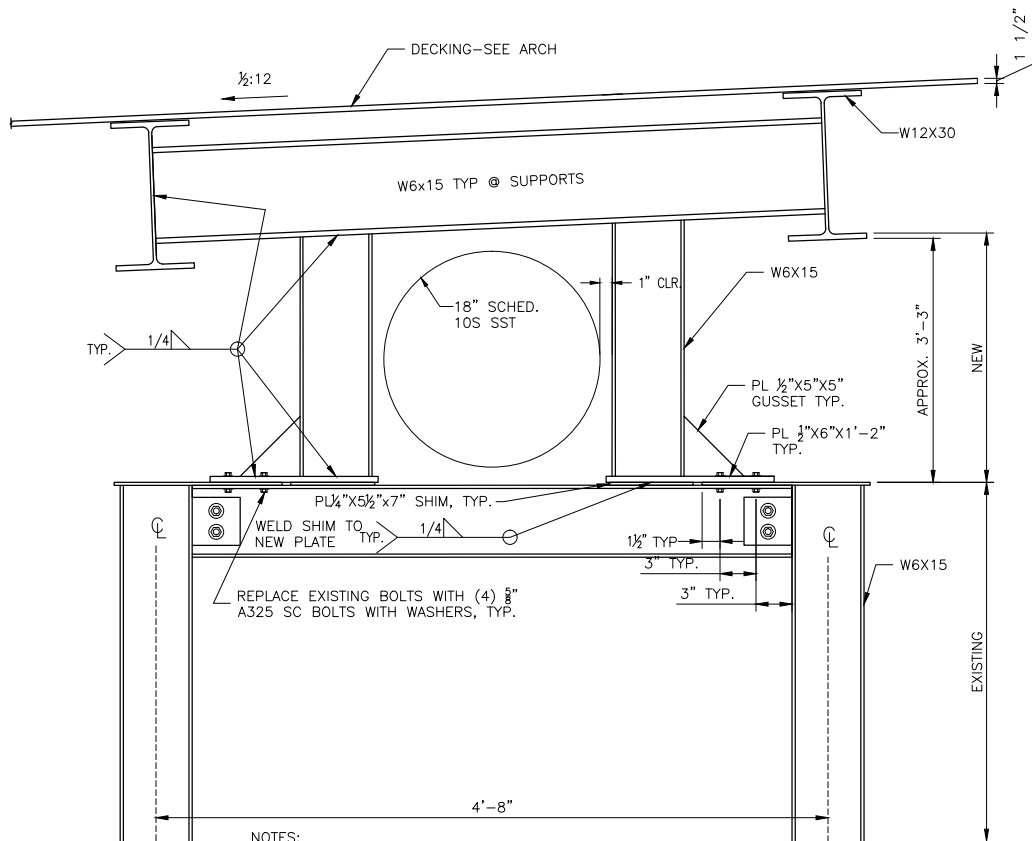


- NOTES:
1. FIELD VERIFY DIMENSIONS OF EXISTING COMPONENTS AND CLEARANCE AROUND PIPING PRIOR TO FABRICATION - FIELD CUTTING WILL NOT BE ALLOWED.
 2. HOT-DIP GALVANIZE AFTER FABRICATION.
 3. IF FIELD CUTTING OR DRILLING IS REQUIRED, REGALVANIZE PIECE.
 4. NEW COMPONENTS ARE WELDED TOGETHER. THEIR CONNECTION TO EXISTING IS BOLTED.

AERATION BASIN ROOF SUPPORT

1/2" = 1'-0"

11
610A-21

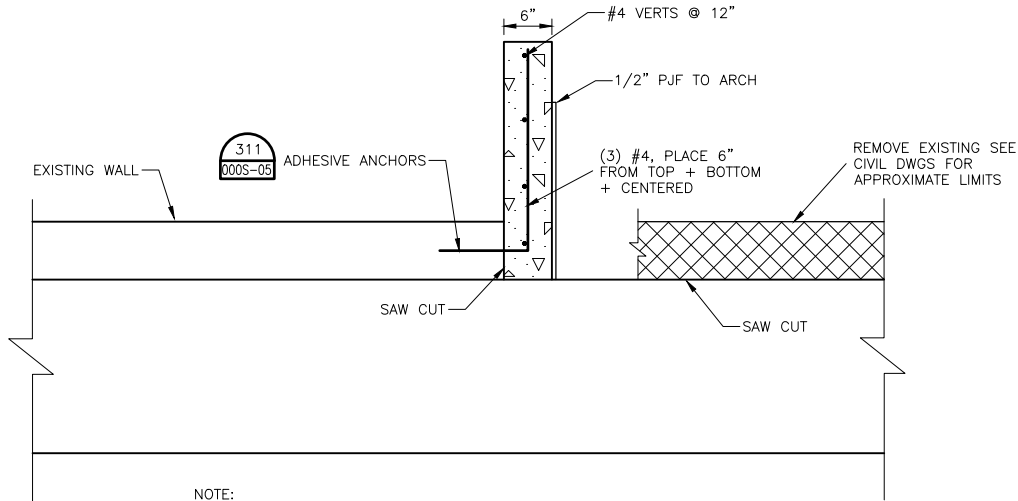

WALL RETURN

NOT TO SCALE

12
000A-04
000A-05



HDR Engineering, Inc.


| ISSUE | DATE | DESCRIPTION |
|-------|----------|----------------------------------|
| 1 | APR 2014 | RECORD DRAWINGS |
| 0 | NOV 2011 | ISSUE FOR CONSTRUCTION SUBMITTAL |

| | |
|-----------------|-------------|
| PROJECT MANAGER | A. MEILLEUR |
| DESIGNED | K. KORNER |
| DRAWN | J. CONNER |
| CHECKED | M. HIJAZI |
| PROJECT NUMBER | 171097 |

ELECTRONIC SEAL AND
SIGNATURE HAS BEEN
REMOVED. THIS MEDIA
SHOULD NOT BE CONSIDERED
A CERTIFIED DOCUMENT



GENERAL
STRUCTURAL
SITE DETAILS II

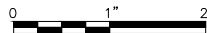

| | |
|----------|-------------|
| FILENAME | 000S-03.dwg |
| SCALE | AS NOTED |

SHEET
000S-03

| fc >= 4000 psi fy = 60,000 psi | | | | |
|--------------------------------|-----------------------|-----------------|----------------------------|----------------------|
| BAR | MIN SPLICE LAP LENGTH | | MIN EMBEDMENT LENGTH (MEL) | |
| | TOP BARS (INCHES) | OTHER* (INCHES) | TENSION (INCHES) | COMPRESSION (INCHES) |
| #3 | 24 | 18 | 14 | 7 |
| #4 | 32 | 25 | 19 | 9 |
| #5 | 40 | 31 | 24 | 12 |
| #6 | 48 | 37 | 28 | 14 |
| #7 | 70 | 54 | 42 | 17 |
| #8 | 80 | 62 | 47 | 19 |
| #9 | 90 | 70 | 54 | 21 |
| #10 | 102 | 78 | 60 | 24 |
| #11 | 113 | 87 | 67 | 27 |

NOTES:

1. THESE TABLES PERTAIN TO THE ACI 318
2. LAP LENGTHS SHOWN ARE FOR CLASS "B" TENSION SPLICES.
3. LAP LENGTHS AND EMBEDMENTS SHOWN ARE FOR BARS SPACED LATERALLY @ > FIVE TIMES THE BAR DIAMETER AND FOR MINIMUM COVER IN ACCORDANCE WITH ACI 318.
4. IF SPACING IS < 5 TIMES BAR DIAMETER, INCREASE LAP LENGTH AND EMBEDMENT SHOWN BY 25%.
5. TOP REINFORCING IS HORIZONTAL STEEL SO PLACED THAT MORE THAN 12" OF CONCRETE IS CAST IN THE MEMBER BELOW THE REINFORCING.

REINFORCING LAP & EMBEDMENT TABLES





| BAR SIZE GRADE 60 | HL | HW | TL | D | f'c=4.0 OR 4.5 KSI |
|----------------------|--------|-----------|---------|---------|--------------------|
| | | | | | Ldh * |
| #3 | 6" | 3" | 3" | 2 1/4" | 6" |
| #4 | 8" | 4" | 4 1/2" | 3" | 7" |
| #5 | 10" | 5" | 5" | 3 3/4" | 9" |
| #6 | 1'-0" | 6" | 6" | 4 1/2" | 10" |
| #7 | 1'-2" | 7" | 7" | 5 1/4" | 12" |
| #8 | 1'-4" | 8" | 8" | 6" | 14" |
| #9 | 1'-7" | 11 3/4" | 10 1/2" | 9 1/2" | 15" |
| #10 | 1'-10" | 1'-1 1/4" | 11 1/2" | 10 3/4" | 17" |
| #11 | 2'-0" | 1'-2 3/4" | 1'-1" | 12" | 19" |


* COMPLYING WITH MINIMUM COVER REQUIREMENTS OF ACI 318, 12.5.3. OTHERWISE Ldh MUST BE RE-CALCULATED.

REINFORCING HOOK SCHEDULE

1" = 1'-0"

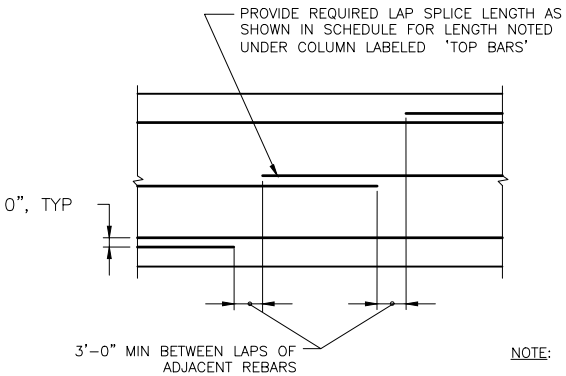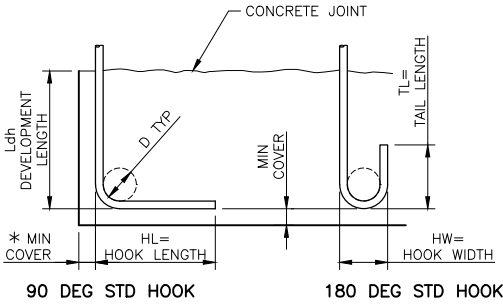

SLABS & WALLS

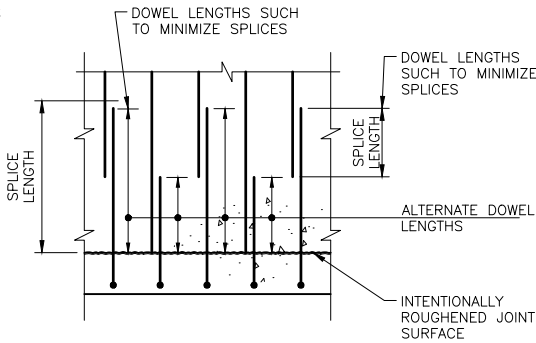


NOTE:

WALL & SLAB DOWELS

1. APPLIES TO SLABS, WALLS (BOTH HORIZONTAL AND VERTICAL)
2. LAP SPLICES SHALL NOT COINCIDE IN POSITION ANYMORE FREQUENTLY THAN EVERY THIRD BAR, CENTER AND EVERY OTHER BAR AT WALL & SLAB EDGES.
3. SPLICE LOCATION IS TO BE STAGGERED FROM FACE TO FACE OF WALL & SLAB

REINFORCING SPLICE STAGGER

NTS

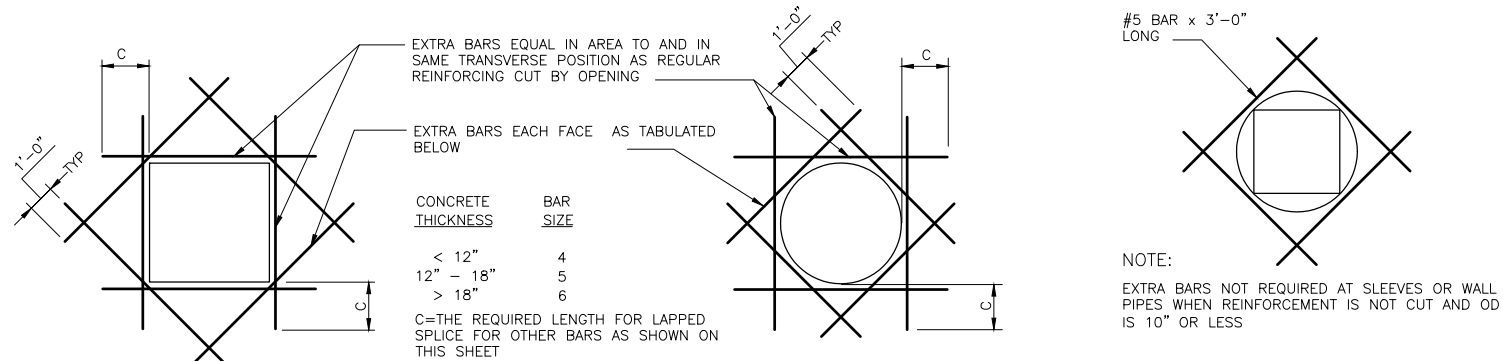


FOR RECTANGULAR OPENINGS LARGER THAN 21" DIAGONAL
NTS

FOR CIRCULAR OPENINGS LARGER THAN 21" DIAGONAL
NTS

21" AND SMALLER DIAMETER OPENINGS
NTS


CONCRETE OPENING REINFORCING DETAILS

NTS

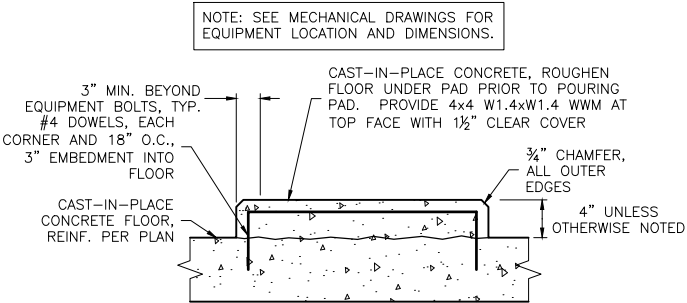

TYPICAL CONCRETE EQUIPMENT PAD

NTS

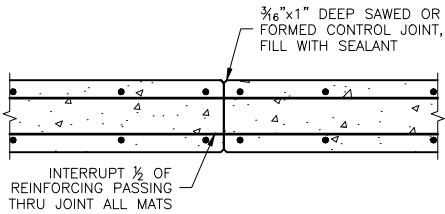


NOTES:

1. JOINT MAY BE FORMED WITH 1/2" CHAMFER STRIPS BACK-TO-BACK AT WALLS, CONTRACTOR'S OPTION.
2. DETAIL TO BE USED AT BOTH WALLS AND SLABS

CONTROL JOINT (CLJ)

3/4"=1'-0"

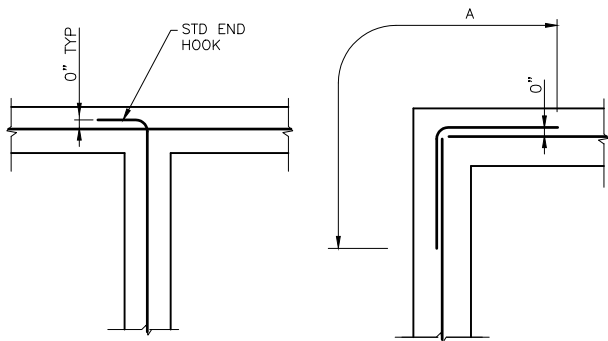

A = SUFFICIENT LENGTH TO PERMIT BARS TO EXTEND THROUGH THE WALL TO THE OPPOSITE FACE AND TERMINATE WITH A LAP SPLICE.

TYPICAL CONCRETE CORNER REINFORCING

NTS



HDR Engineering, Inc.

| ISSUE | DATE | DESCRIPTION |
|-------|----------|----------------------------------|
| 1 | APR 2014 | RECORD DRAWINGS |
| 0 | NOV 2011 | ISSUE FOR CONSTRUCTION SUBMITTAL |


| | |
|-----------------|-------------|
| PROJECT MANAGER | A. MEILLEUR |
| DESIGNED | K. KORNER |
| DRAWN | J. CONNER |
| CHECKED | M. HIJAZI |
| PROJECT NUMBER | 171097 |

ELECTRONIC SEAL AND
SIGNATURE HAS BEEN
REMOVED. THIS MEDIA
SHOULD NOT BE CONSIDERED
A CERTIFIED DOCUMENT



WASTE WATER TREATMENT
PLANT IMPROVEMENTS

GENERAL
STRUCTURAL
STANDARD DETAILS I

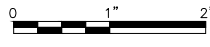

FILENAME 000S-04.dwg
SCALE AS NOTED

SHEET
000S-04

| CMU ADHESIVE ANCHOR SCHEDULE | | | | |
|---|-------------------|--------------------|---------------|-------------|
| GROUTED CMU CELLS | | | | |
| ANCHOR Ø | EMBED LENGTH (IN) | EDGE DISTANCE (IN) | TENSION (LBS) | SHEAR (LBS) |
| 3/8" | 3 1/2" | 4 | 880 | 1135 |
| 1/2" | 4 1/2" | 4 | 1055 | 1745 |
| 5/8" | 5 5/8" | 4 | 1370 | 2120 |
| 3/4" | 6 3/4" | 4 | 1580 | 2205 |
| UNGROUTED CMU CELLS (LIMIT 1 ANCHOR PER CELL) | | | | |
| 1/4" | N/A | | 255 | 340 |
| 5/16" | N/A | | 370 | 505 |
| 3/8" | N/A | | 525 | 790 |
| 1/2" | N/A | | 525 | 1230 |


NOTES:
1. ALLOWABLE LOADS GIVEN FOR ANCHORS IN GROUTED CMU CELLS ARE BASED ON HILTI HIT-HY 150 MAX ANCHORING SYSTEM
2. ALLOWABLE LOADS GIVEN FOR ANCHORS IN UNGROUTED CMU CELLS ARE BASED ON HILTI HIT-HY 20 HYBRID ADHESIVE ANCHORING SYSTEM

| CONCRETE ADHESIVE ANCHOR SCHEDULE | | | | | | |
|-----------------------------------|--------------|--------------------|-------------------|--------------------|-------------------------|-----------------------|
| REINFORCING BARS | | | | | | |
| BAR SIZE | EMBED LENGTH | MIN CONC THICKNESS | MIN EDGE DISTANCE | MIN ANCHOR SPACING | ALLOWABLE TENSION (LBS) | ALLOWABLE SHEAR (LBS) |
| #5 | 6" | 7 1/2" | 7 1/2" | 10" | 5,535 | 7,195 |
| #6 | 7" | 10 1/2" | 10 1/2" | 14" | 8,783 | 11,418 |
| #7 | 8" | 11 1/4" | 11 1/4" | 15" | 9,968 | 12,959 |
| #8 | 9" | 12" | 12" | 16" | 11,201 | 14,562 |
| ANCHOR BOLTS/THREADED RODS | | | | | | |
| 3/8" | 5" | 5 1/4" | 5 1/4" | 7" | 3,105 | 2,519 |
| 1/2" | 6" | 6 1/2" | 6 1/2" | 8 1/2" | 4,371 | 5,440 |
| 5/8" | 7" | 7 1/2" | 7 1/2" | 10" | 5,535 | 7,195 |
| 3/4" | 8" | 10 | 10 | 13 1/4" | 8,274 | 10,757 |

NOTES:
1. ALLOWABLE LOADS GIVEN ARE BASED ON HILTI HIT-RE 500-SD EPOXY ANCHORS.
2. SEE SPECIFICATIONS (5500) FOR ALLOWABLE ANCHORS.
3. EMBEDMENT LENGTHS SHOWN ARE MINIMUM. PROVIDE MANUFACTURER'S RECOMMENDATIONS FOR INSTALLATION.

ADHESIVE ANCHOR

NTS

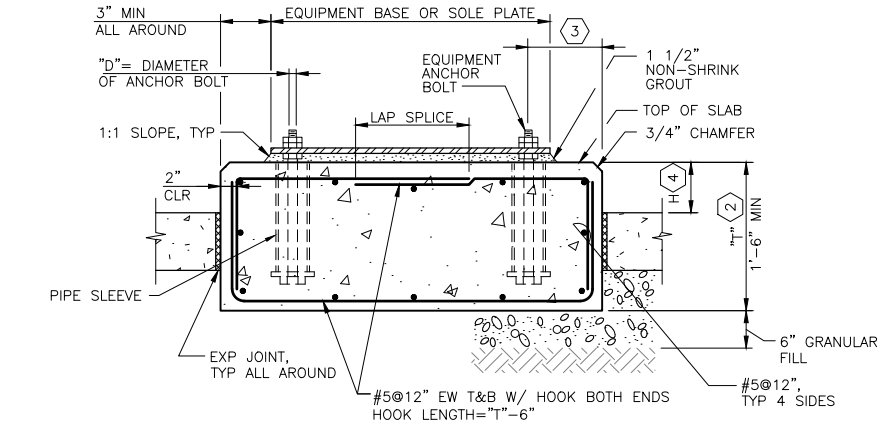


NOTES:

- EQUIPMENT PAD DIMENSIONS SHALL BE AS DETERMINED BY EQUIPMENT MANUFACTURER'S APPROVED SHOP DRAWINGS.
- PAD THICKNESS "T" AS REQUIRED BY EQUIPMENT MANUFACTURER. PAD DIMENSIONS, ANCHOR BOLT SIZE AND LOCATION AND EQUIPMENT BASE OR SOLE PLATE SHALL CONFORM TO EQUIPMENT MANUFACTURER'S REQUIREMENTS.
- THE EDGE DISTANCE ON THE ANCHOR BOLTS SHALL NOT BE LESS THAN 6" OR 8 x "D".
- HEIGHT VARIES TO SUIT EQUIPMENT FURNISHED OR AS INDICATED ON THE DRAWINGS, 6" MINIMUM.
- PIPE SLEEVES SHALL BE USED TO PROVIDE THE ANCHOR BOLT A MINIMUM MOVEMENT OF 1/2" IN ALL DIRECTIONS. MIN SLEEVE LENGTH SHALL BE 8x THE BOLT DIAMETER. SLEEVES SHALL BE FILLED WITH NON-SHRINK GROUT. SLEEVES SHALL HAVE A MINIMUM INTERNAL DIAMETER OF 1" GREATER THAN BOLT DIAMETER AND MAX INTERNAL DIAMETER OF 3" GREATER THAN BOLT DIAMETER.

ISOLATED CONCRETE EQUIPMENT PAD DETAIL

NTS

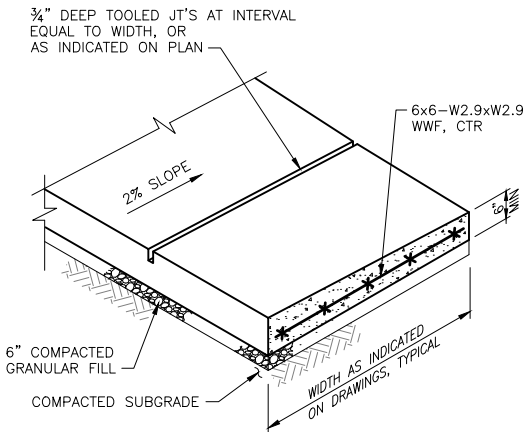

NOTES:


- PROVIDE FULL DEPTH 3/8" PREMOLDED EXPANSION JOINT FILLER ALL AROUND AT ALL UTILITY POLES, METER BOXES, ETC.
- PLACE FULL DEPTH THRU JOINTS W/1/2"x6" PREMOLDED EJF AT POINT OF TANGENCY AND AT MIN 30' INTERVALS.

CONCRETE WALKWAY

NTS

EXTERIOR CMU WALL

NTS

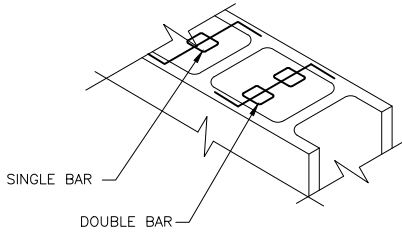


NOTE:

- PROVIDE GALVANIZED 9 GAGE POSITIONER AT ALL VERTICAL REINFORCING BARS. LOCATE POSITIONERS AT SECOND COURSE FROM TOP AND BOTTOM OF WALL, AND AT A MAXIMUM VERTICAL SPACING OF 8'-0".
- TIE HORIZONTAL BARS TO VERTICAL BARS WITH IN 1 VERTICAL BAR SPACING FROM THE CORNERS AND AT A MAXIMUM HORIZONTAL SPACING OF 8'-0"

VERTICAL & HORIZONTAL BAR POSITIONER DETAIL

NTS

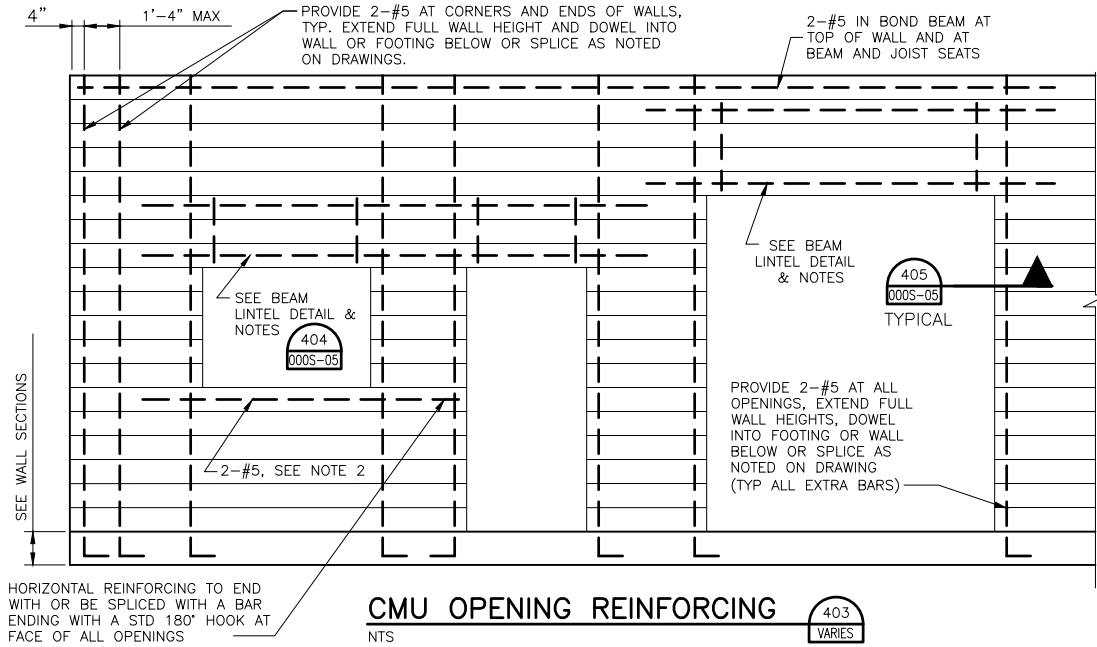

CMU OPENING REINFORCING


NTS

NOTE:

- FOR OPENINGS, LARGER THAN 36" SEE LARGE BEAM LINTEL.
- LOW-WEB BOND BEAM ARE NOT ACCEPTABLE OVER OPENINGS OR WITHIN THE EXTENDED BAR ZONE ADJACENT TO OPENINGS.

BEAM LINTEL DETAIL

NTS

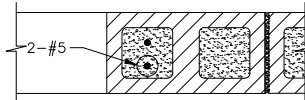

CMU JAMB

NTS

DOUBLE BAR BOND BEAM

A = SUFFICIENT LENGTH TO PERMIT BARS TO EXTEND THROUGH THE WALL TO THE OPPOSITE FACE AND TERMINATE WITH A LAP SPLICE, AS SHOWN ON THIS SHEET.

B = PROVIDE TWICE THE LAP LENGTH NOTED BELOW

C = SUFFICIENT LENGTH TO PERMIT BARS TO EXTEND THROUGH THE WALL TO THE OPPOSITE FACE AND TERMINATE IN A STANDARD HOOK, AS SHOWN ON THIS SHEET.

* NOT LESS THAN STANDARD END HOOK

XX EXTRA BARS SAME SIZE AND AT SAME SPACING AS HORIZONTAL STEEL. ADD EXTRA BARS ONLY WHEN CALL FOR ON DRAWINGS.

CMU CORNER REINFORCING DETAIL

NTS



HDR Engineering, Inc.


| ISSUE | DATE | DESCRIPTION |
|-------|----------|----------------------------------|
| 1 | APR 2014 | RECORD DRAWINGS |
| 0 | NOV 2011 | ISSUE FOR CONSTRUCTION SUBMITTAL |

| | |
|-----------------|-------------|
| PROJECT MANAGER | A. MEILLEUR |
| DESIGNED | K. KORNIHER |
| DRAWN | J. CONNER |
| CHECKED | M. HIJAZI |
| PROJECT NUMBER | 171097 |

ELECTRONIC SEAL AND SIGNATURE HAS BEEN REMOVED. THIS MEDIA SHOULD NOT BE CONSIDERED A CERTIFIED DOCUMENT



GENERAL STRUCTURAL STANDARD DETAILS II

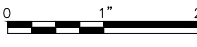


| | |
|----------|-------------|
| FILENAME | 000S-05.dwg |
| SCALE | AS NOTED |

| | |
|-------|---------|
| SHEET | 000S-05 |
|-------|---------|


ELECTRONIC MEDIA DISCLAIMER: THIS ELECTRONIC MEDIA PROVIDED BY HDR ENGINEERING, INC. IS SUBJECT TO AN ELECTRONIC MEDIA RELEASE. ALL USE AND RE-USE OF THIS MEDIA IS SUBJECT TO THE TERMS AND CONDITIONS OF THE RELEASE.

1 2 3 4 5 6 7 8

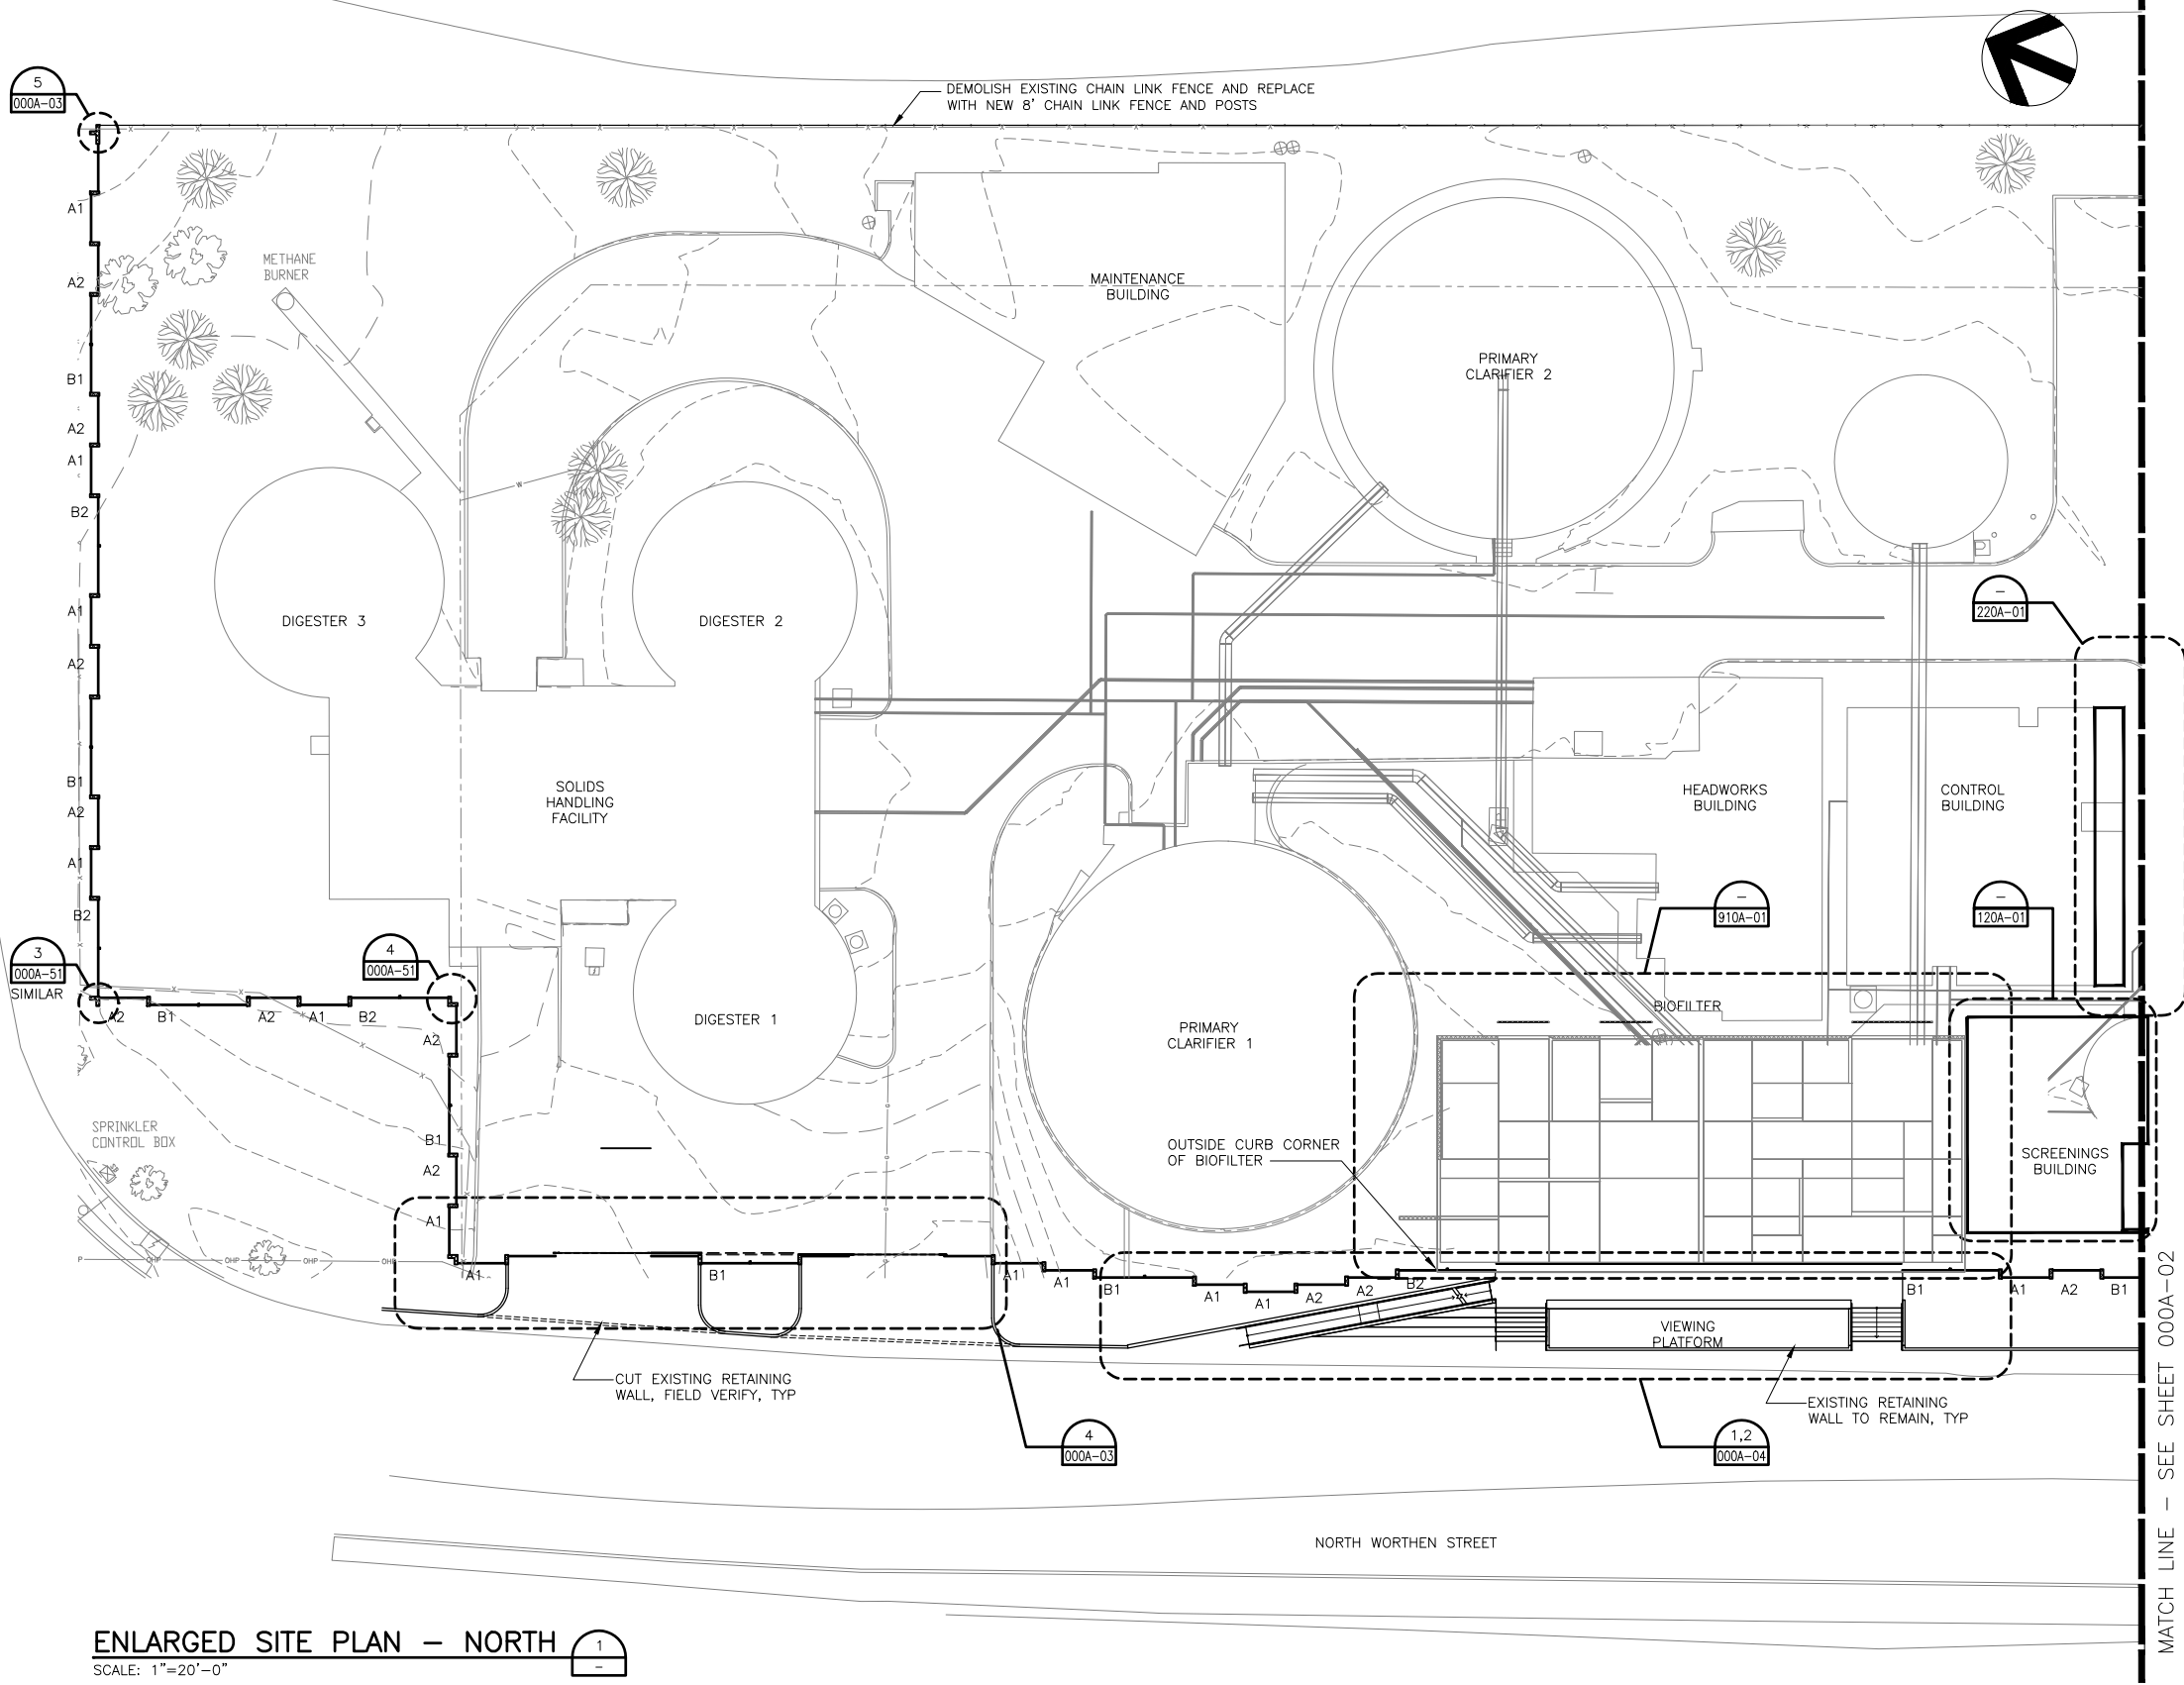

- GENERAL NOTES:
- A. SEE 000A-61 FOR FENCE TYPES.
 - B. CONTRACTOR TO FIELD VERIFY NEW FENCE LOCATION PER OUTSIDE CURB CORNER OF BIOFILTER.
 - C. RE-ROOF @ EXISTING CONTROL BUILDING PER SPEC
 - D. REPLACE ALL EXISTING COPING PER SPEC @ SOLID HANDLING FACILITY, DIGESTER, MAINTENANCE BUILDING, HEADWORKS BUILDING, BLOWER BUILDING
 - E. REPAINT ALL EXISTING BUILDINGS W/ NEW COLOR PER SPEC


ENLARGED SITE PLAN - NORTH
SCALE: 1"=20'-0"

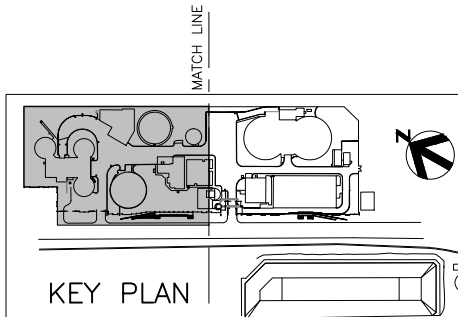

| | | |
|-------|----------|----------------------------------|
| | | |
| | | |
| | | |
| | | |
| 1 | APR 2014 | RECORD DRAWINGS |
| 0 | NOV 2011 | ISSUE FOR CONSTRUCTION SUBMITTAL |
| ISSUE | DATE | DESCRIPTION |

| | |
|-----------------|-------------|
| PROJECT MANAGER | A. MEILLEUR |
| DESIGNED | D. HOGAN |
| DRAWN | J. ZHAO |
| CHECKED | |
| PROJECT NUMBER | 171097 |


ELECTRONIC SEAL AND SIGNATURE HAS BEEN REMOVED. THIS MEDIA SHOULD NOT BE CONSIDERED A CERTIFIED DOCUMENT

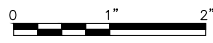

| | | |
|----------|-------------|---------|
| FILENAME | 000A-01.dwg | SHEET |
| SCALE | 1"=20'-0" | 000A-01 |


SITE ARCHITECTURAL PLAN - NORTH

ELECTRONIC MEDIA DISCLAIMER: THIS ELECTRONIC MEDIA PROVIDED BY HDR ENGINEERING, INC. IS SUBJECT TO AN ELECTRONIC MEDIA RELEASE. ALL USE AND RE-USE OF THIS MEDIA IS SUBJECT TO THE TERMS AND CONDITIONS OF THE RELEASE.

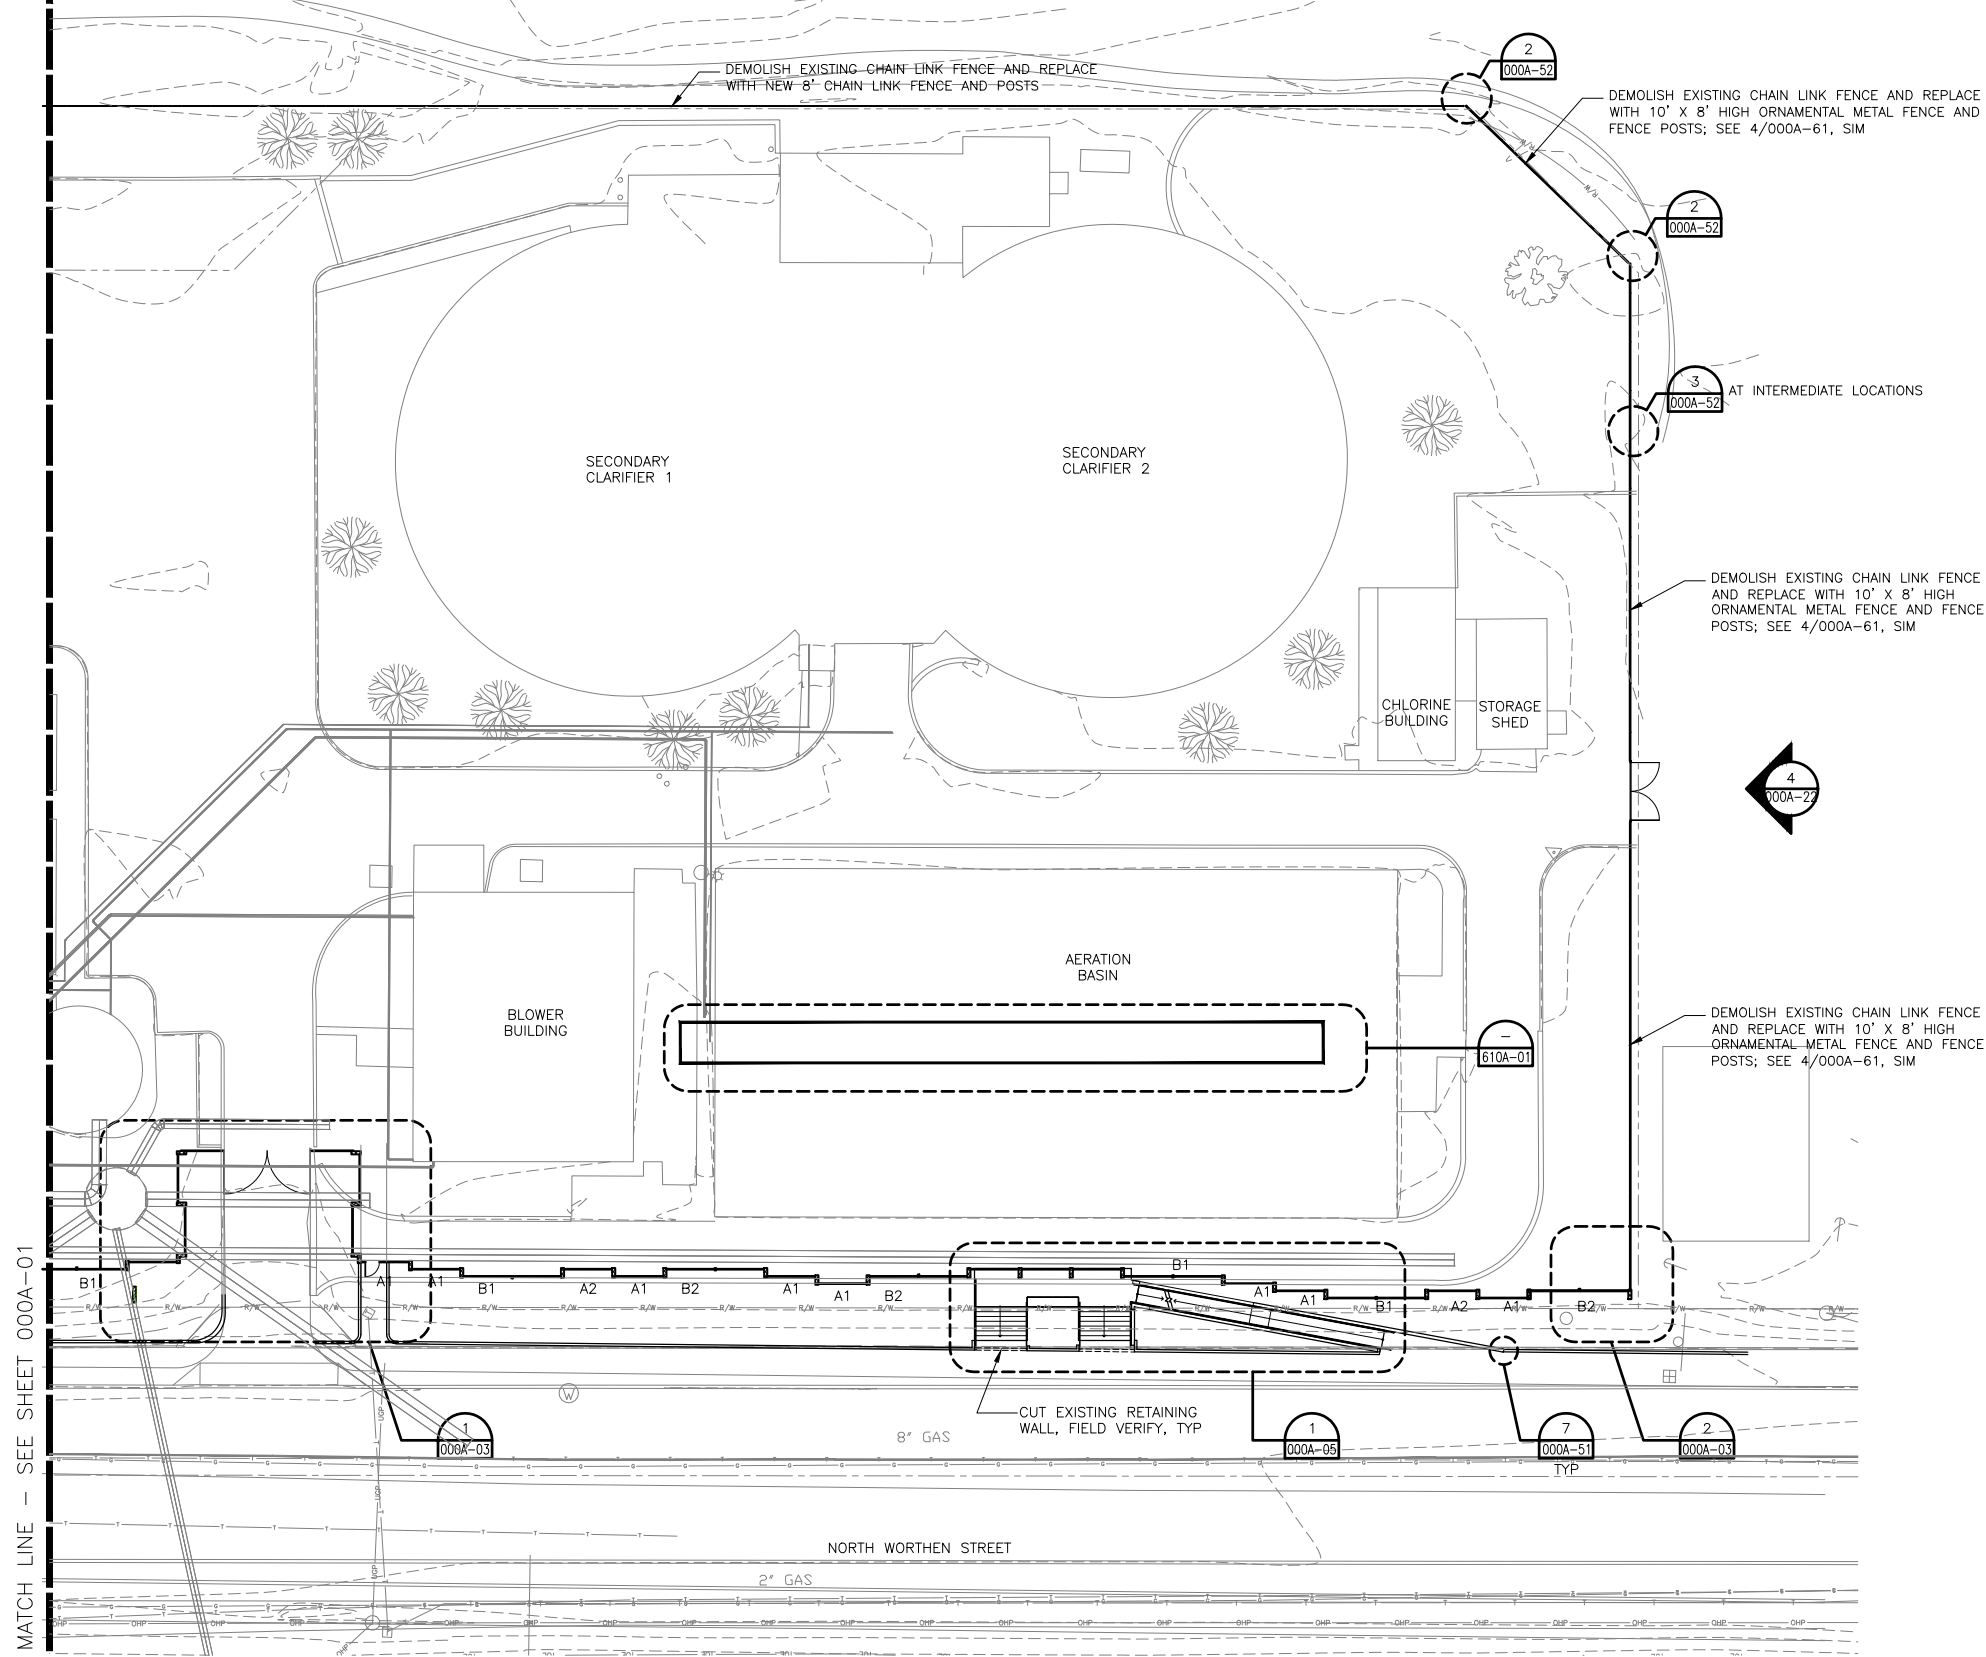

- GENERAL NOTES:
- A. SEE 000A-61 FOR FENCE TYPES.
 - B. CONTRACTOR TO FIELD VERIFY FINAL NEW FENCE LOCATION PER OUTSIDE CURB CORNER OF BIOFILTER.
 - C. RE-ROOF @ EXISTING CONTROL BUILDING PER SPEC
 - D. REPLACE ALL EXISTING COPING PER SPEC @ SOLID HANDLING FACILITY, DIGESTER, MAINTENANCE BUILDING, HEADWORKS BUILDING, BLOWER BUILDING
 - E. REPAINT ALL EXISTING BUILDINGS W/ NEW COLOR PER SPEC

ENLARGED SITE PLAN - SOUTH
SCALE: 1"=20'-0"

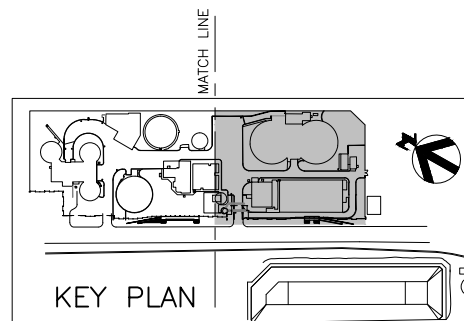

| | | |
|-------|----------|----------------------------------|
| | | |
| | | |
| | | |
| | | |
| 1 | APR 2014 | RECORD DRAWINGS |
| 0 | NOV 2011 | ISSUE FOR CONSTRUCTION SUBMITTAL |
| ISSUE | DATE | DESCRIPTION |

| | |
|-----------------|-------------|
| PROJECT MANAGER | A. MEILLEUR |
| DESIGNED | D. HOGAN |
| DRAWN | J. ZHAO |
| CHECKED | |
| PROJECT NUMBER | 171097 |

ELECTRONIC SEAL AND
SIGNATURE HAS BEEN
REMOVED. THIS MEDIA
SHOULD NOT BE CONSIDERED
A CERTIFIED DOCUMENT




SITE
ARCHITECTURAL PLAN - SOUTH



FILENAME 000A-02.dwg
SCALE 1"=20'-0"

SHEET
000A-02

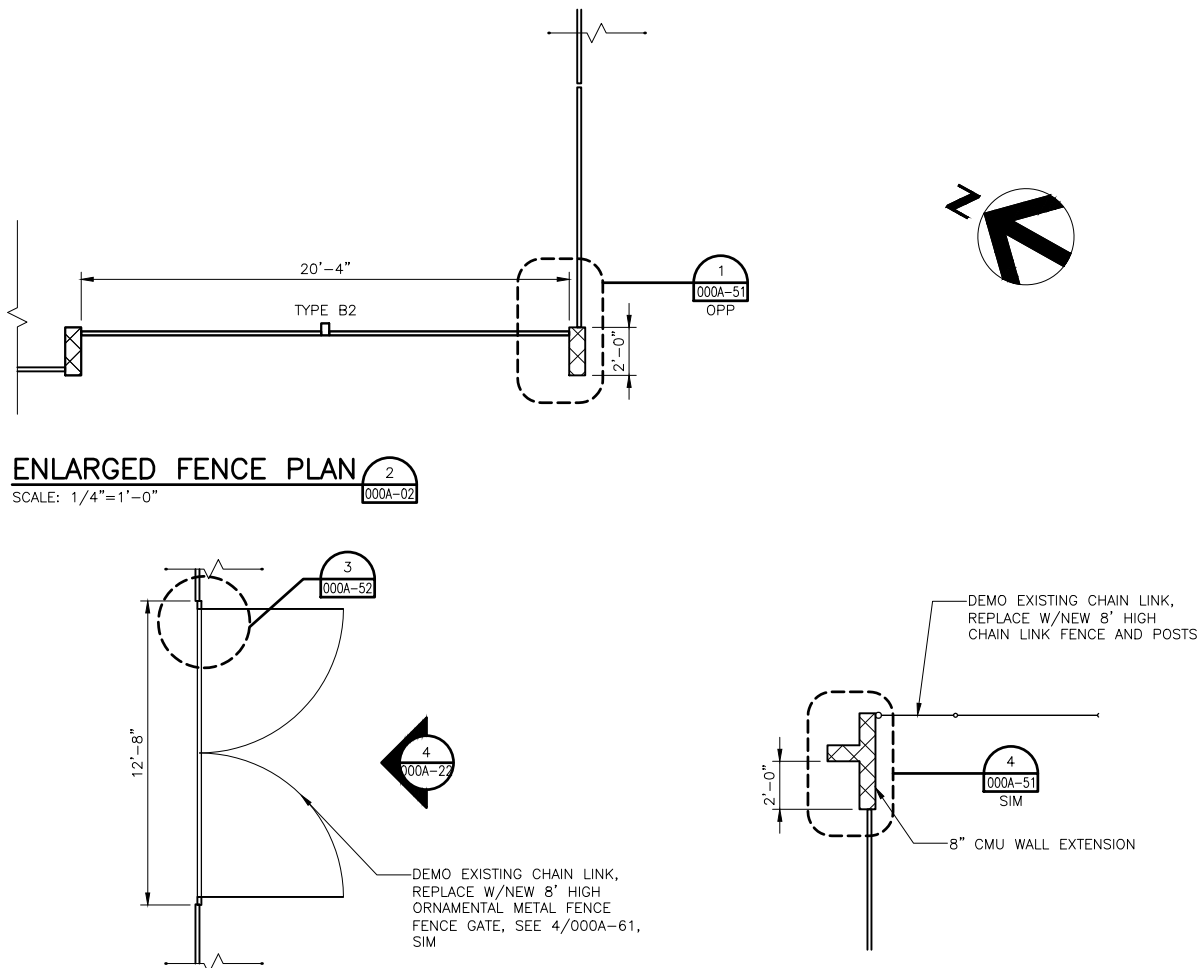[illegible]

ENLARGED FENCE PLAN

SCALE: 1/4"=1'-0"

5

000A-02



UNDERGROUND SERVICE ALERT

 **ONE-CALL NUMBER**
1-800-424-5555

**CALL TWO BUSINESS DAYS
BEFORE YOU DIG**




| | |
|-----------------|-------------|
| PROJECT MANAGER | A. MEILLEUR |
| DESIGNED | D. HOGAN |
| DRAWN | J. ZHAO |
| CHECKED | |
| PROJECT NUMBER | 171097 |

**ELECTRONIC SEAL AND
SIGNATURE HAS BEEN
REMOVED. THIS MEDIA
SHOULD NOT BE CONSIDERED
A CERTIFIED DOCUMENT**




SITE ENLARGED ARCHITECTURAL PLANS

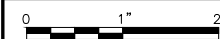


| | | |
|----------|-------------|-------------------------|
| FILENAME | 000A-03.dwg | SHEET 000A-03 |
| SCALE | 1/4"=1'-0" | |

TELEVISION MEDIA DISCLAIMER: THIS ELECTRONIC MEDIA PROVIDED BY HDR ENGINEERING, INC. IS SUBJECT TO AN ELECTRONIC MEDIA RELEASE. ALL USE AND RE-USE OF THIS MEDIA IS SUBJECT TO THE TERMS AND CONDITIONS OF THE RELEASE.

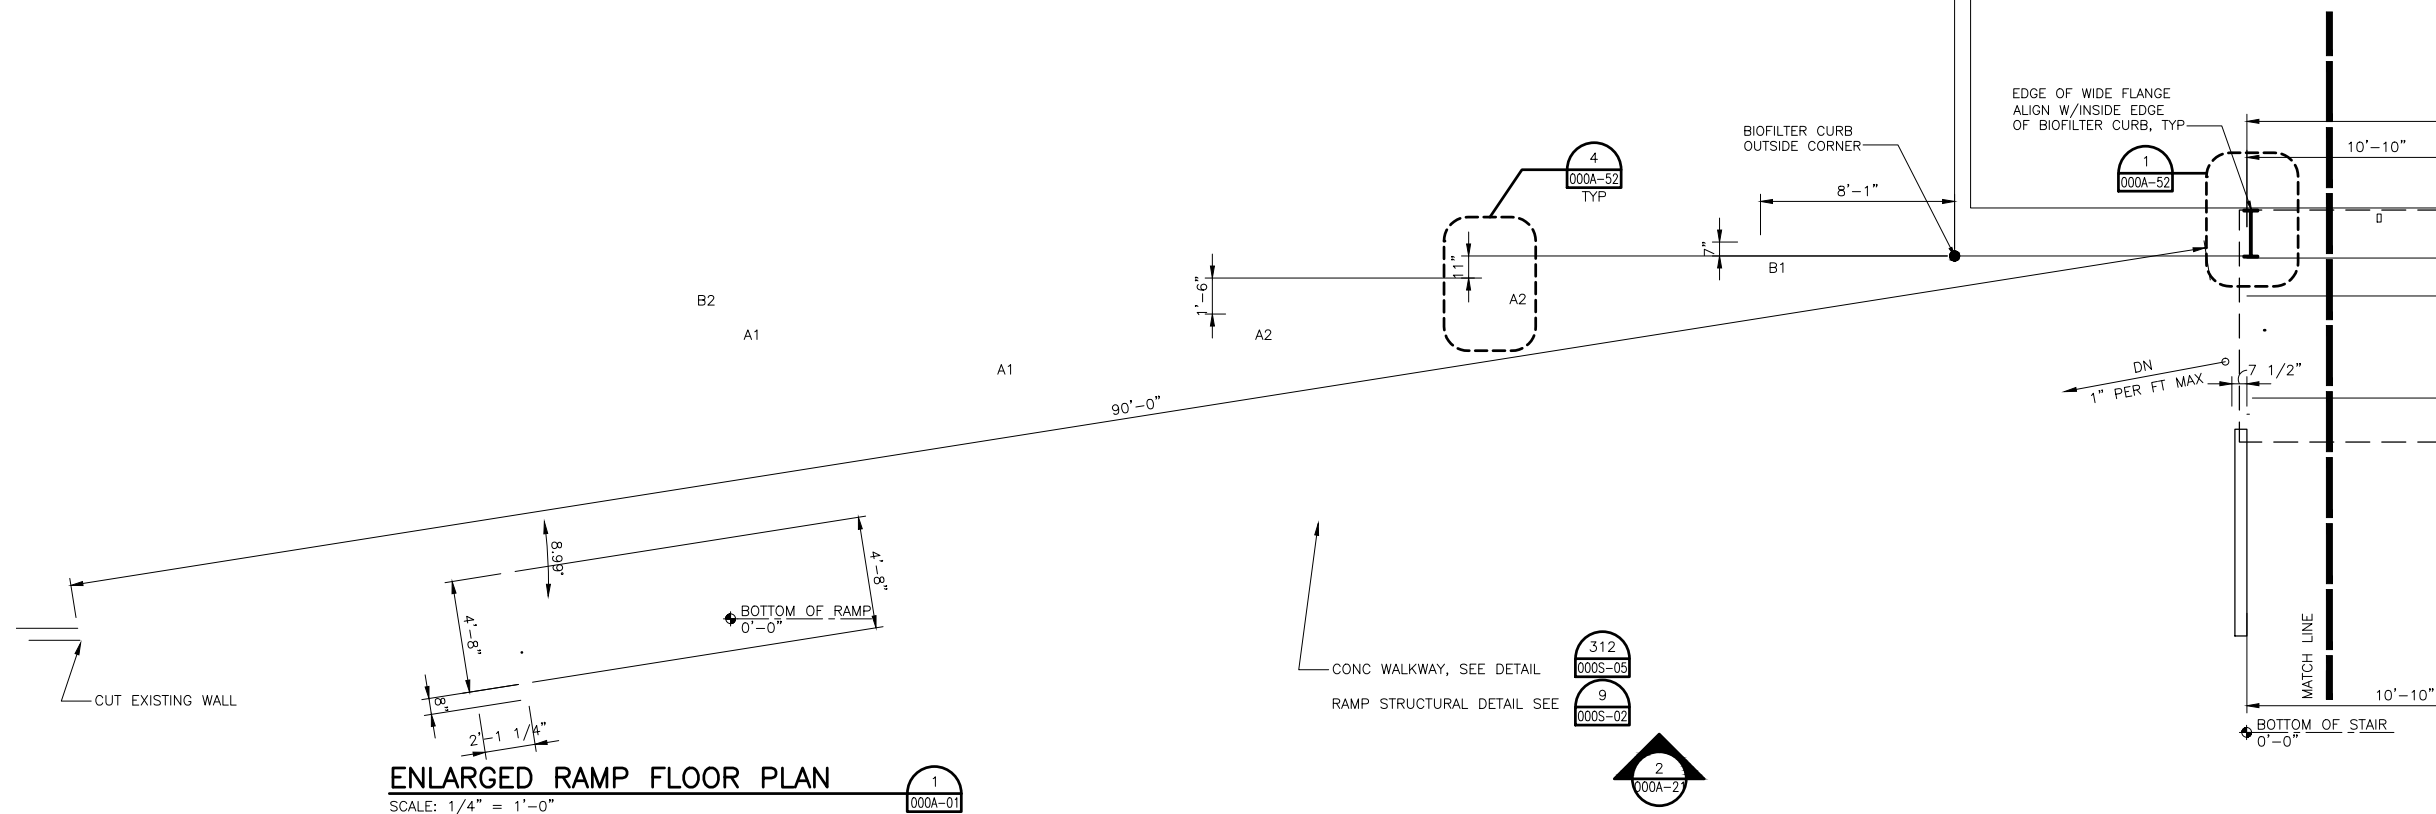

- GENERAL NOTES:
- A. SEE 000A-61 FOR FENCE TYPES.
 - B. CONTRACTOR TO FIELD VERIFY NEW FENCE LOCATION PER OUTSIDE CURB CORNER OF BIOLIFTER.
 - C. RE-ROOF @ EXISTING CONTROL BUILDING PER SPEC
 - D. REPLACE ALL EXISTING COPING PER SPEC @ SOLID HANDLING FACILITY, DIGESTER, MAINTENANCE BUILDING, HEADWORKS BUILDING, SLOPE BUILDING
 - E. REPAINT ALL EXISTING BUILDINGS W/ NEW COLOR PER SPEC

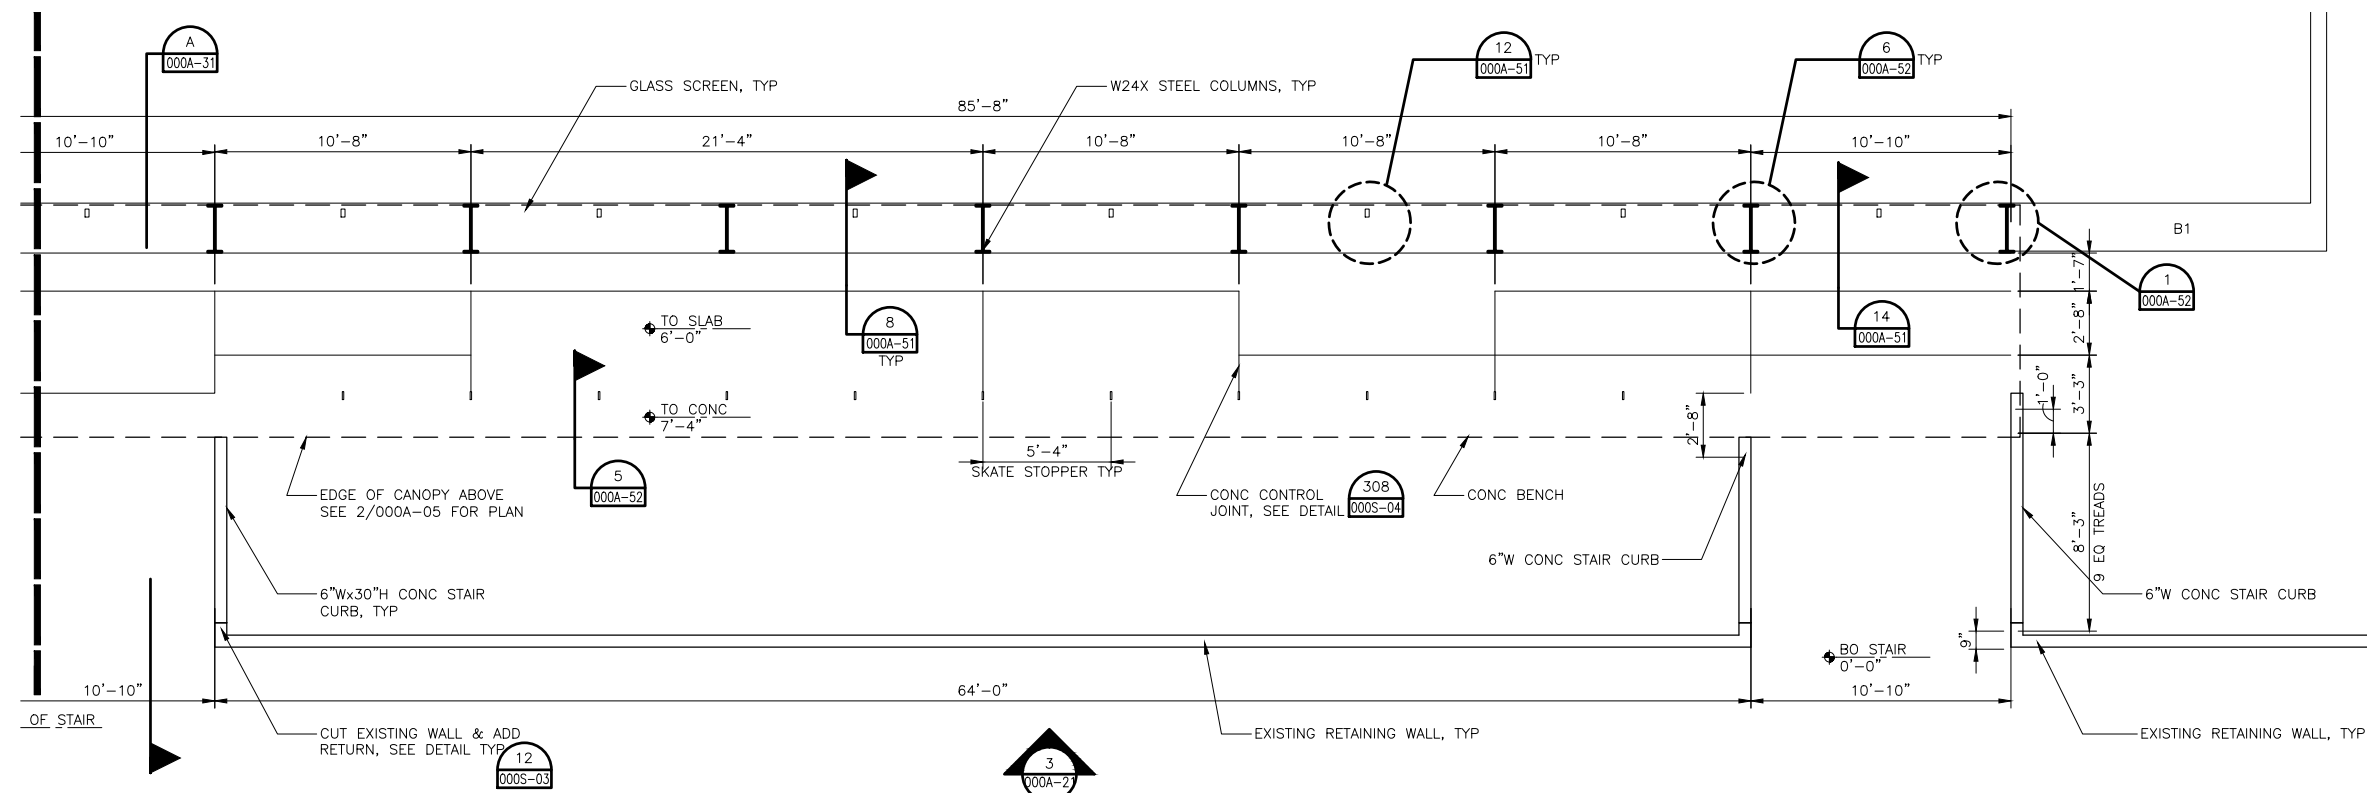

ENLARGED NORTH VIEW PLATFORM PLAN

SCALE: $1/4" = 1'-0"$



| 1 | APR 2014 | RECORD DRAWINGS |
|-------|-----------|----------------------------------|
| 0 | NOV. 2011 | ISSUE FOR CONSTRUCTION SUBMITTAL |
| ISSUE | DATE | DESCRIPTION |

| | |
|-----------------|-------------|
| PROJECT MANAGER | A. MEILLEUR |
| DESIGNED | D. HOGAN |
| DRAWN | J. ZHAO |
| CHECKED | |
| PROJECT NUMBER | 171097 |


**ELECTRONIC SEAL AND
SIGNATURE HAS BEEN
REMOVED. THIS MEDIA
SHOULD NOT BE CONSIDERED
A CERTIFIED DOCUMENT**



SITE ENLARGED VIEW PLATFORM PLANS



| | | |
|----------|-------------|-------------------------|
| FILENAME | 000A-04.dwg | SHEET 000A-04 |
| SCALE | 1/4"=1'-0" | |

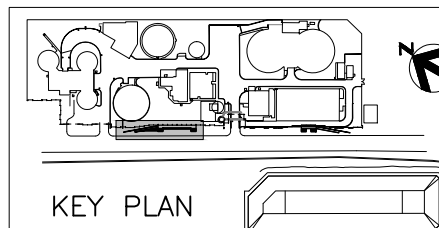

[illegible]


1
000A-02




SHEET

000A-05

ELECTRONIC MEDIA DISCLAIMER: THIS ELECTRONIC MEDIA PROVIDED BY HDR ENGINEERING, INC. IS SUBJECT TO AN ELECTRONIC MEDIA RELEASE. ALL USE AND RE-USE OF THIS MEDIA IS SUBJECT TO THE TERMS AND CONDITIONS OF THE RELEASE.

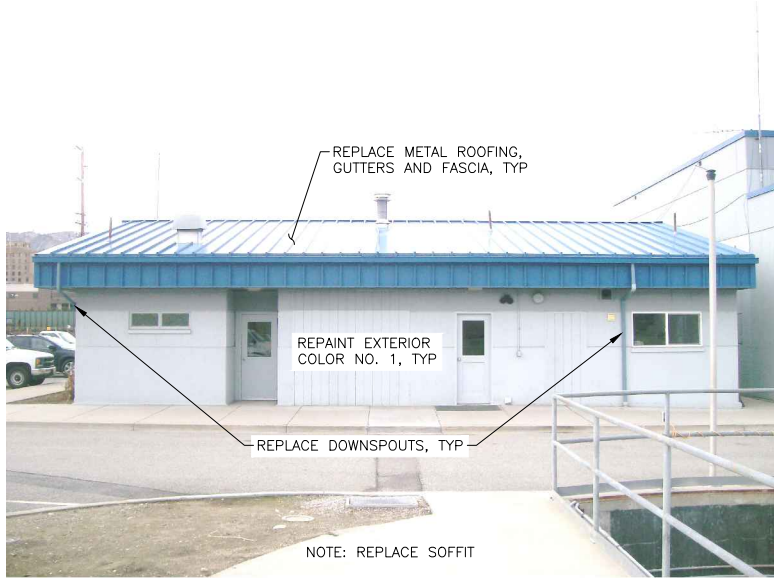

CONTROL BUILDING – EAST
NOT TO SCALE

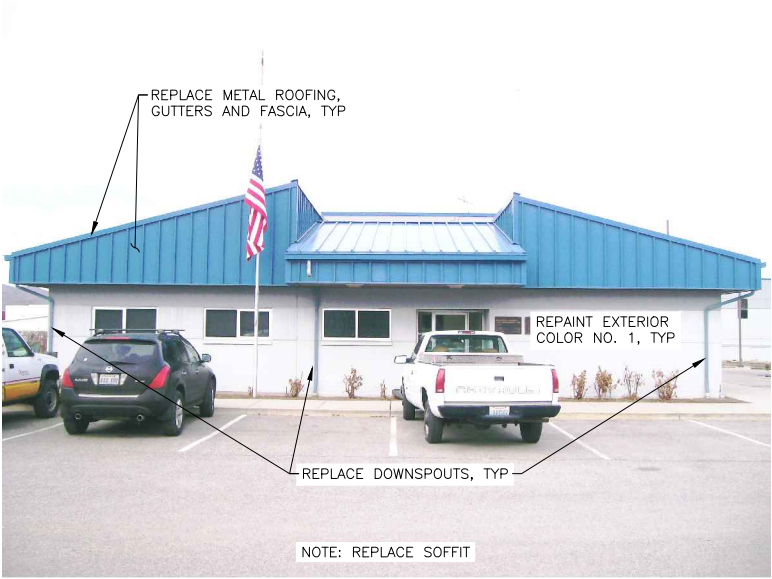


CONTROL BUILDING – SOUTH
NOT TO SCALE




CONTROL BUILDING – WEST
NOT TO SCALE

GENERAL NOTES (SHEET 00A-07 THRU 00A-012):

1. ALL NEW AND REPLACED LIGHTING FIXTURE LOCATIONS TO BE FIELD LOCATED AND VERIFIED BEFORE ORDERING AND MOUNTING.
2. LIGHTING CONTRACTOR TO FURNISH AND INSTALL LIGHTS PER THE LIGHTING FIXTURES SCHEDULE AND ARCHITECTURAL THEME LIGHTING SCHEDULE ON SHEET 000E-14.
3. AS NOTED ON DETAILS, CONTRACTOR TO "REPAINT EXTERIOR COLOR NO. 1," IS DEFINED AS THE ENTIRE EXTERIOR OF THE BUILDING, INCLUDING HANDRAILS, LOUVERS, DOORS, PIPING, ETC. ARE TO BE PAINTED ALONG WITH THE CONCRETE WALLS IN ONE COLOR.

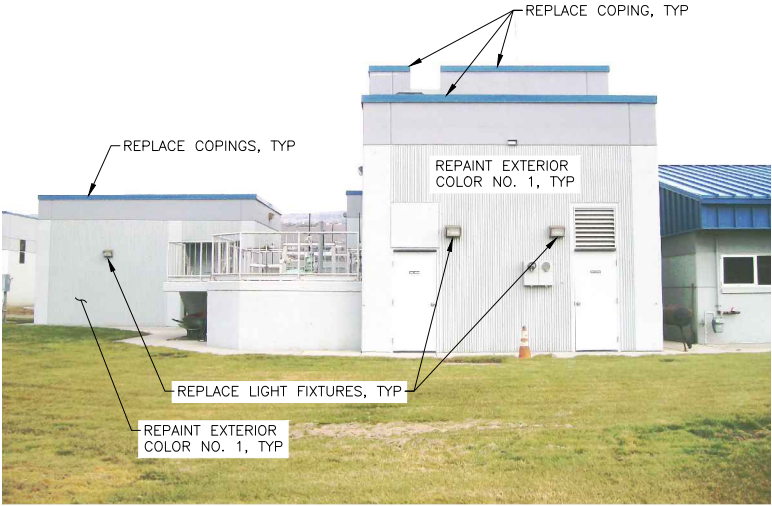

HEADWORKS BUILDING – WEST
NOT TO SCALE

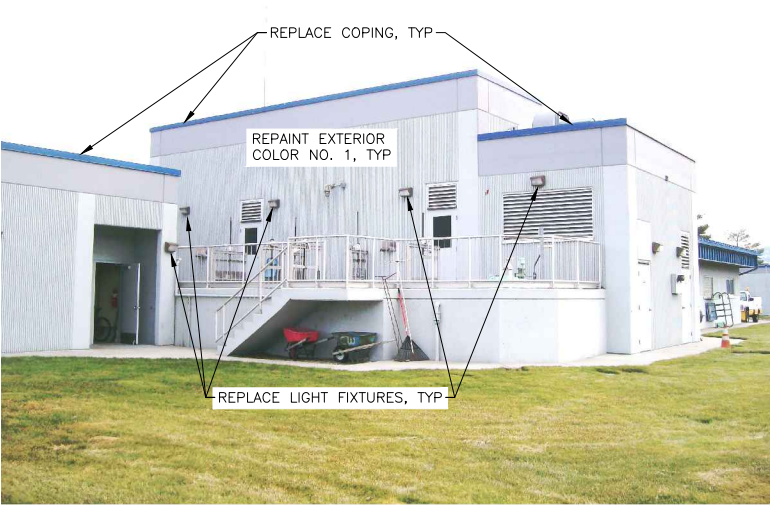

HEADWORKS BUILDING – NORTHWEST
NOT TO SCALE



| | | |
|-------|----------|----------------------------------|
| | | |
| | | |
| | | |
| | | |
| 1 | APR 2014 | RECORD DRAWINGS |
| 0 | NOV 2011 | ISSUE FOR CONSTRUCTION SUBMITTAL |
| ISSUE | DATE | DESCRIPTION |

| | |
|-----------------|-------------|
| PROJECT MANAGER | A. MEILLEUR |
| DESIGNED | D. HOGAN |
| DRAWN | B. LILLY |
| CHECKED | |
| PROJECT NUMBER | 171097 |

ELECTRONIC SEAL AND
SIGNATURE HAS BEEN
REMOVED. THIS MEDIA
SHOULD NOT BE CONSIDERED
A CERTIFIED DOCUMENT




ARCHITECTURE
EXISTING BUILDING MODIFICATIONS 1




| | |
|----------|--------------|
| FILENAME | 000A-07.dwg |
| SCALE | NOT TO SCALE |

| | |
|-------|---------|
| SHEET | 000A-07 |
|-------|---------|


ELECTRONIC MEDIA DISCLAIMER: THIS ELECTRONIC MEDIA PROVIDED BY HDR ENGINEERING, INC. IS SUBJECT TO AN ELECTRONIC MEDIA RELEASE. ALL USE AND RE-USE OF THIS MEDIA IS SUBJECT TO THE TERMS AND CONDITIONS OF THE RELEASE.

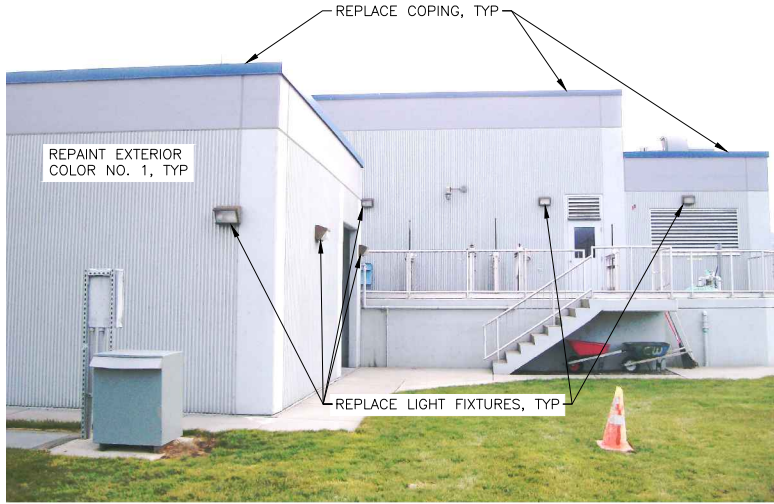


HEADWORKS BUILDING – NORTH
NOT TO SCALE

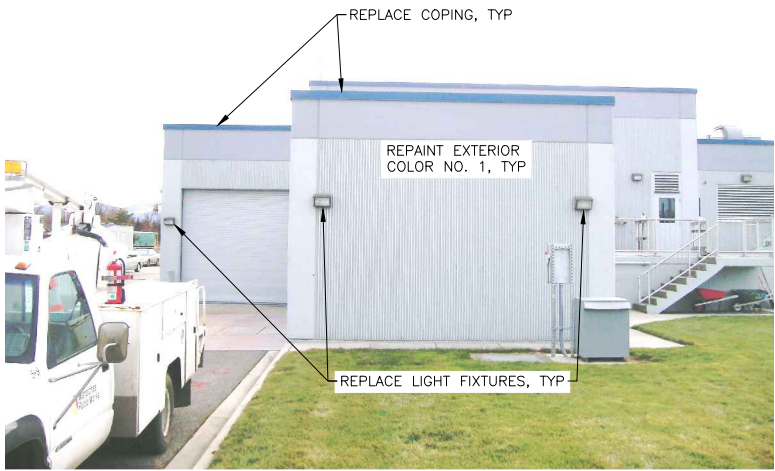


HEADWORKS BUILDING – NORTH
NOT TO SCALE

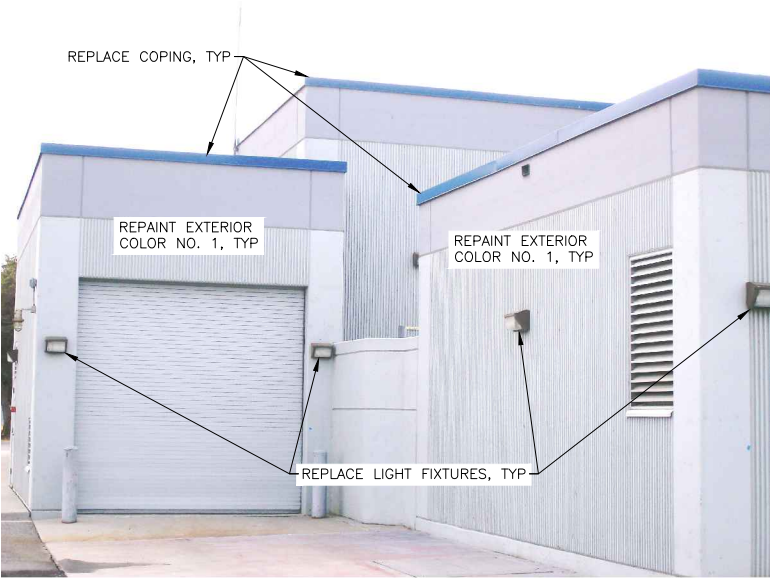


HEADWORKS BUILDING – NORTHEAST
NOT TO SCALE

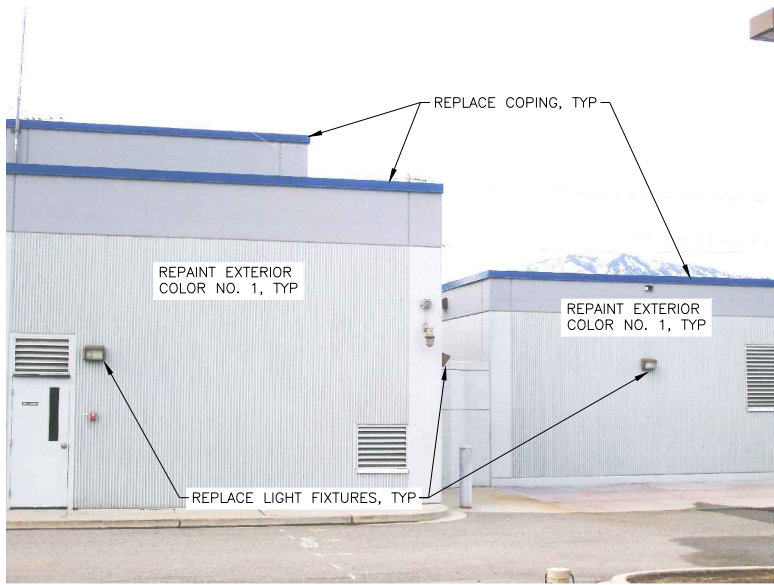

HEADWORKS BUILDING – EAST
NOT TO SCALE

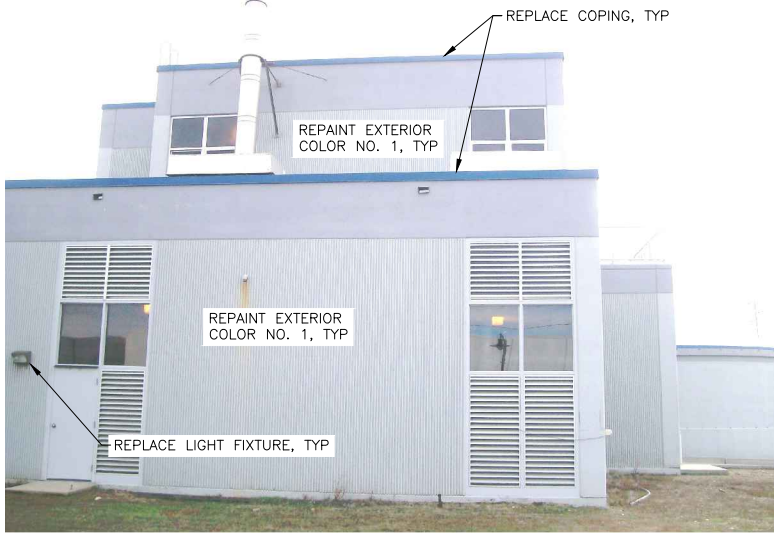

SOLIDS HANDLING BUILDING – NORTH
NOT TO SCALE

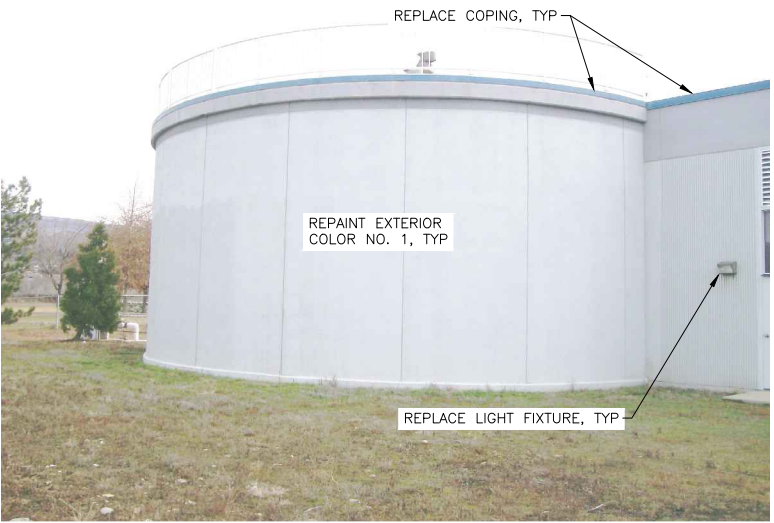

SOLIDS DIGESTER NO. 3 – NORTHWEST
NOT TO SCALE




| | | |
|-------|----------|----------------------------------|
| | | |
| | | |
| | | |
| | | |
| 1 | APR 2014 | RECORD DRAWINGS |
| 0 | NOV 2011 | ISSUE FOR CONSTRUCTION SUBMITTAL |
| ISSUE | DATE | DESCRIPTION |

| | |
|-----------------|-------------|
| PROJECT MANAGER | A. MEILLEUR |
| DESIGNED | D. HOGAN |
| DRAWN | B. LILLY |
| CHECKED | |
| PROJECT NUMBER | 171097 |

ELECTRONIC SEAL AND
SIGNATURE HAS BEEN
REMOVED. THIS MEDIA
SHOULD NOT BE CONSIDERED
A CERTIFIED DOCUMENT



ARCHITECTURE
EXISTING BUILDING MODIFICATIONS 2

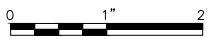


| | |
|----------|--------------|
| FILENAME | 000A-08.dwg |
| SCALE | NOT TO SCALE |

| |
|----------------|
| SHEET |
| 000A-08 |

ELECTRONIC MEDIA DISCLAIMER: THIS ELECTRONIC MEDIA PROVIDED BY HDR ENGINEERING, INC. IS SUBJECT TO AN ELECTRONIC MEDIA RELEASE. ALL USE AND RE-USE OF THIS MEDIA IS SUBJECT TO THE TERMS AND CONDITIONS OF THE RELEASE.



SOLIDS DIGESTER NO. 3 – SOUTHEAST
NOT TO SCALE

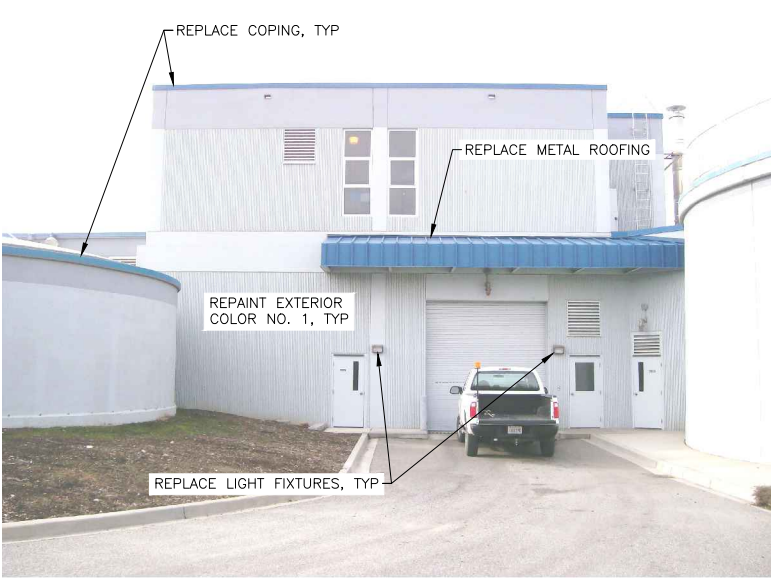


SOLIDS HANDLING BUILDING – EAST
NOT TO SCALE



SOLIDS DIGESTER NO. 2 – NORTHEAST
NOT TO SCALE



SOLIDS DIGESTER NO. 2 – SOUTH
NOT TO SCALE

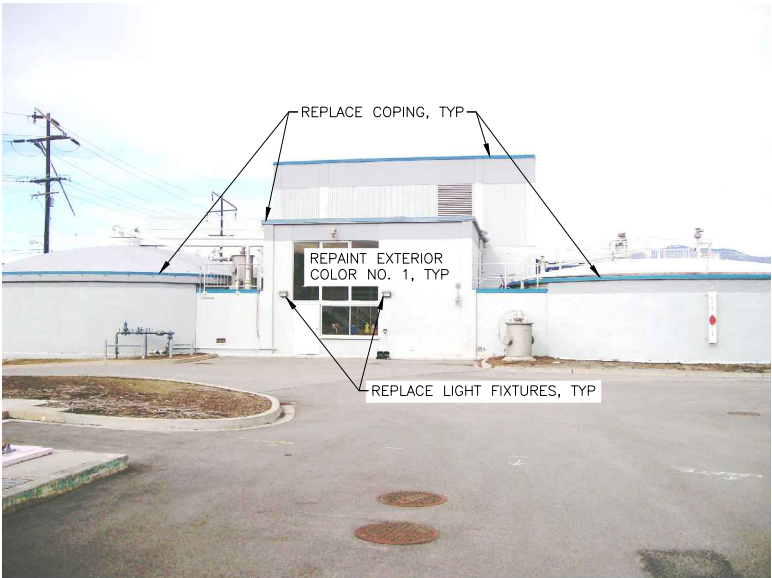

SOLIDS HANDLING BUILDING – SOUTH
NOT TO SCALE



SOLIDS HANDLING BUILDING – SOUTH
NOT TO SCALE



| | | |
|-------|----------|----------------------------------|
| | | |
| | | |
| | | |
| | | |
| 1 | APR 2014 | RECORD DRAWINGS |
| 0 | NOV 2011 | ISSUE FOR CONSTRUCTION SUBMITTAL |
| ISSUE | DATE | DESCRIPTION |

| | |
|-----------------|-------------|
| PROJECT MANAGER | A. MEILLEUR |
| DESIGNED | D. HOGAN |
| DRAWN | B. LILLY |
| CHECKED | |
| PROJECT NUMBER | 171097 |

ELECTRONIC SEAL AND
SIGNATURE HAS BEEN
REMOVED. THIS MEDIA
SHOULD NOT BE CONSIDERED
A CERTIFIED DOCUMENT



ARCHITECTURE
EXISTING BUILDING MODIFICATIONS 3



| | |
|----------|--------------|
| FILENAME | 000A-09.dwg |
| SCALE | NOT TO SCALE |

| |
|---------|
| SHEET |
| 000A-09 |

ELECTRONIC MEDIA DISCLAIMER: THIS ELECTRONIC MEDIA PROVIDED BY HDR ENGINEERING, INC. IS SUBJECT TO AN ELECTRONIC MEDIA RELEASE. ALL USE AND RE-USE OF THIS MEDIA IS SUBJECT TO THE TERMS AND CONDITIONS OF THE RELEASE.




SOLIDS DIGESTER NO. 1 – SOUTHEAST
NOT TO SCALE




SOLIDS DIGESTER NO. 1 – WEST
NOT TO SCALE



SOLIDS HANDLING BUILDING – WEST
NOT TO SCALE

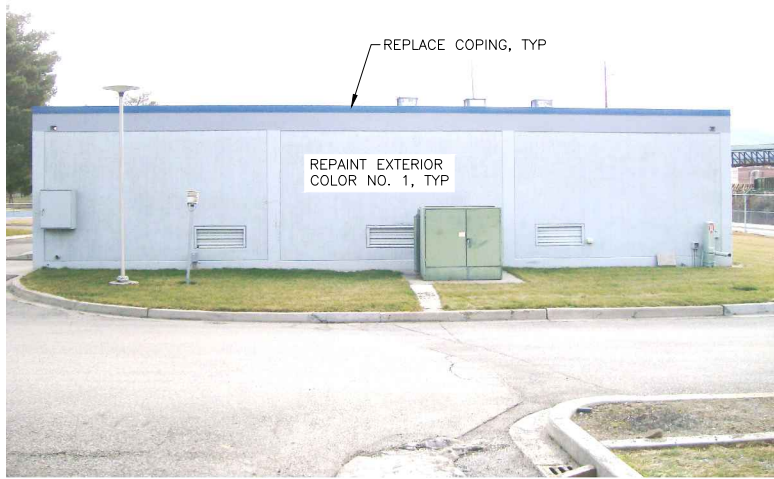

BLOWER BUILDING – NORTH
NOT TO SCALE

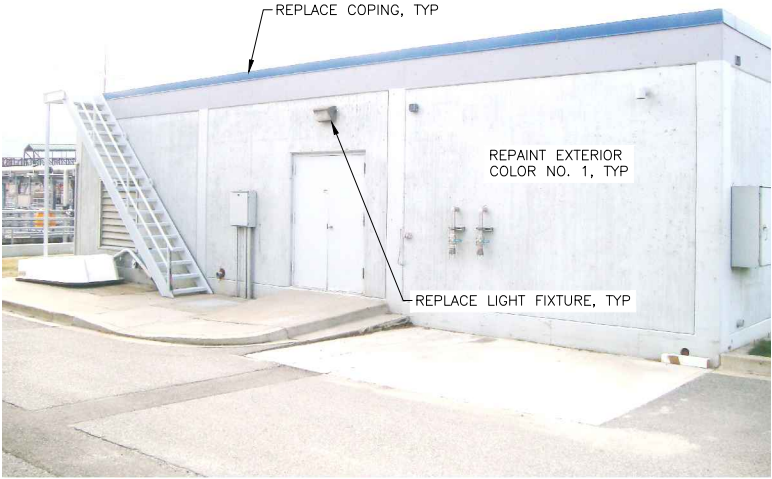

BLOWER BUILDING – EAST
NOT TO SCALE



BLOWER BUILDING – SOUTH
NOT TO SCALE



| | | |
|-------|----------|----------------------------------|
| | | |
| | | |
| | | |
| | | |
| 1 | APR 2014 | RECORD DRAWINGS |
| 0 | NOV 2011 | ISSUE FOR CONSTRUCTION SUBMITTAL |
| ISSUE | DATE | DESCRIPTION |

| | |
|-----------------|-------------|
| PROJECT MANAGER | A. MEILLEUR |
| DESIGNED | D. HOGAN |
| DRAWN | B. LILLY |
| CHECKED | |
| PROJECT NUMBER | 171097 |

ELECTRONIC SEAL AND
SIGNATURE HAS BEEN
REMOVED. THIS MEDIA
SHOULD NOT BE CONSIDERED
A CERTIFIED DOCUMENT



ARCHITECTURE
EXISTING BUILDING MODIFICATIONS 4




| | |
|----------|--------------|
| FILENAME | 000A-10.dwg |
| SCALE | NOT TO SCALE |

| |
|---------|
| SHEET |
| 000A-10 |

ELECTRONIC MEDIA DISCLAIMER: THIS ELECTRONIC MEDIA PROVIDED BY HDR ENGINEERING, INC. IS SUBJECT TO AN ELECTRONIC MEDIA RELEASE. ALL USE AND RE-USE OF THIS MEDIA IS SUBJECT TO THE TERMS AND CONDITIONS OF THE RELEASE.




BLOWER BUILDING MCC ROOM – SOUTH
NOT TO SCALE

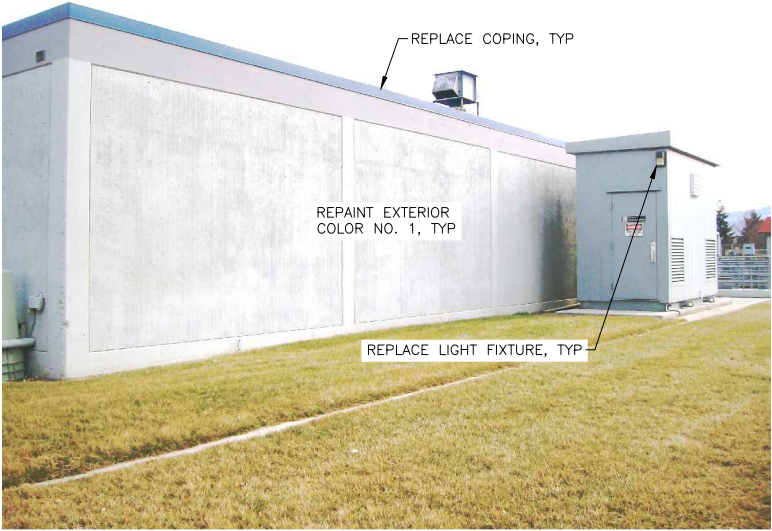

BLOWER BUILDING – WEST
NOT TO SCALE



BLOWER BUILDING MCC ROOM – NORTHWEST
NOT TO SCALE

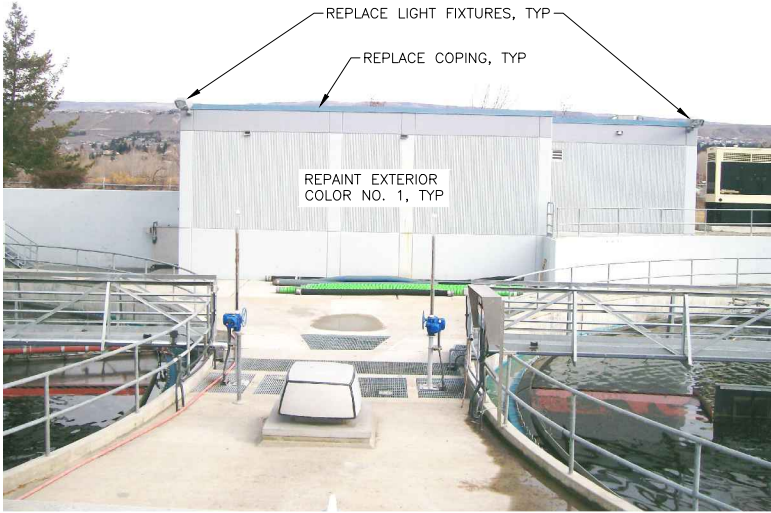

UV BUILDING – WEST
NOT TO SCALE



UV BUILDING – SOUTH
NOT TO SCALE



CHLORINE BUILDING & SHED – NORTHWEST
NOT TO SCALE

UNDERGROUND SERVICE ALERT
ONE-CALL NUMBER
1-800-424-5555
CALL TWO BUSINESS DAYS
BEFORE YOU DIG

HDR
HDR Engineering, Inc.

| | | |
|-------|----------|----------------------------------|
| | | |
| | | |
| | | |
| | | |
| 1 | APR 2014 | RECORD DRAWINGS |
| 0 | NOV 2011 | ISSUE FOR CONSTRUCTION SUBMITTAL |
| ISSUE | DATE | DESCRIPTION |

| | |
|-----------------|-------------|
| PROJECT MANAGER | A. MEILLEUR |
| DESIGNED | D. HOGAN |
| DRAWN | B. LILLY |
| CHECKED | |
| PROJECT NUMBER | 171097 |

ELECTRONIC SEAL AND
SIGNATURE HAS BEEN
REMOVED. THIS MEDIA
SHOULD NOT BE CONSIDERED
A CERTIFIED DOCUMENT

 **City of
Wenatchee**
WASTE WATER TREATMENT
PLANT IMPROVEMENTS


ARCHITECTURE
EXISTING BUILDING MODIFICATIONS 5



| | |
|----------|--------------|
| FILENAME | 000A-11.dwg |
| SCALE | NOT TO SCALE |

| |
|---------|
| SHEET |
| 000A-11 |

ELECTRONIC MEDIA DISCLAIMER: THIS ELECTRONIC MEDIA PROVIDED BY HDR ENGINEERING, INC. IS SUBJECT TO AN ELECTRONIC MEDIA RELEASE. ALL USE AND RE-USE OF THIS MEDIA IS SUBJECT TO THE TERMS AND CONDITIONS OF THE RELEASE.

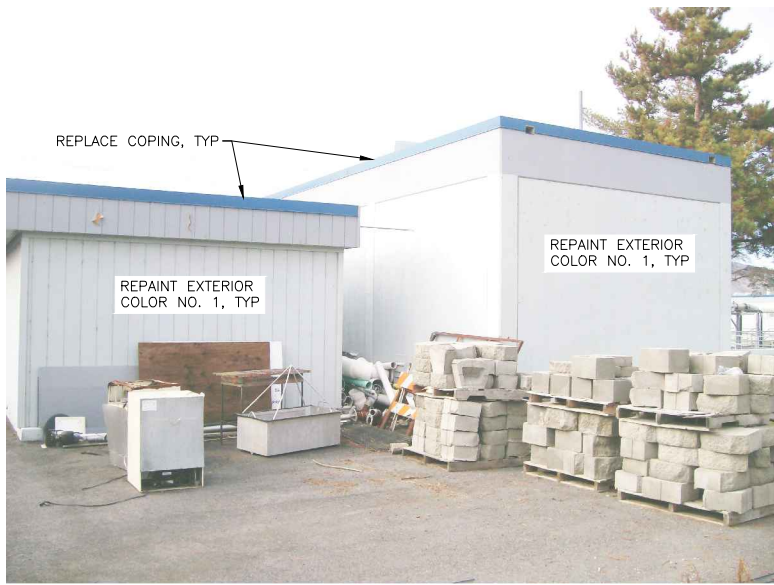

CHLORINE BUILDING & SHED – EAST
NOT TO SCALE




CHLORINE BUILDING & SHED – SOUTHWEST
NOT TO SCALE




CHLORINE BUILDING & SHED – WEST
NOT TO SCALE



MAINTENANCE BUILDING – NORTH
NOT TO SCALE

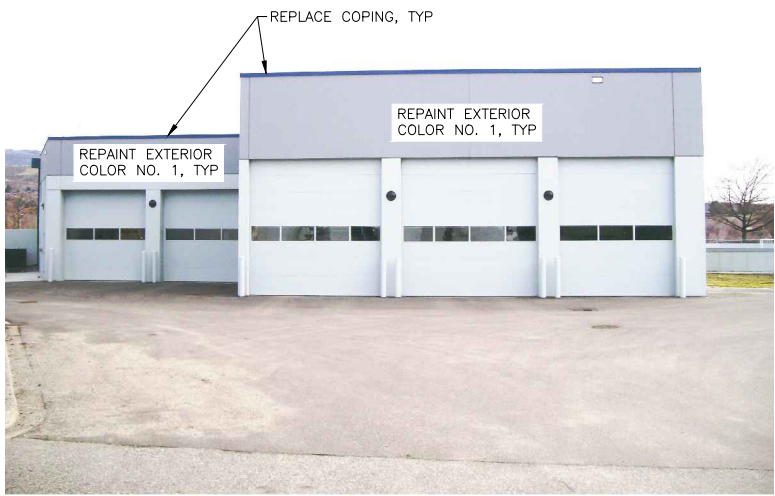

MAINTENANCE BUILDING – EAST
NOT TO SCALE

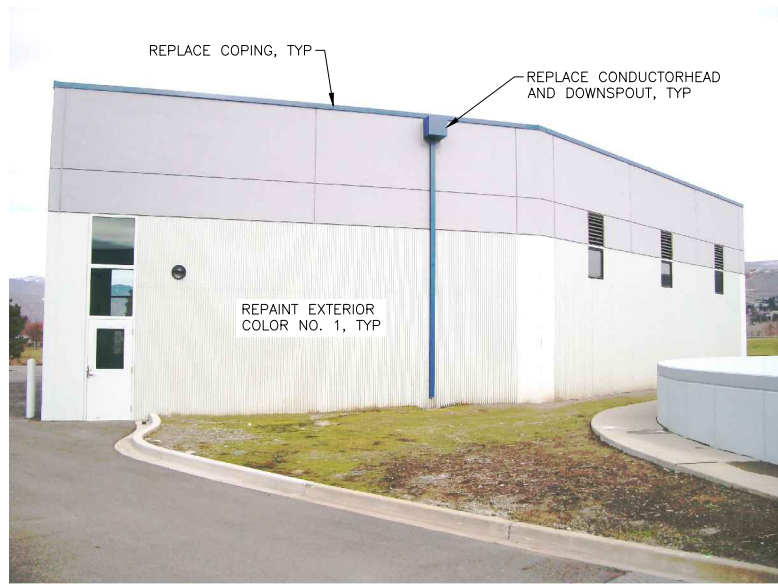

MAINTENANCE BUILDING – SOUTH
NOT TO SCALE



| | | |
|-------|----------|----------------------------------|
| | | |
| | | |
| | | |
| | | |
| 1 | APR 2014 | RECORD DRAWINGS |
| 0 | NOV 2011 | ISSUE FOR CONSTRUCTION SUBMITTAL |
| ISSUE | DATE | DESCRIPTION |

| | |
|-----------------|-------------|
| PROJECT MANAGER | A. MEILLEUR |
| DESIGNED | D. HOGAN |
| DRAWN | B. LILLY |
| CHECKED | |
| PROJECT NUMBER | 171097 |

ELECTRONIC SEAL AND
SIGNATURE HAS BEEN
REMOVED. THIS MEDIA
SHOULD NOT BE CONSIDERED
A CERTIFIED DOCUMENT




ARCHITECTURE
EXISTING BUILDING MODIFICATIONS 6



| | |
|----------|--------------|
| FILENAME | 000A-12.dwg |
| SCALE | NOT TO SCALE |


| |
|---------|
| SHEET |
| 000A-12 |

ELECTRONIC MEDIA DISCLAIMER: THIS ELECTRONIC MEDIA PROVIDED BY HDR ENGINEERING, INC. IS SUBJECT TO THE TERMS AND CONDITIONS OF THE RELEASE.

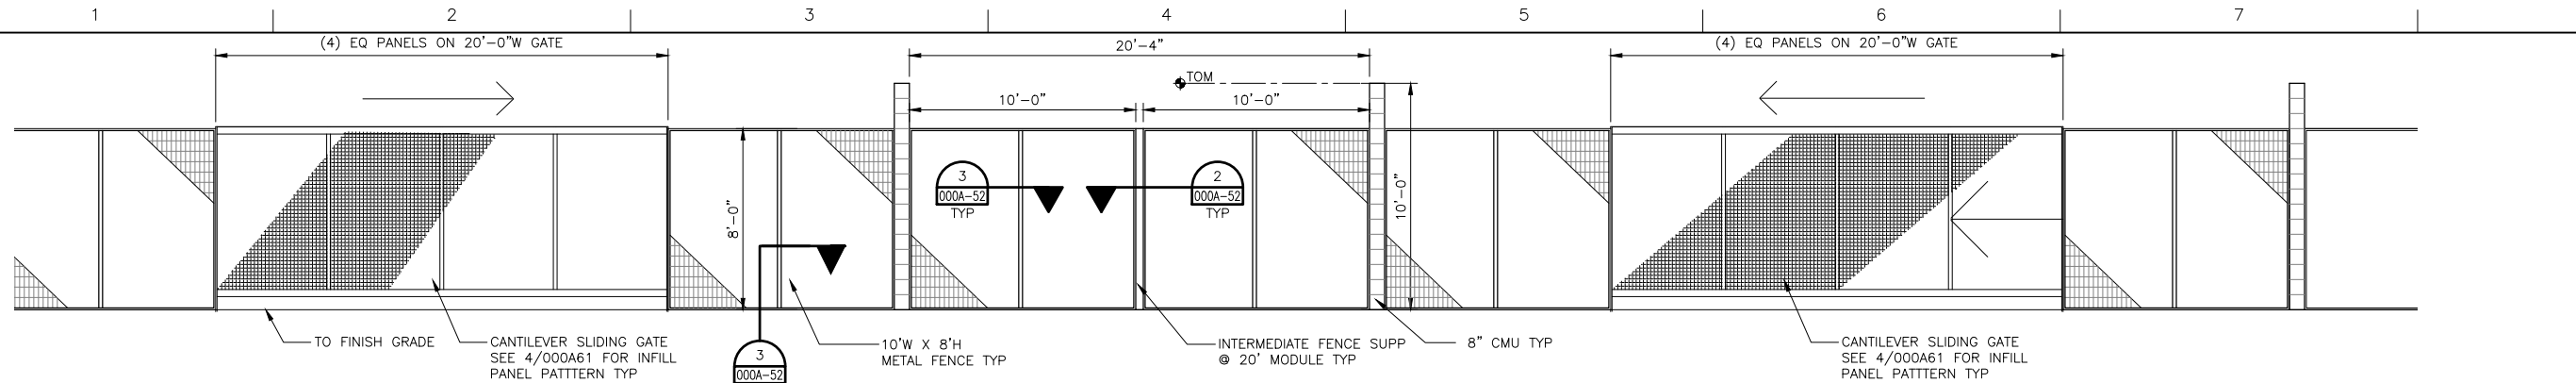


WEST ELEVATION @ ENTRY GATE 1
SCALE: 1/4" = 1'-0"

000A-03

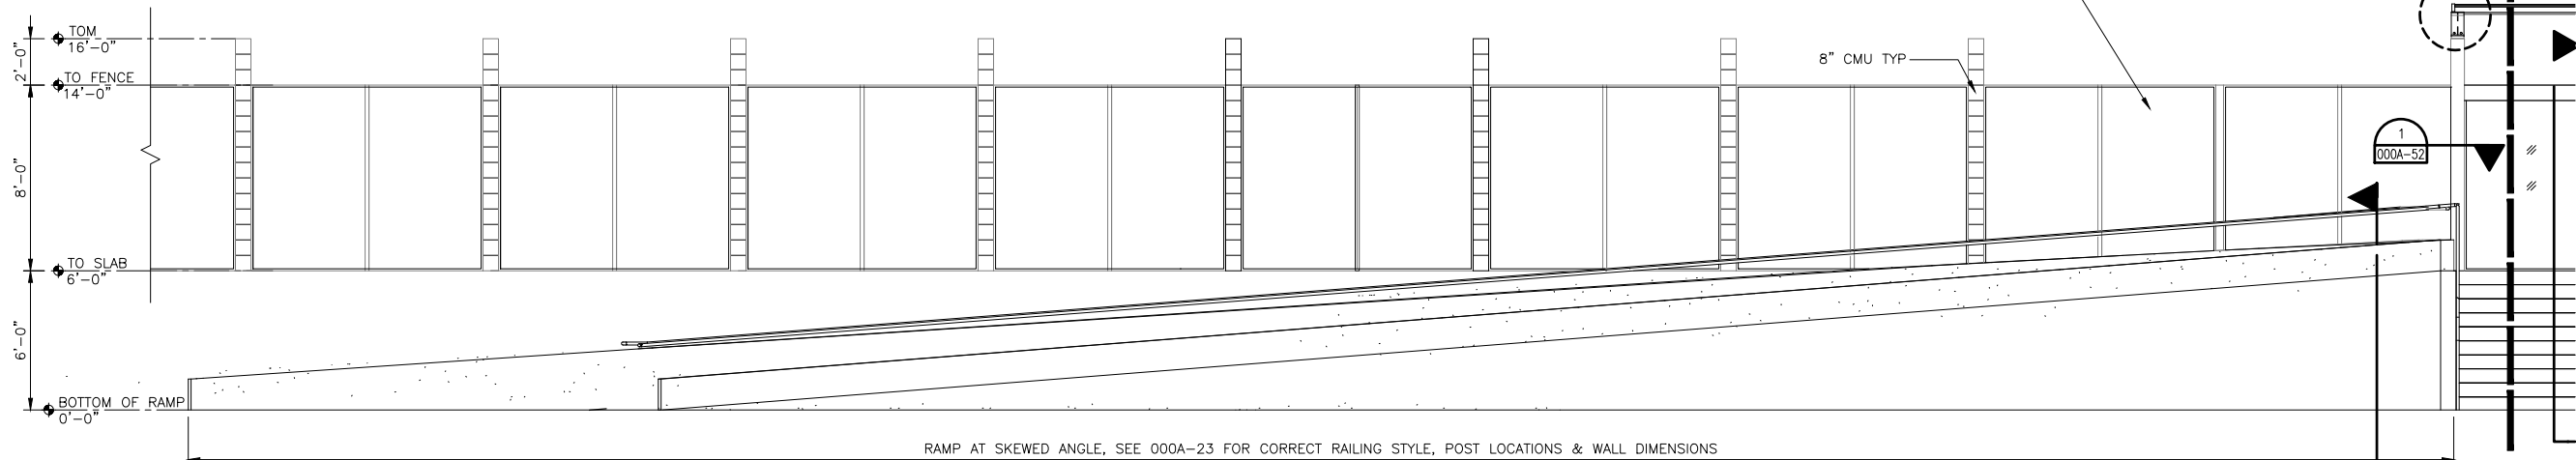

WEST ELEVATION @ VIEW AREA 2
SCALE: 1/4" = 1'-0"

000A-04

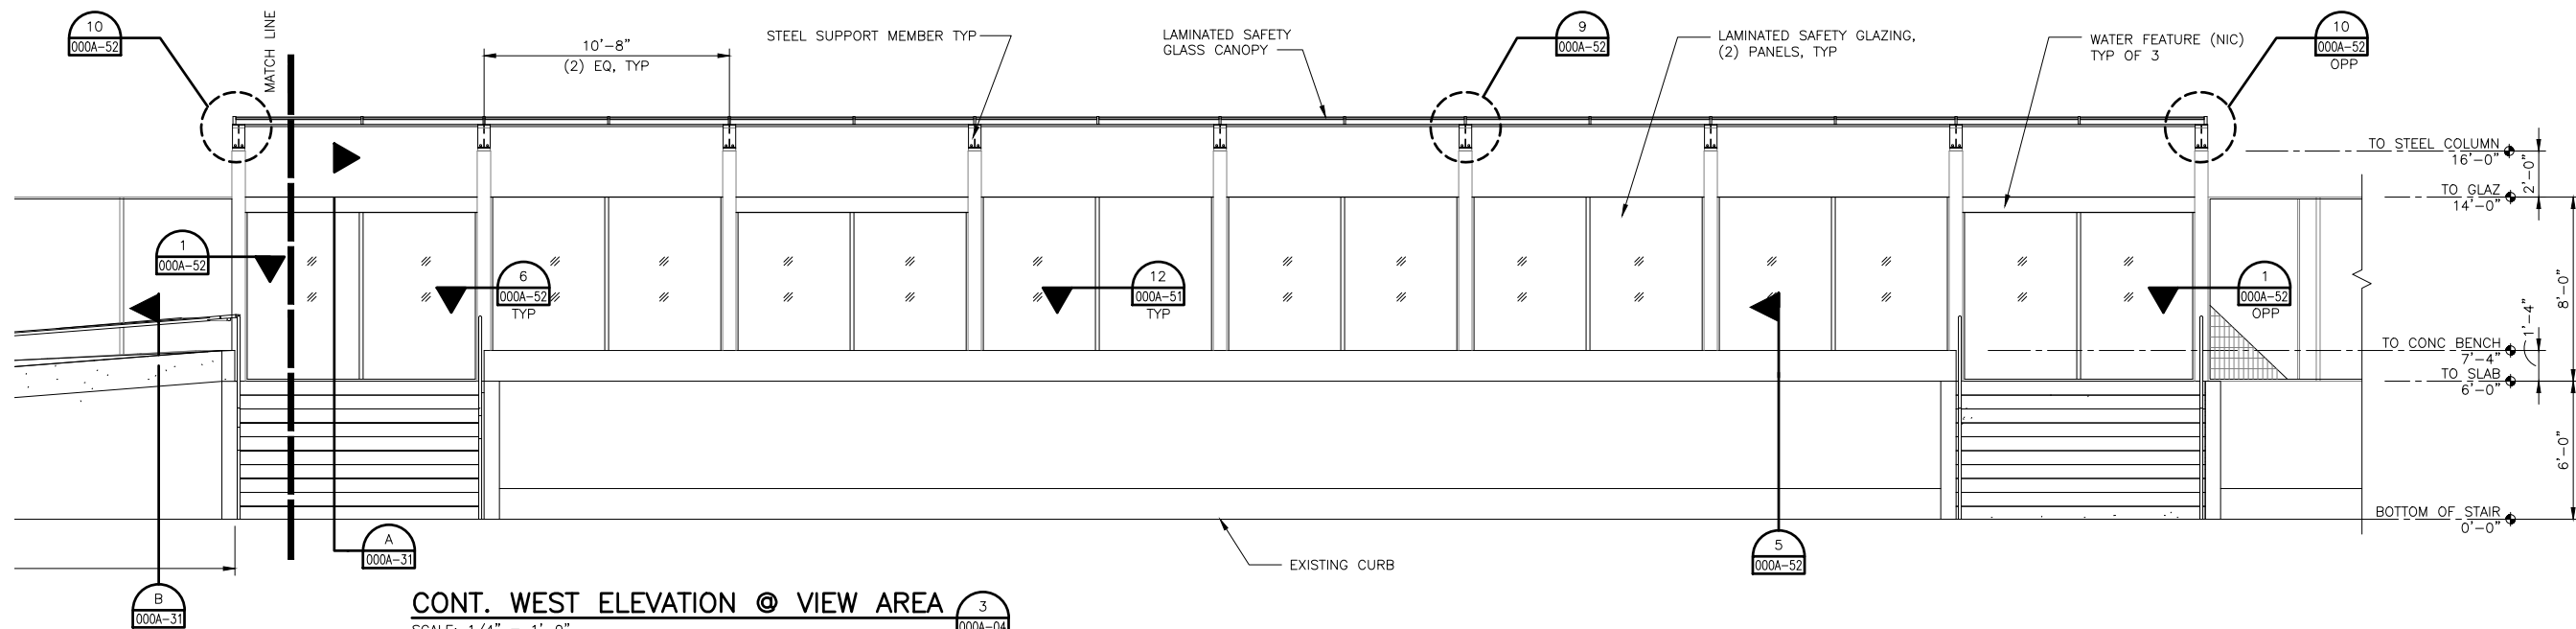

CONT. WEST ELEVATION @ VIEW AREA 3
SCALE: 1/4" = 1'-0"

000A-04




| ISSUE | DATE | DESCRIPTION |
|-------|----------|----------------------------------|
| 1 | APR 2014 | RECORD DRAWINGS |
| 0 | NOV 2011 | ISSUE FOR CONSTRUCTION SUBMITTAL |

| | |
|-----------------|-------------|
| PROJECT MANAGER | A. MEILLEUR |
| DESIGNED | D. HOGAN |
| DRAWN | J. ZHAO |
| CHECKED | |
| PROJECT NUMBER | 171097 |

ELECTRONIC SEAL AND
SIGNATURE HAS BEEN
REMOVED. THIS MEDIA
SHOULD NOT BE CONSIDERED
A CERTIFIED DOCUMENT




**SITE
VIEW AREA ELEVATIONS 1**

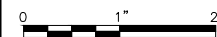


| | |
|----------|--------------|
| FILENAME | 000A-21.dwg |
| SCALE | 1/4" = 1'-0" |

SHEET
000A-21


ELECTRONIC MEDIA DISCLAIMER: THIS ELECTRONIC MEDIA PROVIDED BY HDR ENGINEERING, INC. IS SUBJECT TO AN ELECTRONIC MEDIA RELEASE. ALL USE AND RE-USE OF THIS MEDIA IS SUBJECT TO THE TERMS AND CONDITIONS OF THE RELEASE.

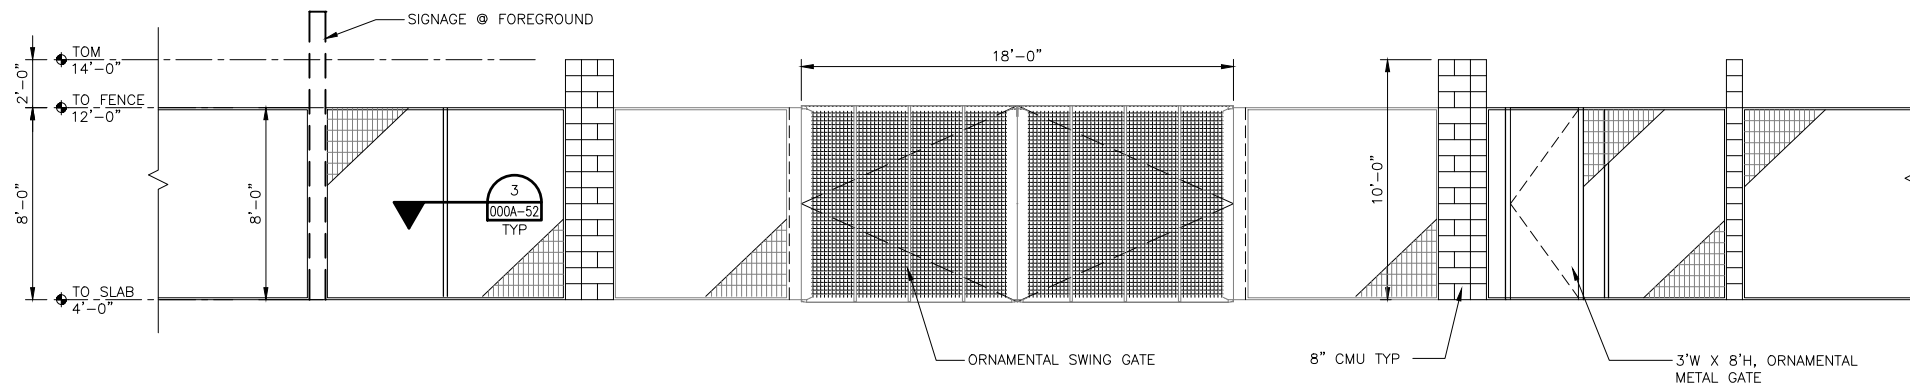


WEST ELEVATION @ MAIN ENTRY GATE 1
Scale: 1/4" = 1'-0"

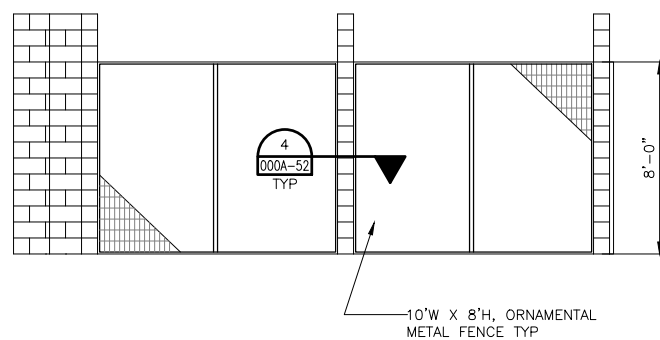


NORTH ELEVATION 2
Scale: 1/4" = 1'-0"

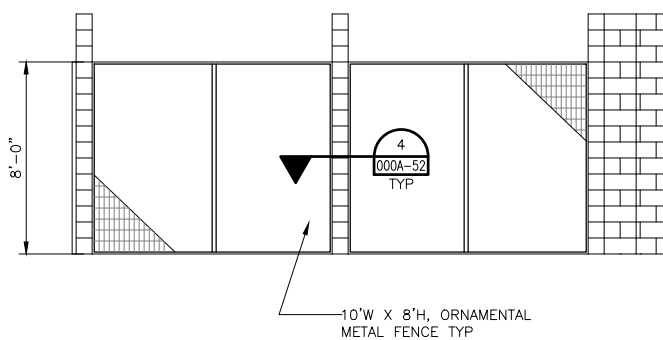

SOUTH ELEVATION 3
Scale: 1/4" = 1'-0"

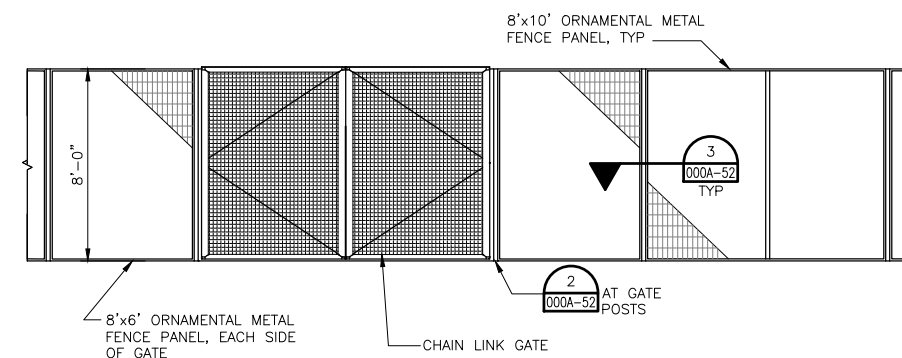

SOUTH ELEVATION 4
Scale: 1/4" = 1'-0"

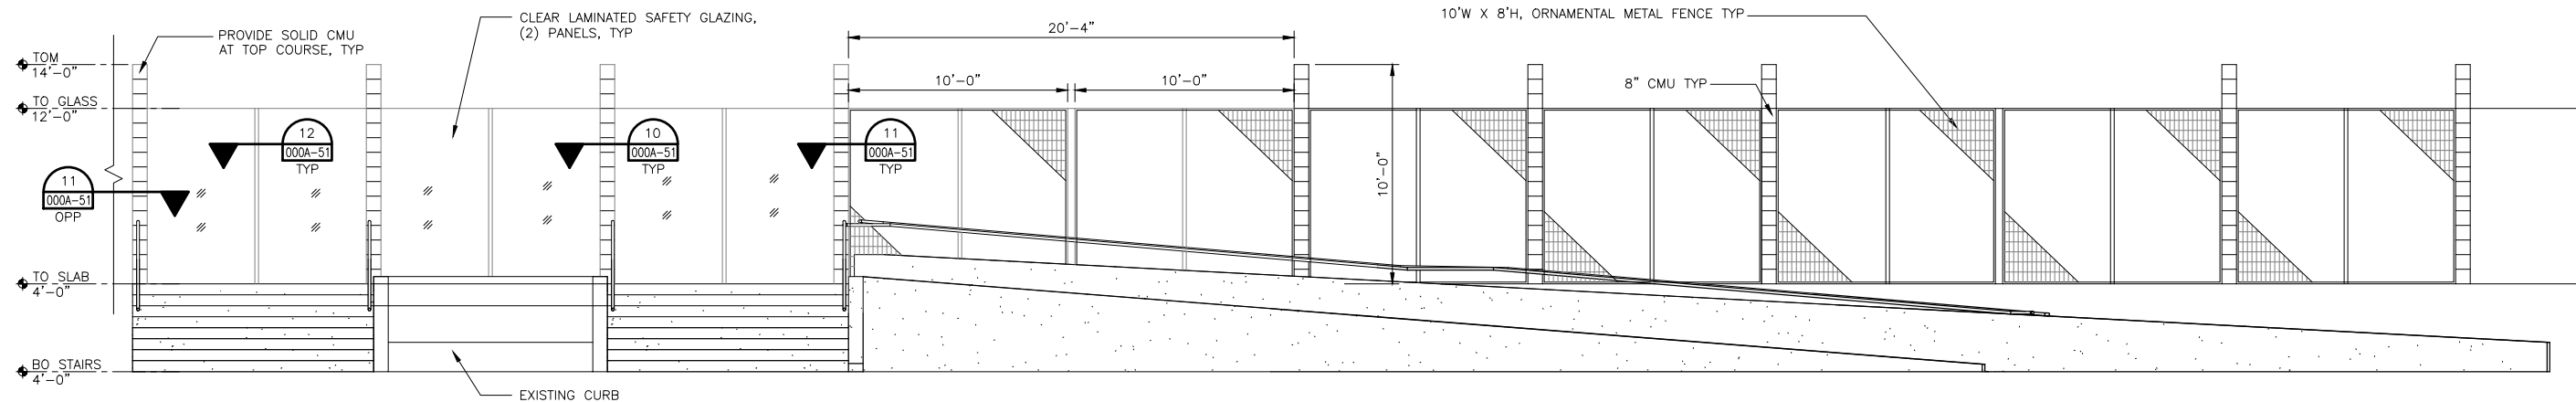

WEST ELEVATION @ MAIN ENTRY GATE 5
Scale: 1/4" = 1'-0"



| ISSUE | DATE | DESCRIPTION |
|-------|----------|----------------------------------|
| 1 | APR 2014 | RECORD DRAWINGS |
| 0 | NOV 2011 | ISSUE FOR CONSTRUCTION SUBMITTAL |

| | |
|-----------------|-------------|
| PROJECT MANAGER | A. MEILLEUR |
| DESIGNED | D. HOGAN |
| DRAWN | J. ZHAO |
| CHECKED | |
| PROJECT NUMBER | 171097 |

ELECTRONIC SEAL AND
SIGNATURE HAS BEEN
REMOVED. THIS MEDIA
SHOULD NOT BE CONSIDERED
A CERTIFIED DOCUMENT




**SITE
VIEW AREA ELEVATIONS 2**




FILENAME 000A-22.dwg
SCALE 1/4" = 1'-0"

SHEET
000A-22


ELECTRONIC MEDIA DISCLAIMER: THIS ELECTRONIC MEDIA PROVIDED BY HDR ENGINEERING, INC. IS SUBJECT TO AN ELECTRONIC MEDIA RELEASE. ALL USE AND RE-USE OF THIS MEDIA IS SUBJECT TO THE TERMS AND CONDITIONS OF THE RELEASE.

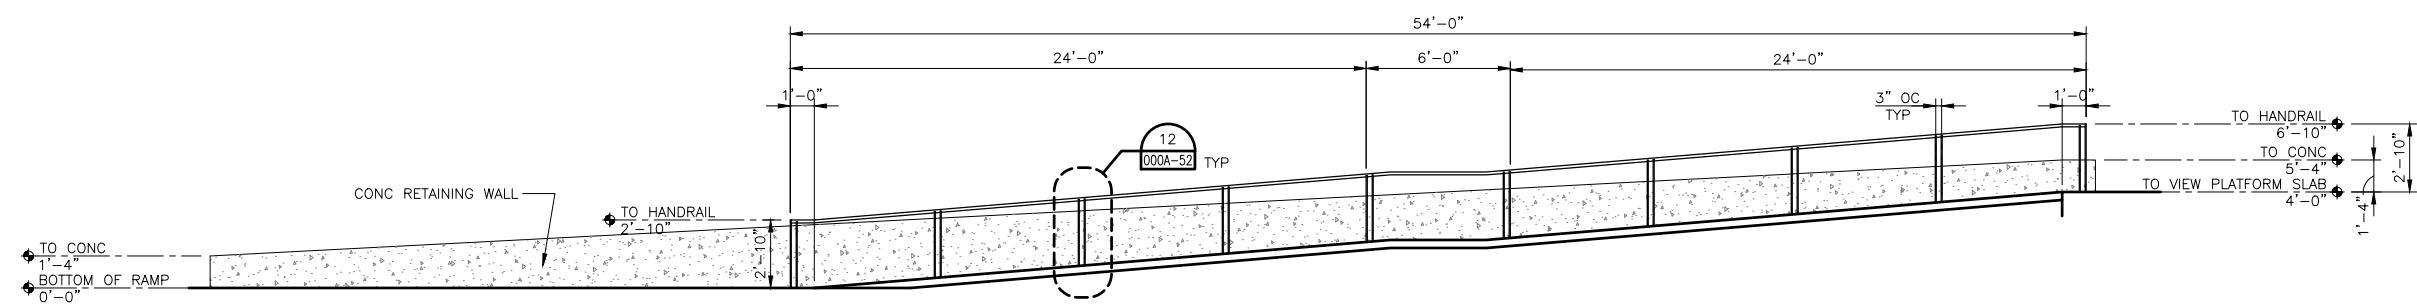

RAMP SECTION
SCALE: 1/4"=1'-0"

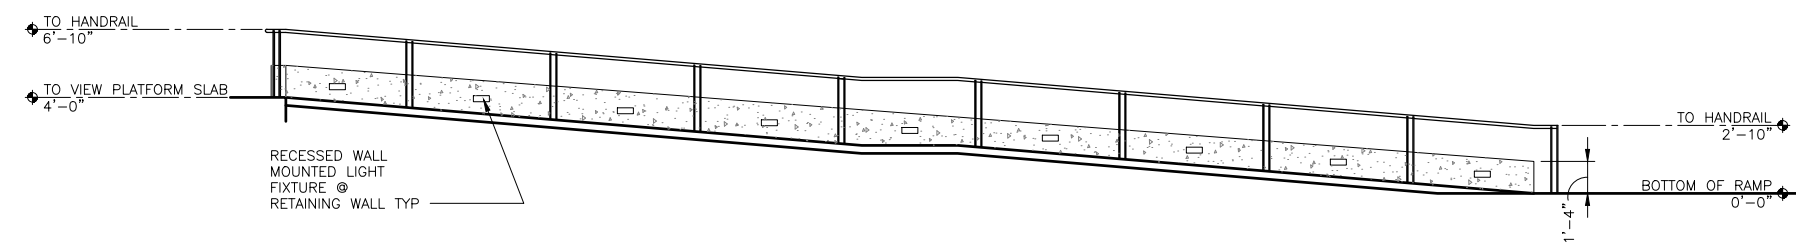

RAMP SECTION
SCALE: 1/4"=1'-0"

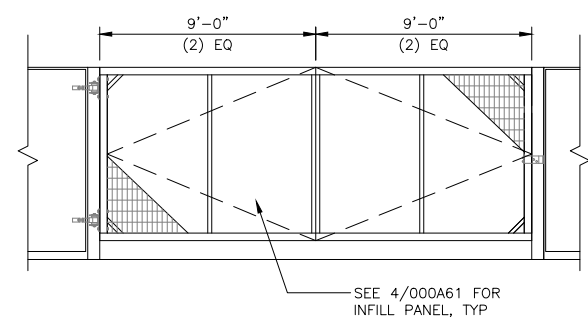

SWING GATE ELEVATION
SCALE: 1/4" = 1'-0"



| | | |
|-------|----------|----------------------------------|
| | | |
| | | |
| | | |
| | | |
| 1 | APR 2014 | RECORD DRAWINGS |
| 0 | NOV 2011 | ISSUE FOR CONSTRUCTION SUBMITTAL |
| ISSUE | DATE | DESCRIPTION |

| | |
|-----------------|-------------|
| PROJECT MANAGER | A. MEILLEUR |
| DESIGNED | D. HOGAN |
| DRAWN | J. ZHAO |
| CHECKED | |
| PROJECT NUMBER | 171097 |

ELECTRONIC SEAL AND
SIGNATURE HAS BEEN
REMOVED. THIS MEDIA
SHOULD NOT BE CONSIDERED
A CERTIFIED DOCUMENT




**SITE
RAMP SECTIONS & GATE ELEVATIONS**

0 1" 2"

FILENAME 000A-23.dwg
SCALE 1/4" = 1'-0"

SHEET
000A-23


ELECTRONIC MEDIA DISCLAIMER: THIS ELECTRONIC MEDIA PROVIDED BY HDR ENGINEERING, INC. IS SUBJECT TO AN ELECTRONIC MEDIA RELEASE. ALL USE AND RE-USE OF THIS MEDIA IS SUBJECT TO THE TERMS AND CONDITIONS OF THE RELEASE.

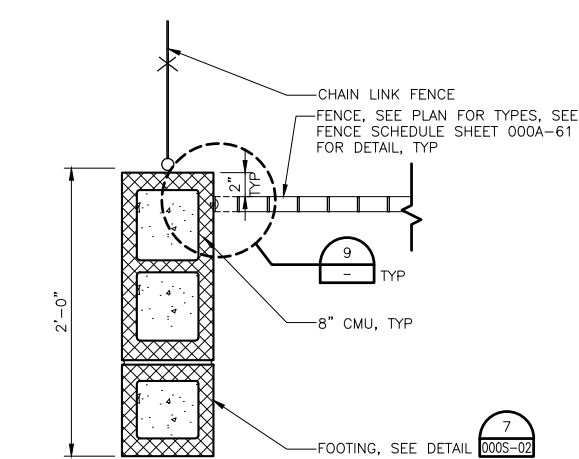

PLAN DETAIL

SCALE: 1-1/2"=1'-0"


1
000A-01

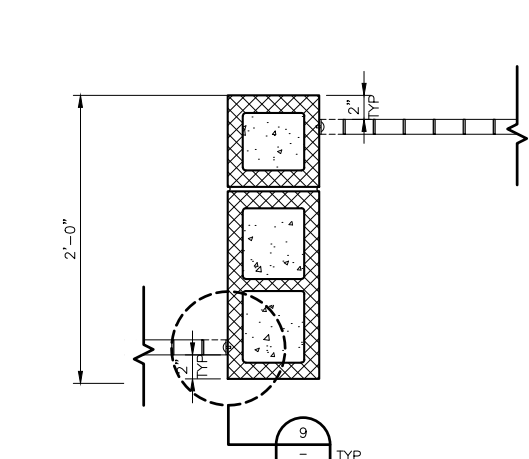

PLAN DETAIL

SCALE: 1-1/2"=1'-0"


2
000A-03

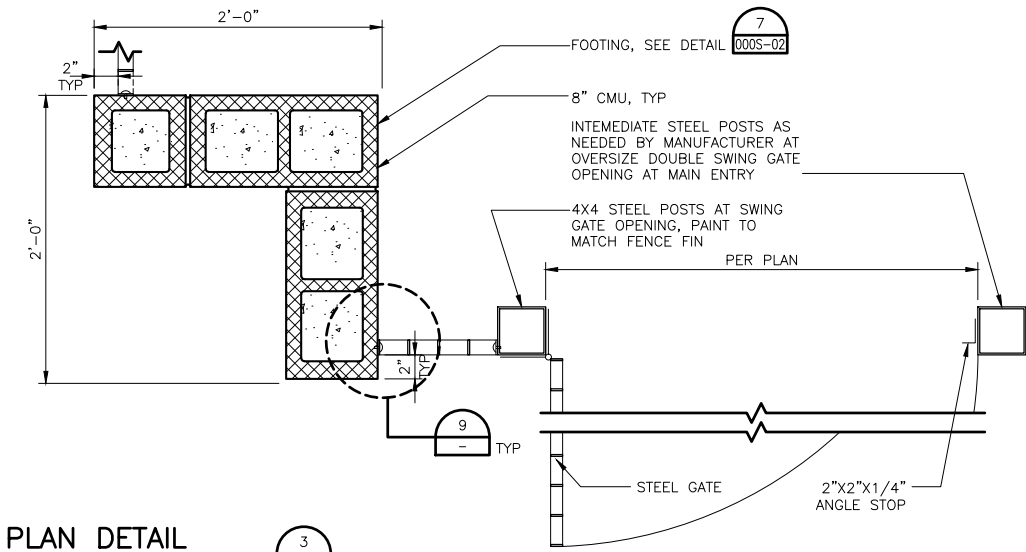

PLAN DETAIL

SCALE: 1-1/2"=1'-0"


3
000A-03

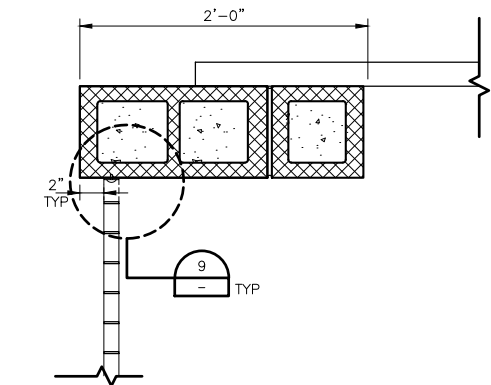

PLAN DETAIL

SCALE: 1-1/2"=1'-0"


5
000A-03

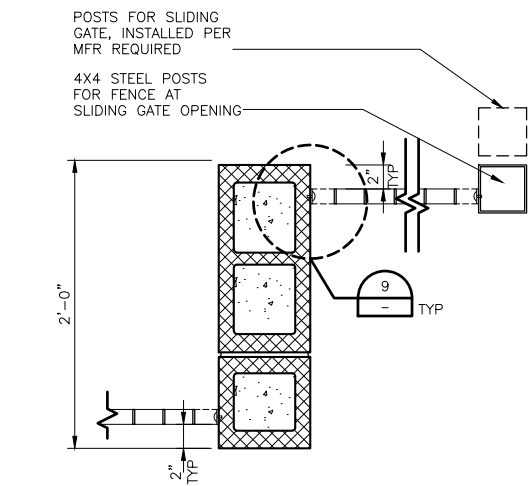

PLAN DETAIL

SCALE: 1-1/2"=1'-0"


6
000A-03

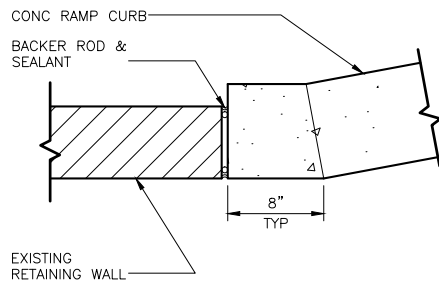

CURB DETAIL

SCALE: 1-1/2"=1'-0"


7
000A-02

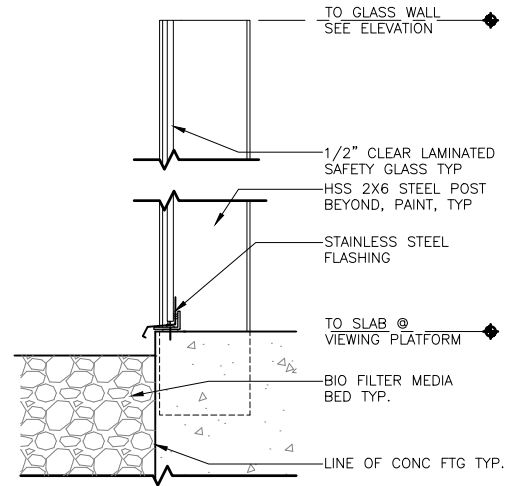

GLASS WALL DETAIL

SCALE: 1-1/2"=1'-0"


8
000A-04

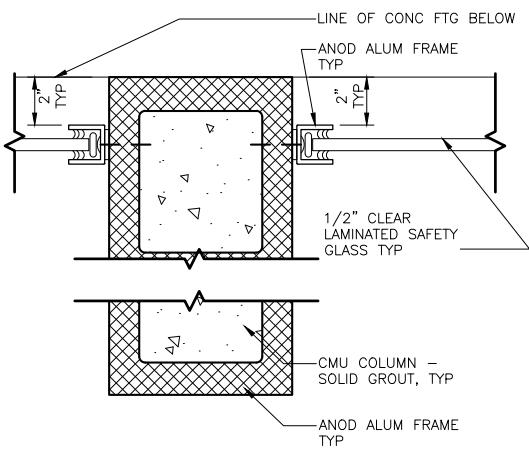

CMU COLUMN/GLASS

SCALE: 3"=1'-0"


10
000A-03

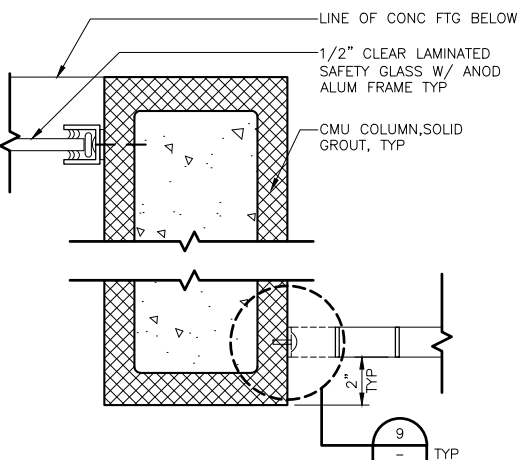

CMU COLUMN/FENCE

SCALE: 3"=1'-0"


11
000A-03

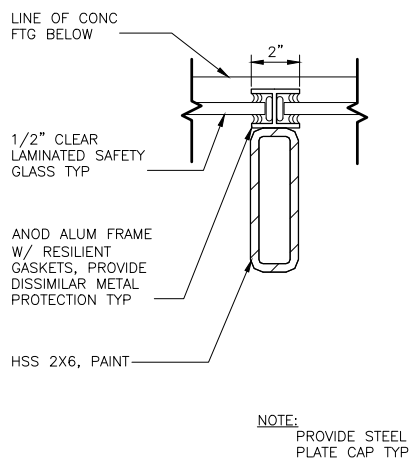

TYP POST/GLASS @ MIDPT

SCALE: 3"=1'-0"


12
000A-03

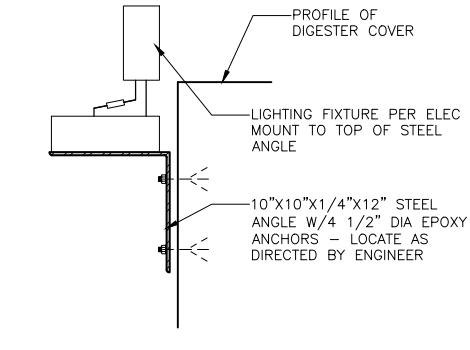

DIGESTER LIGHT FIXTURE BASE DETAIL

SCALE: 1-1/2"=1'-0"


13
000A-XX

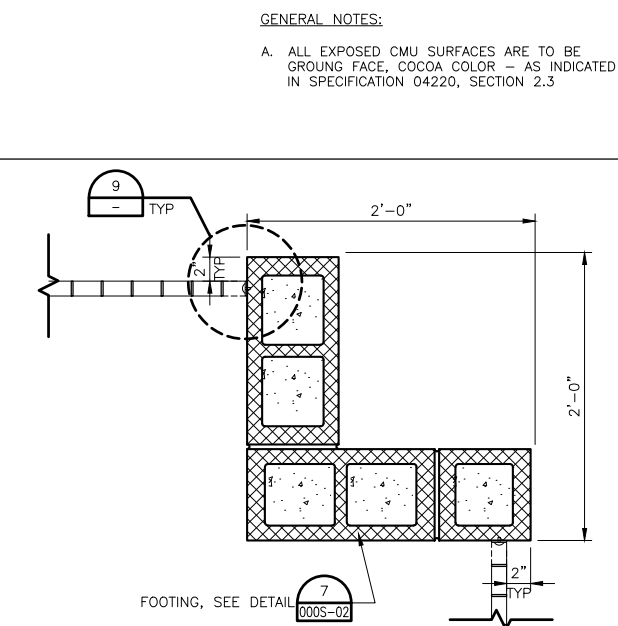

PLAN DETAIL

SCALE: 1-1/2"=1'-0"


4
000A-01

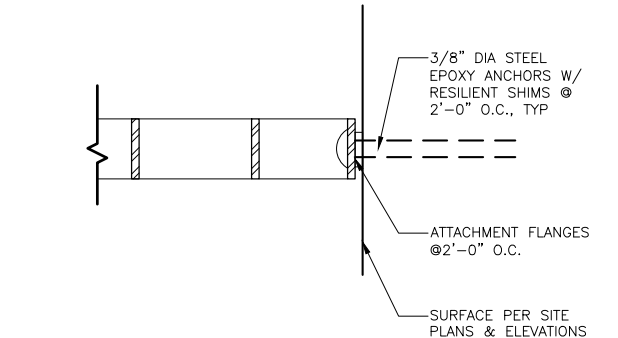

SCREEN DETAIL

SCALE: 6"=1'-0"

9
000A-31

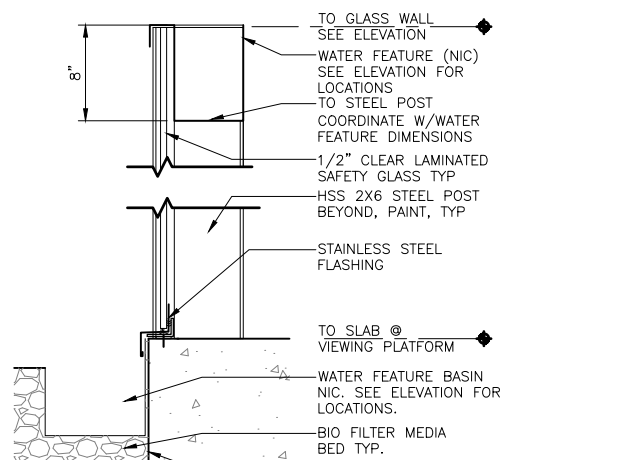

GLASS WALL DETAIL

SCALE: 1-1/2"=1'-0"

14
000A-04




| ISSUE | DATE | DESCRIPTION |
|-------|----------|----------------------------------|
| 1 | APR 2014 | RECORD DRAWINGS |
| 0 | NOV 2011 | ISSUE FOR CONSTRUCTION SUBMITTAL |

| | |
|-----------------|-------------|
| PROJECT MANAGER | A. MEILLEUR |
| DESIGNED | D. HOGAN |
| DRAWN | J. ZHAO |
| CHECKED | |
| PROJECT NUMBER | 171097 |

ELECTRONIC SEAL AND
SIGNATURE HAS BEEN
REMOVED. THIS MEDIA
SHOULD NOT BE CONSIDERED
A CERTIFIED DOCUMENT




SITE
ARCHITECTURAL DETAILS 1

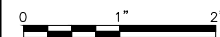

| | |
|----------|-------------|
| FILENAME | 000A-51.dwg |
| SCALE | AS NOTED |

| | |
|-------|---------|
| SHEET | 000A-51 |
|-------|---------|


ELECTRONIC MEDIA DISCLAIMER: THIS ELECTRONIC MEDIA PROVIDED BY HDR ENGINEERING, INC. IS SUBJECT TO AN ELECTRONIC MEDIA RELEASE. ALL USE AND RE-USE OF THIS MEDIA IS SUBJECT TO THE TERMS AND CONDITIONS OF THE RELEASE.

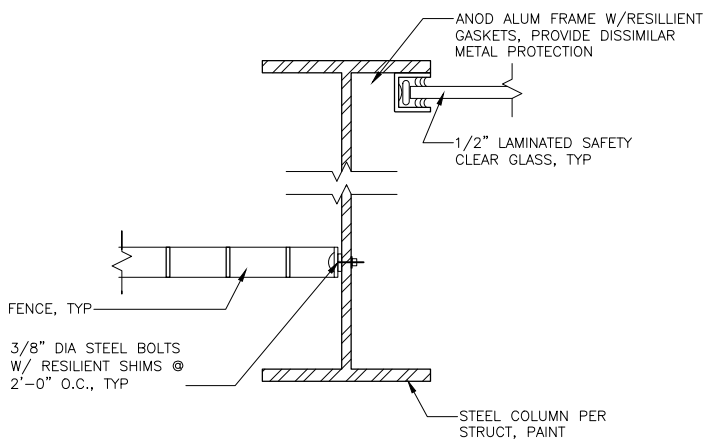

CANOPY COLUMN/FENCE

SCALE: 3"=1'-0"

1
000A-04

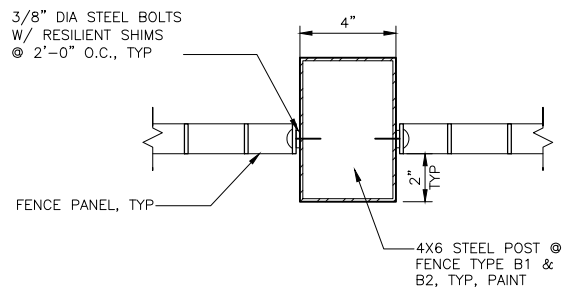


FENCE POST DETAIL

SCALE: 3"=1'-0"

2
000A-61

NOTE: PROVIDE STEEL
PL CAP, TYP

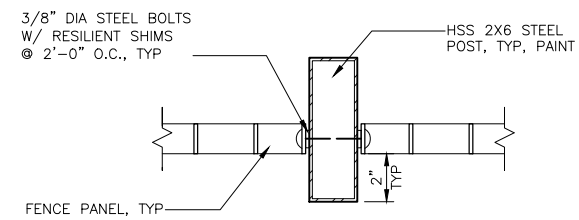


FENCE POST DETAIL

SCALE: 3"=1'-0"

3
000A-61


NOTE: PROVIDE STEEL
PL CAP, TYP

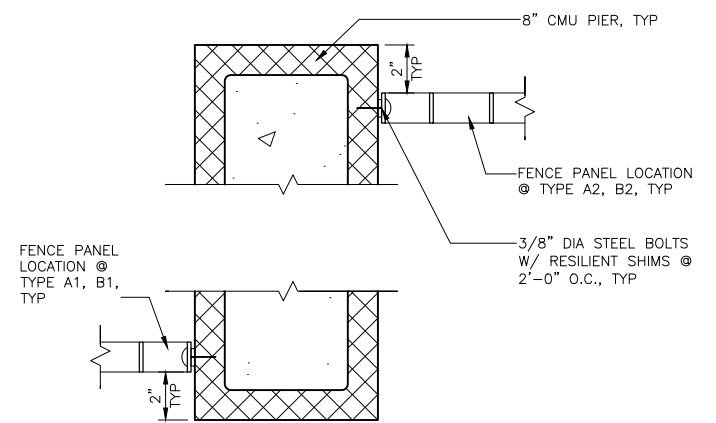

CMU FENCE DETAIL

SCALE: 3"=1'-0"


4
000A-03

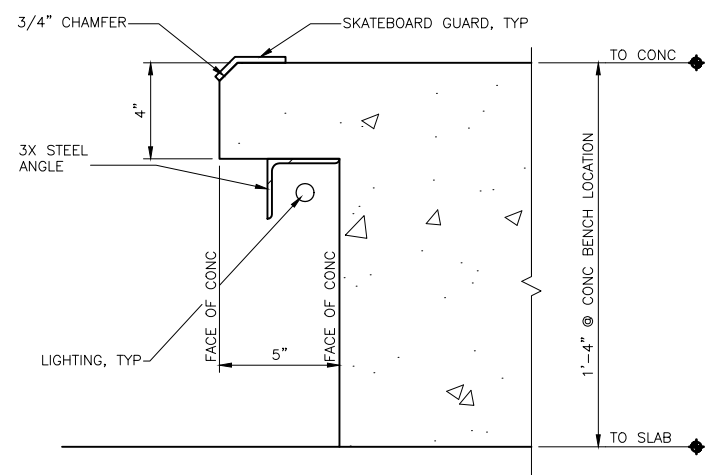

CONC BENCH DETAIL

SCALE: 3"=1'-0"


5
000A-04

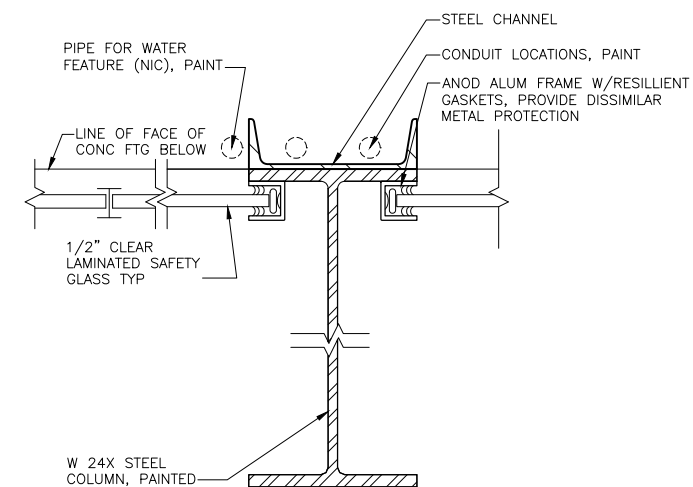

TYP CANOPY COLUMN DETAIL

SCALE: 3"=1'-0"


6
000A-04

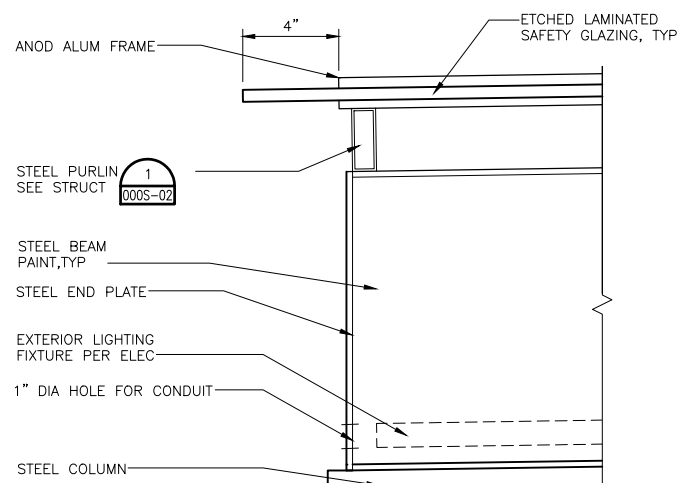

CANOPY EDGE DETAIL

SCALE: 3"=1'-0"


7
000A-05

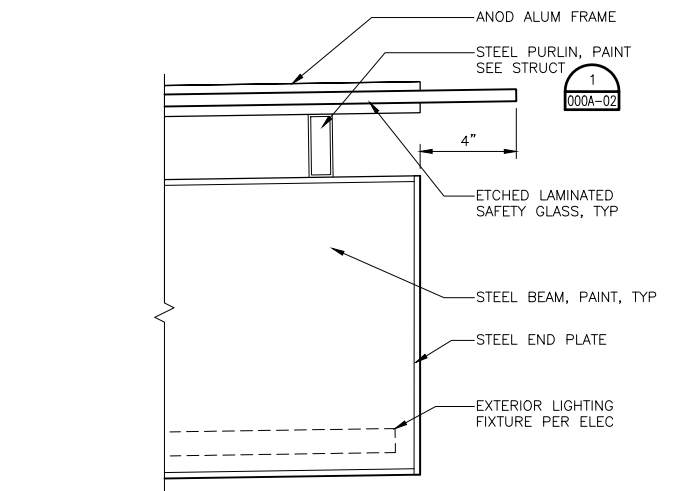

CANOPY EDGE DETAIL

SCALE: 3"=1'-0"


8
000A-05

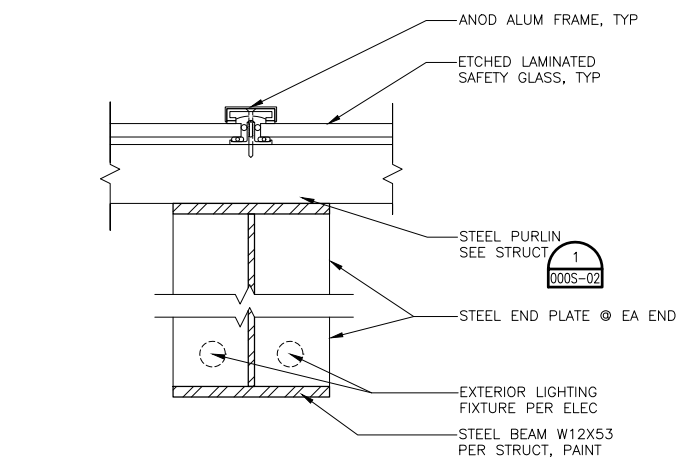

CANOPY BEAM DETAIL

SCALE: 3"=1'-0"


9
000A-05

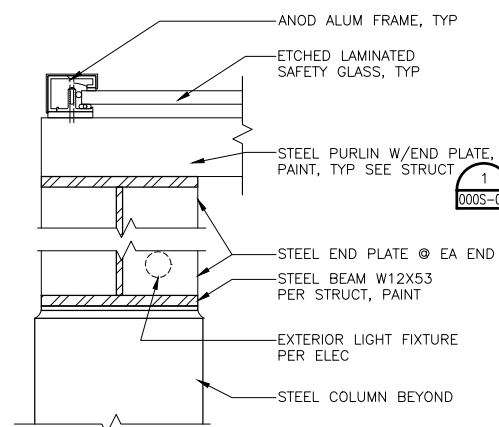

CANOPY DETAIL

SCALE: 3"=1'-0"


10
000A-05

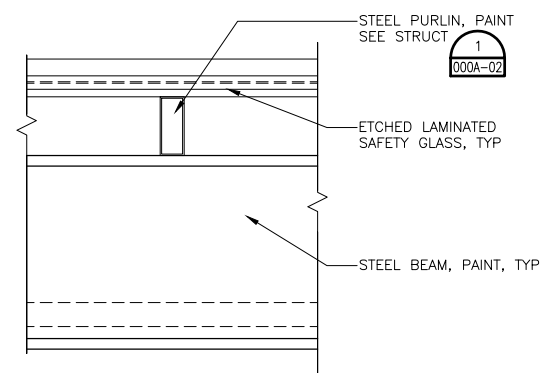

CANOPY PURLIN DETAIL

SCALE: 3"=1'-0"

11
000A-05

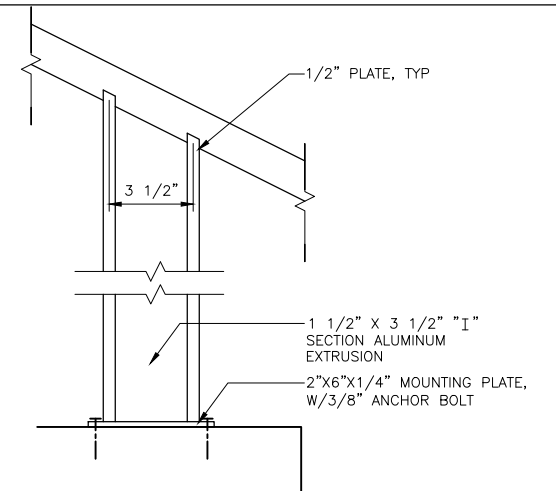

RAILING DETAIL

SCALE: 3"=1'-0"

12
000A-31



| ISSUE | DATE | DESCRIPTION |
|-------|----------|----------------------------------|
| 1 | APR 2014 | RECORD DRAWINGS |
| 0 | NOV 2011 | ISSUE FOR CONSTRUCTION SUBMITTAL |

| | |
|-----------------|-------------|
| PROJECT MANAGER | A. MEILLEUR |
| DESIGNED | D. HOGAN |
| DRAWN | J. ZHAO |
| CHECKED | |
| PROJECT NUMBER | 171097 |

ELECTRONIC SEAL AND
SIGNATURE HAS BEEN
REMOVED. THIS MEDIA
SHOULD NOT BE CONSIDERED
A CERTIFIED DOCUMENT




**SITE
ARCHITECTURAL DETAILS 2**




| | |
|----------|-------------|
| FILENAME | 000A-52.dwg |
| SCALE | 3"=1'-0" |

SHEET
000A-52

ELECTRONIC MEDIA DISCLAIMER: THIS ELECTRONIC MEDIA PROVIDED BY HDR ENGINEERING, INC. IS SUBJECT TO AN ELECTRONIC MEDIA RELEASE. ALL USE AND RE-USE OF THIS MEDIA IS SUBJECT TO THE TERMS AND CONDITIONS OF THE RELEASE.

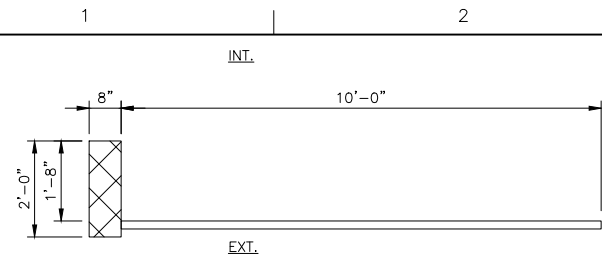


TYPE A1

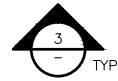


TYPE A FENCE PLAN

SCALE: 1/2"=1'-0"

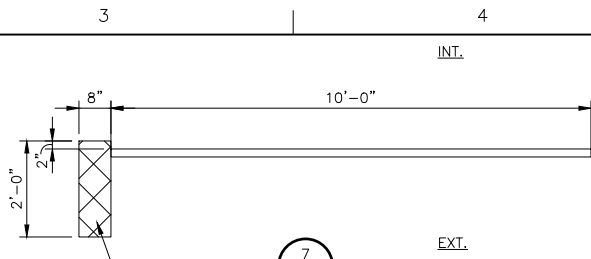

TYPE A2


SEE STRUCT DETAIL 000S-02 FOR CMU & FOOTING

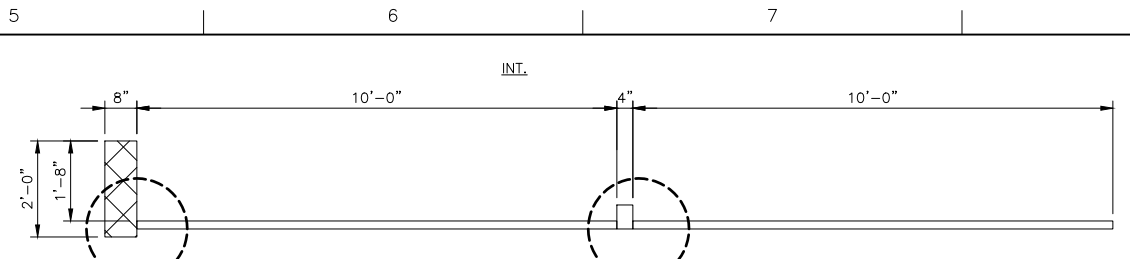

TYPE B1

SEE STRUCT DETAIL 000A-52 TYP


SEE STRUCT DETAIL 000A-52 TYP

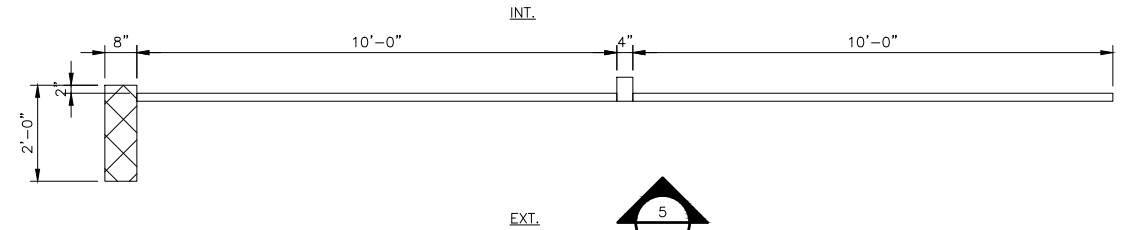

TYPE B2


TYPE B FENCE PLAN

SCALE: 1/2"=1'-0"

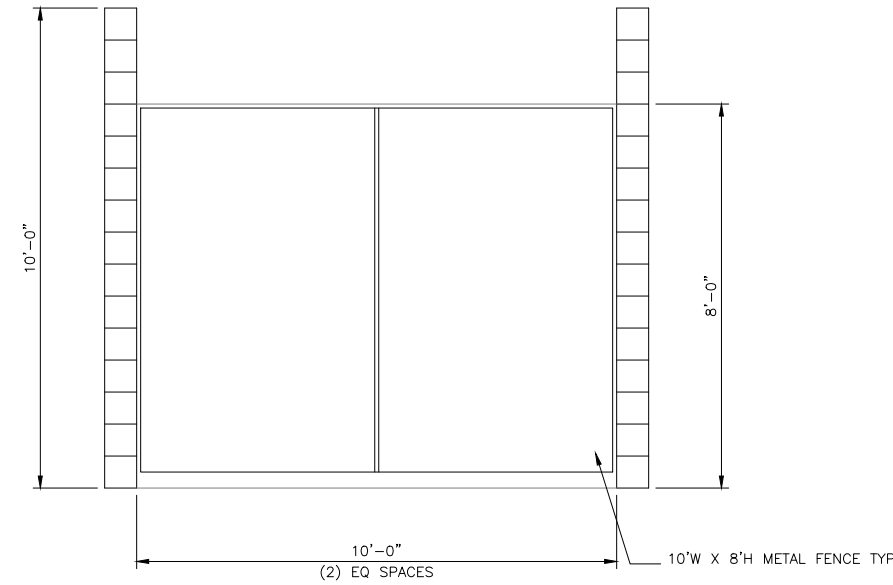


TYPE A FENCE ELEVATION

SCALE: 1/2"=1'-0"

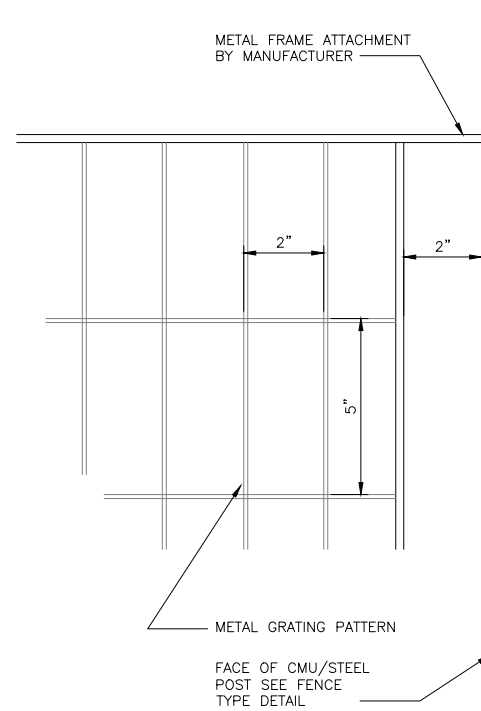

FENCE INFILL PANEL PATTERN

SCALE: 1/2"=1'-0"

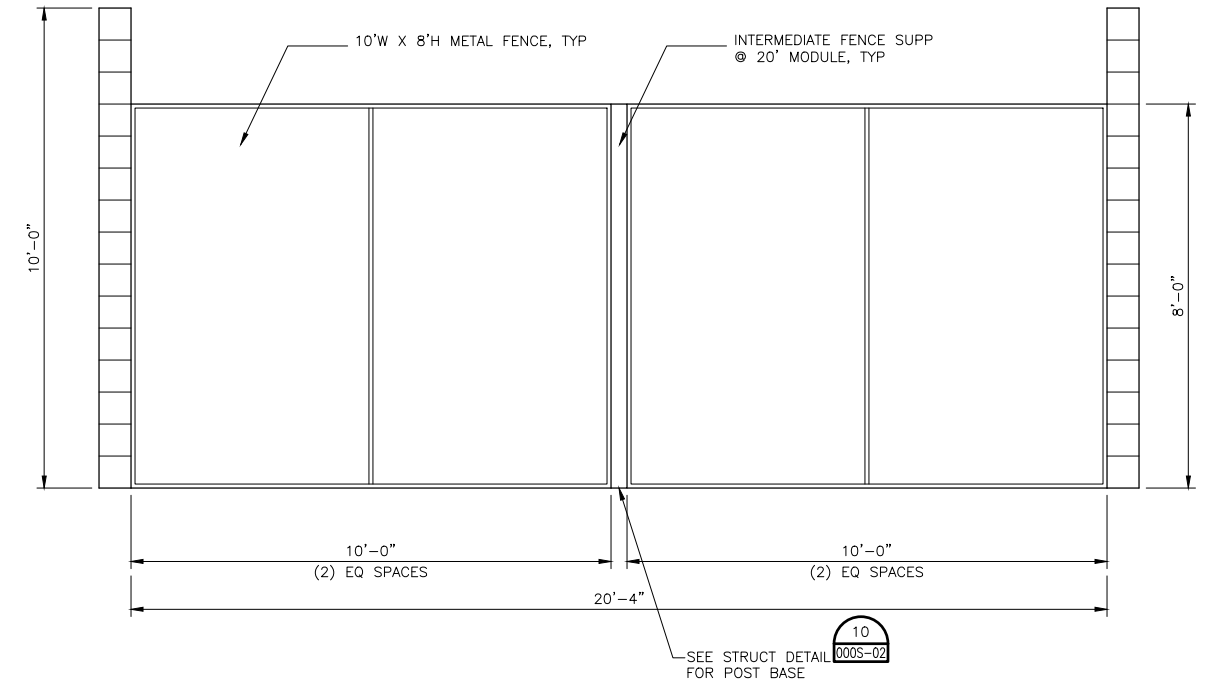

TYPE B FENCE ELEVATION

SCALE: 1/2"=1'-0"



| | | |
|-------|----------|----------------------------------|
| | | |
| | | |
| | | |
| | | |
| 1 | APR 2014 | RECORD DRAWINGS |
| 0 | NOV 2011 | ISSUE FOR CONSTRUCTION SUBMITTAL |
| ISSUE | DATE | DESCRIPTION |

| | |
|-----------------|-------------|
| PROJECT MANAGER | A. MEILLEUR |
| DESIGNED | D. HOGAN |
| DRAWN | J. ZHAO |
| CHECKED | |
| PROJECT NUMBER | 171097 |

ELECTRONIC SEAL AND
SIGNATURE HAS BEEN
REMOVED. THIS MEDIA
SHOULD NOT BE CONSIDERED
A CERTIFIED DOCUMENT




SITE
ARCHITECTURAL FENCING TYPES



| | |
|----------|--------------|
| FILENAME | 000A-61.dwg |
| SCALE | 1/2" = 1'-0" |

SHEET
000A-61

ELECTRONIC MEDIA DISCLAIMER: THIS ELECTRONIC MEDIA PROVIDED BY HDR ENGINEERING, INC. IS SUBJECT TO AN ELECTRONIC MEDIA RELEASE. ALL USE AND RE-USE OF THIS MEDIA IS SUBJECT TO THE TERMS AND CONDITIONS OF THE RELEASE.

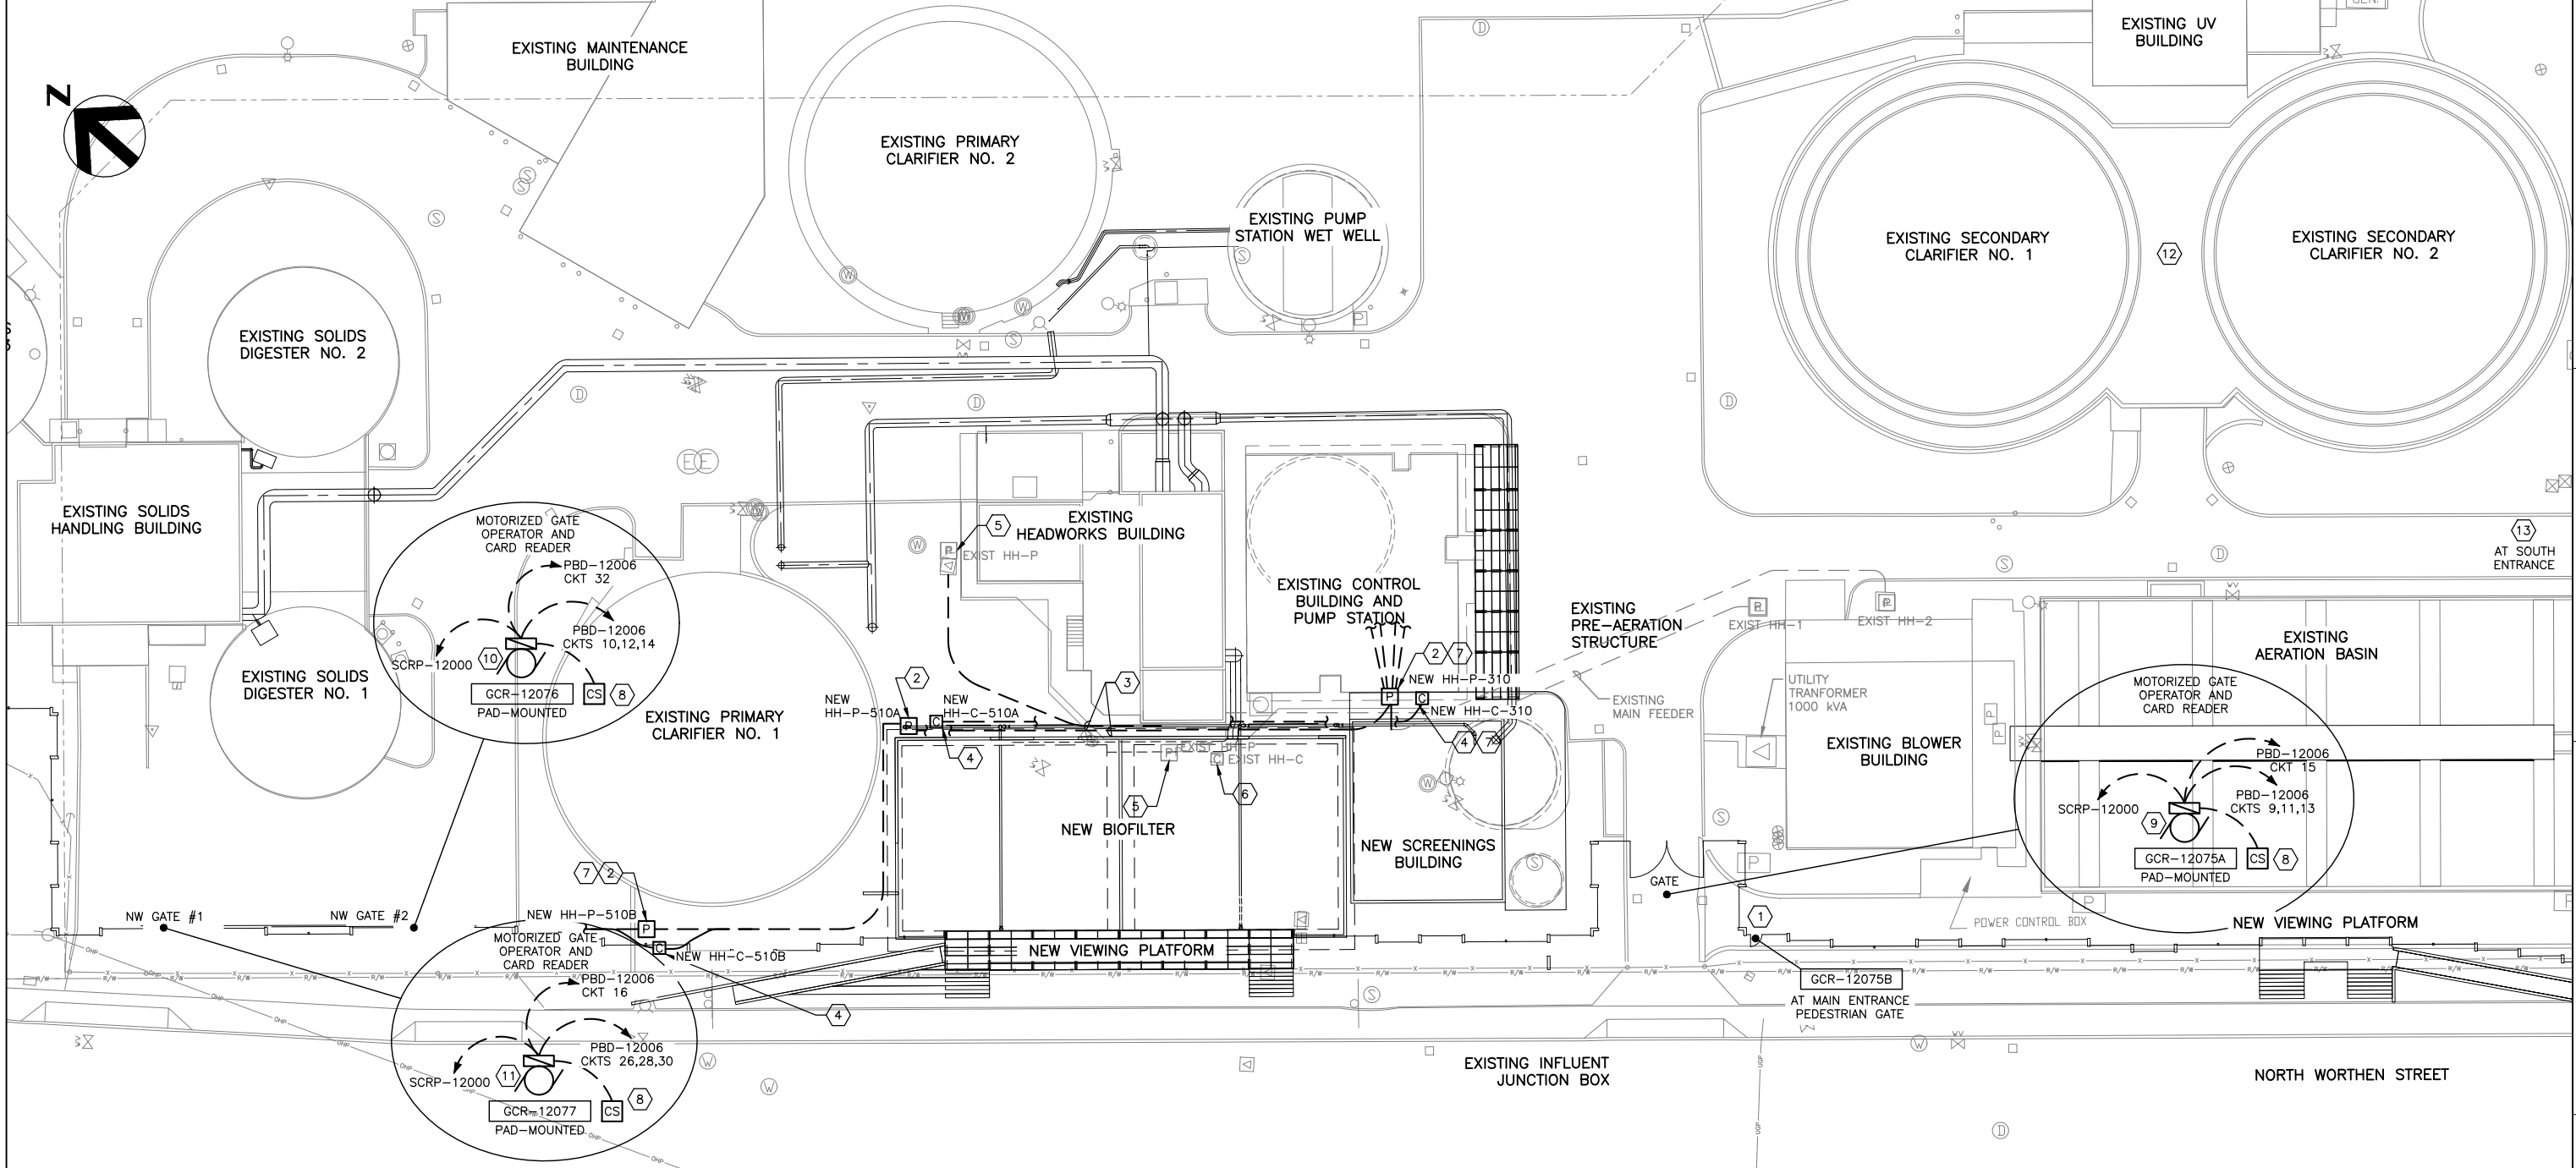

ELECTRICAL SITE PLAN
1" = 20'

KEY NOTES:

- 1 MAIN ENTRANCE PEDESTRIAN GATE ELECTRICALLY OPERATED WITH CARD READER GCR-12075B.

2 PROVIDE NEW ELECTRICAL HANDHOLE 444 WITH DRAIN AS PER DETAIL 12 ON SHEET 00E-11.

3 NEW UNDERGROUND ELECTRICAL SHALL BE PER DETAIL 11 ON SHEET 00E-11.

4 PROVIDE NEW 17"W x 20"L x 12"D ELECTRICAL HANDHOLE FOR COMMUNICATION AND DC SIGNALS, WITH TRAFFIC RATED TOP.

5 EXISTING ELECTRICAL HANDHOLE TO BE DECOMMISSIONED AND REMOVED. PULL CONDUCTORS FROM CONDUITS TO BE ABANDONED DUE TO BIOFILTER BEDS CONSTRUCTION.
- 6 EXISTING UTILITY 17"W x 20"L x 12"D CONCRETE JUNCTION BOX TO BE DECOMMISSIONED AND REMOVED. PULL CONDUCTORS FROM CONDUITS TO BE ABANDONED DUE TO BIOFILTER BED CONSTRUCTION.

7 CONTRACTOR TO FIELD VERIFY LOCATION TO INTERCEPT AND CONNECT TO EXISTING UNDERGROUND ELECTRICAL. CONTRACTOR SHALL PROVIDE CONTINUOUS LENGTH WIRING AND CONNECT ENDS.

8 PROVIDE PAD-MOUNTED GATE CARD READER AND DOOR CONTROLLER TO MEET MOTORIZED GATE REQUIREMENTS. COORDINATE LOCATION OF CARD READER WITH OWNER. MOUNT READER TO ALLOW READING CARDS FROM A TRUCK AND ALLOW FULL MOTORIZED GATE OPERATION.

- 9 FURNISH AND INSTALL MOTORIZED GATE OPERATOR. PROVIDE ALL NECESSARY INTERFACE, INCLUDING INTERPOSING RELAYS, TO OPERATE GATE FROM GRC-12075.

10 FURNISH AND INSTALL MOTORIZED GATE OPERATOR. PROVIDE ALL NECESSARY INTERFACE, INCLUDING INTERPOSING RELAYS, TO OPERATE GATE FROM GCR-12076.

11 FURNISH AND INSTALL MOTORIZED GATE OPERATOR. PROVIDE ALL NECESSARY INTERFACE, INCLUDING INTERPOSING RELAYS, TO OPERATE GATE FROM GCR-12077.

12 NON-POTABLE WATER PUMPS NO. 1 AND NO. 2 TO BE REPLACED, REFER TO DETAIL 14, SHEET 000E-11. PROVIDE VARIABLE FREQUENCY DRIVE FOR EACH PUMP. MCC 2E (ESSENTIAL LOADS) TO BE MODIFIED, REFER TO ELECTRICAL SHEETS. RE-USE CONDUITS FROM THIS MCC TO RAS PUMP ROOM.
- 13 SOUTH ENTRANCE PEDESTRIAN GATE ELECTRICALLY OPERATED WITH CARD READER GCR-12078.

GENERAL NOTES:


- FOR EXISTING CONDITIONS, TO BE FIELD VERIFIED, REFER TO RECORD DRAWINGS:
 - 2006 DWG ELC-2006 "ELECTRICAL SITE PLAN".
 - 1992 AS-BUILT DWG E-2 "ELECTRICAL SITE PLAN".
 - 1973 DWG C7039-I SHEET 69 "ELECTRICAL SITE PLAN".
- CONTRACTOR TO VERIFY THE LOCATION, RELOCATION, ABANDONMENT AND/OR TEMPORARY SUPPORT OF ALL ELECTRICAL, UNDERGROUND AND ABOVE GROUND, AFFECTED BY CONSTRUCTION. CONTRACTOR SHALL COORDINATE WITH OWNER ALL ELECTRICAL WORK TO GUARANTEE WASTEWATER TREATMENT PLANT CONTINUOUS OPERATION.
- COORDINATE WITH CHELAN PUD ALL CONSTRUCTION WORK AFFECTING EXISTING ELECTRIC SERVICE ENTRANCE CONDUCTORS.
- COORDINATE WITH QWEST ALL CONSTRUCTION WORK AFFECTING EXISTING TELEPHONE SERVICE AND/OR NEW REQUIREMENTS.



| | | |
|-------|----------|----------------------------------|
| | | |
| | | |
| | | |
| | | |
| 1 | APR 2014 | RECORD DRAWINGS |
| 0 | NOV 2011 | ISSUE FOR CONSTRUCTION SUBMITTAL |
| ISSUE | DATE | DESCRIPTION |

| | |
|-----------------|---------------|
| PROJECT MANAGER | A. MEILLEUR |
| DESIGNED | I. RINCON |
| DRAWN | P. McCLINTOCK |
| CHECKED | E. SWANSON |
| PROJECT NUMBER | 171097 |

ELECTRONIC SEAL AND
SIGNATURE HAS BEEN
REMOVED. THIS MEDIA
SHOULD NOT BE CONSIDERED
A CERTIFIED DOCUMENT

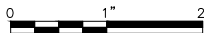

**ELECTRICAL
SITE PLAN**

| | |
|----------|-------------|
| FILENAME | 000E-01.dwg |
| SCALE | AS NOTED |

| |
|----------------|
| SHEET |
| 000E-01 |